
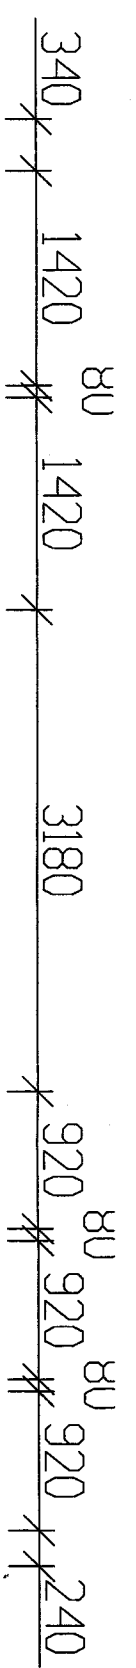
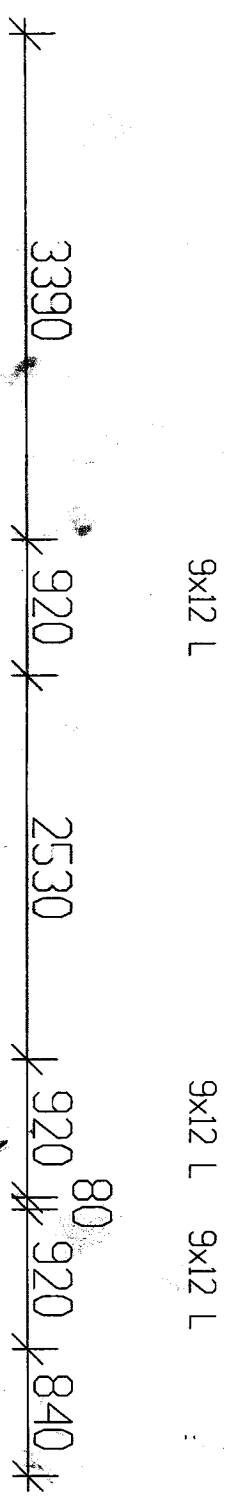
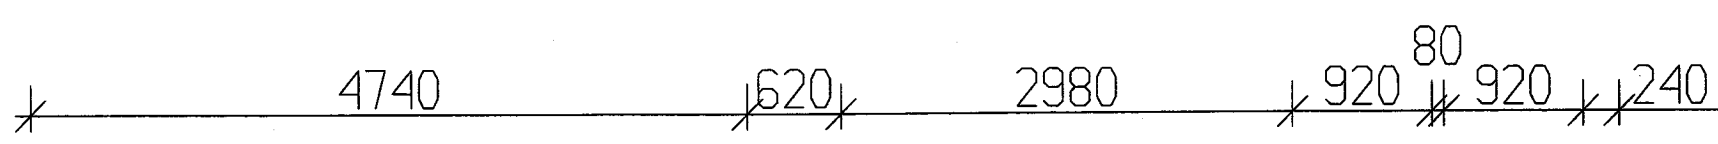
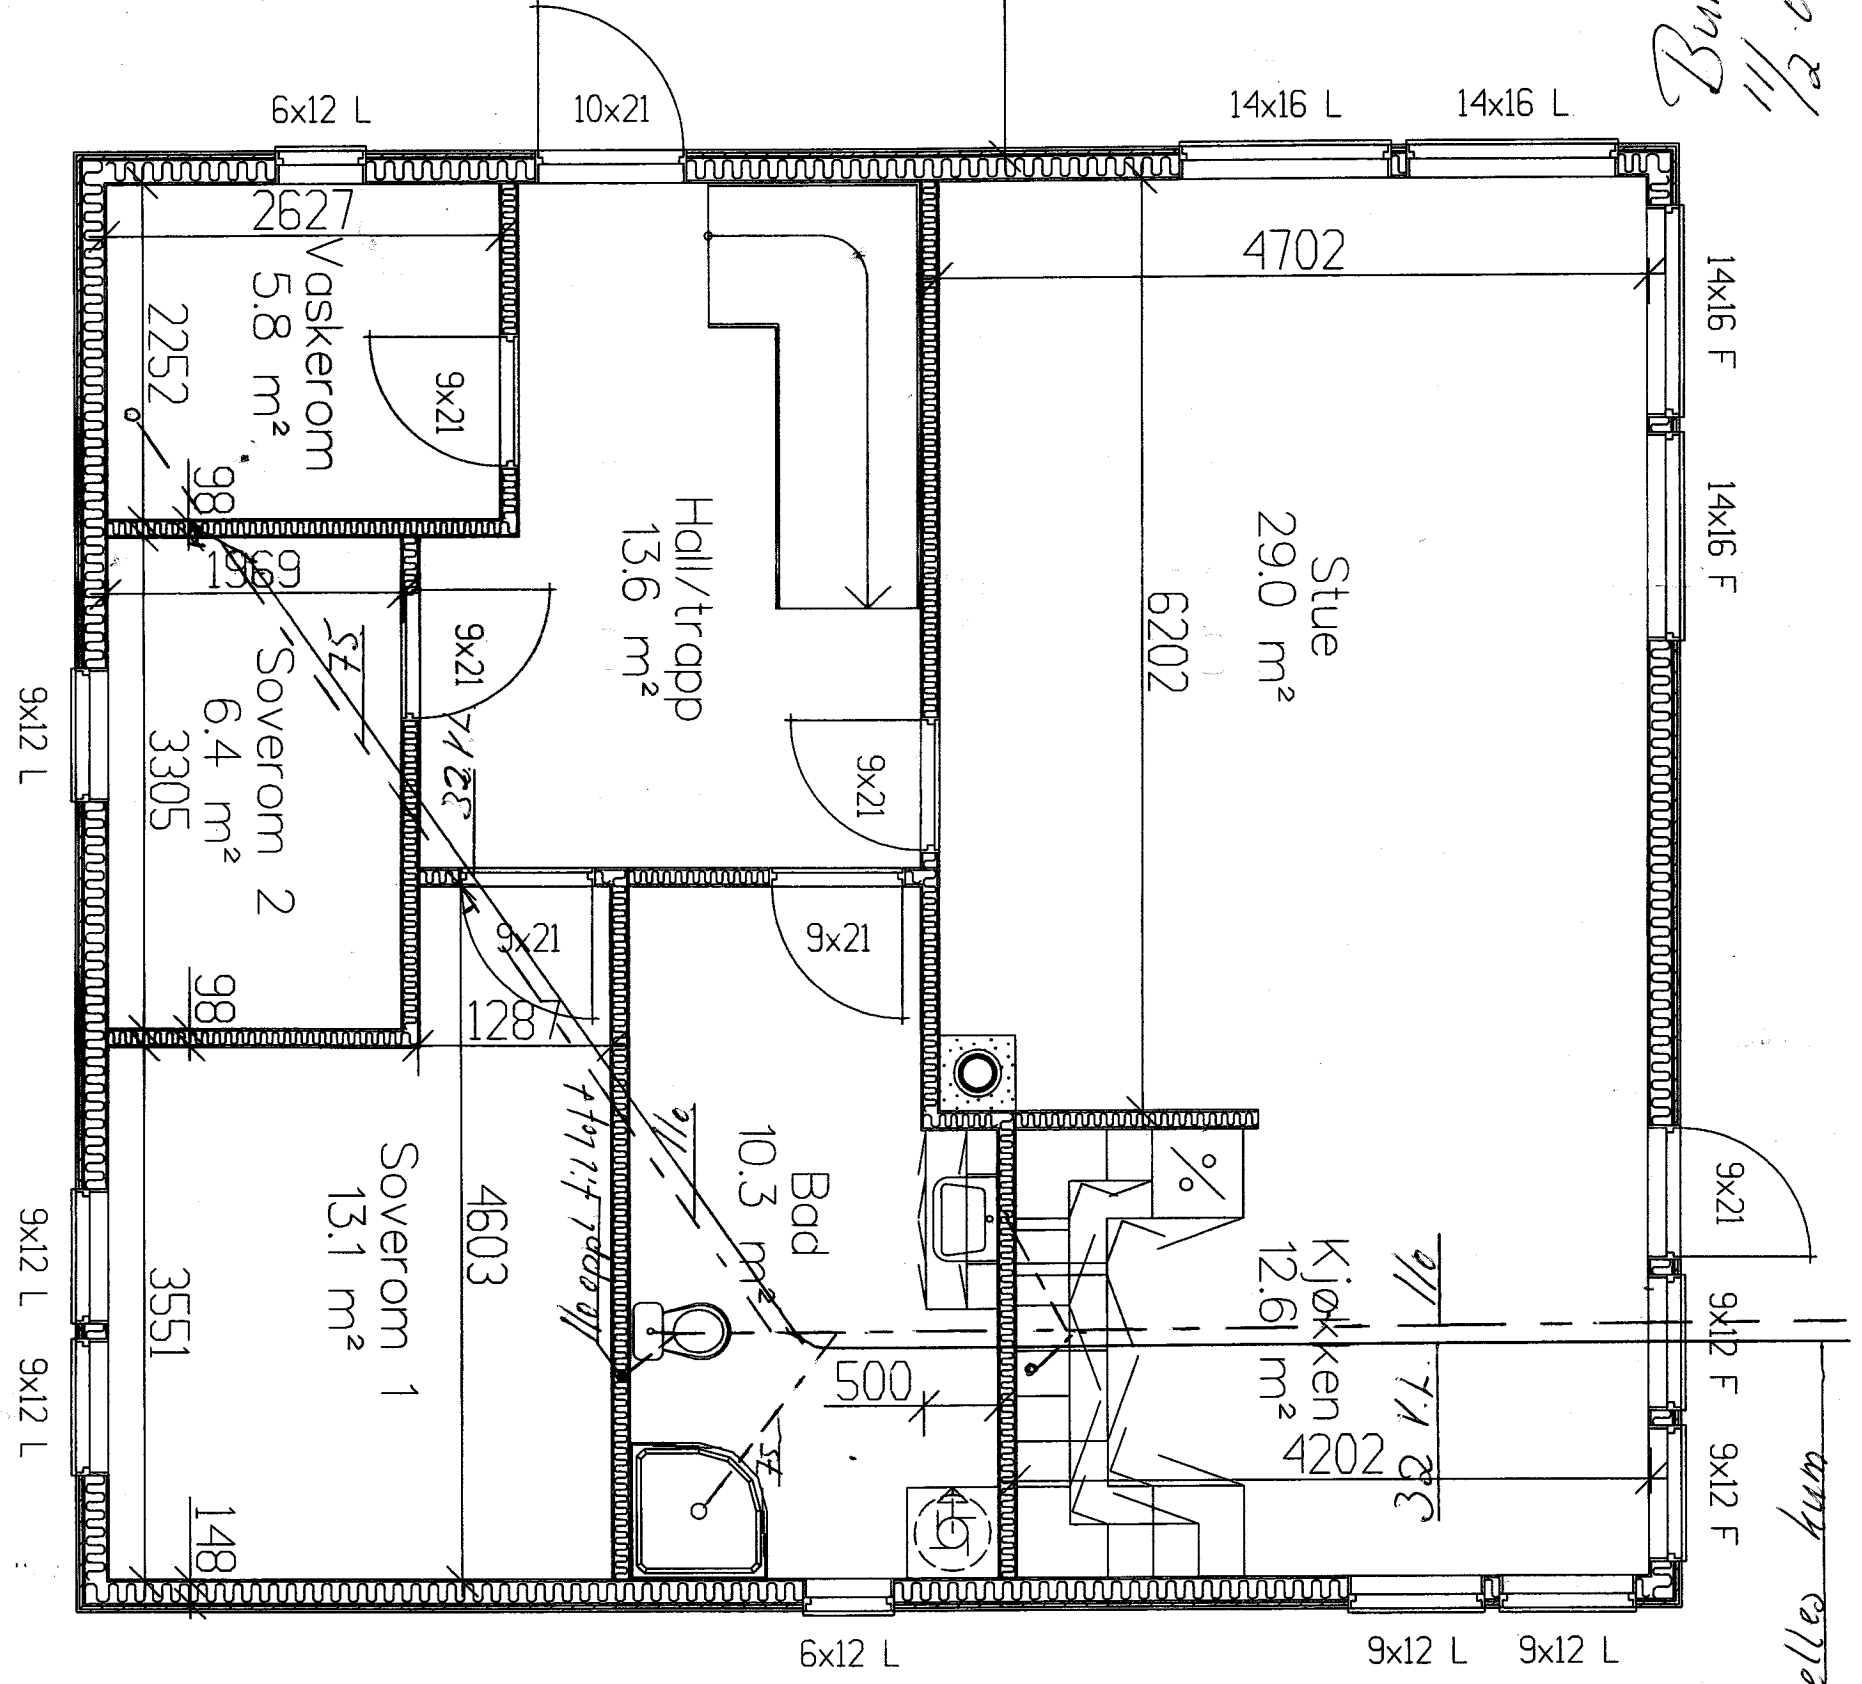
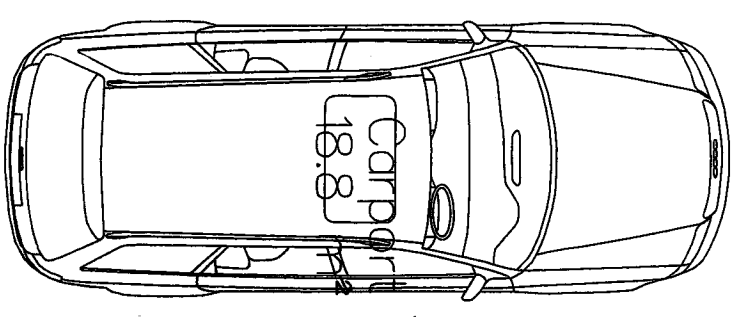


Huss Nr. 2

gammel pumpe 60 l/min
2 m smy rørbinding
Bunn


LINDAS KOMMUNE
Klassering 137/172
17. 02. 2009
2001/317
Saksh. 161
Tilgangskode 3337/2009

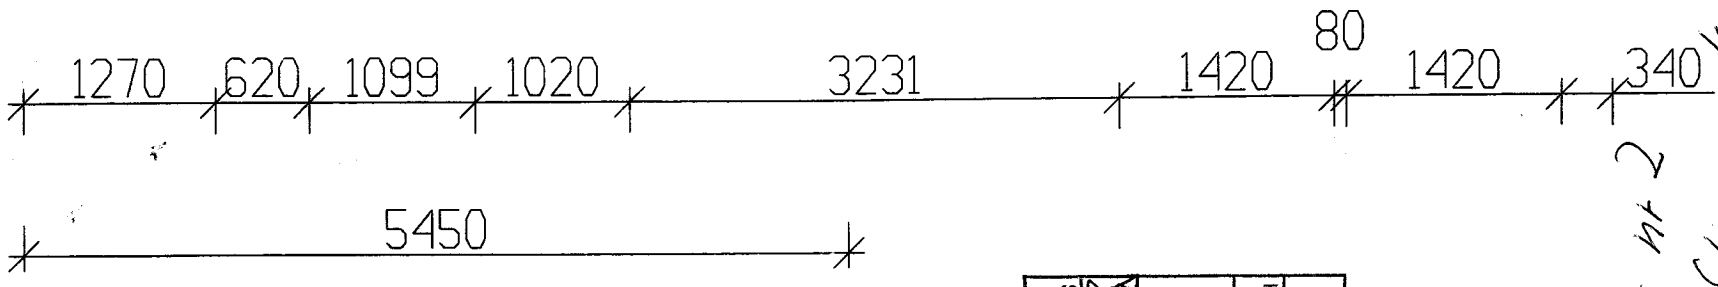

små rørf i vaskeroms bunn


LINDAS KOMMUNE SYDN11	
Klassering	
Ark. saksnr.	6002. 20. 7. 1
Løp.nr.	
Tilgangskode	
Saksh.	

LINDAS KOMMUNE	
Klassering 137/172	
17. 02. 2009	
Ark. saksnr.	2009/1827
Løp.nr.	5337/2009
Tilgangskode	
Saksh.	165

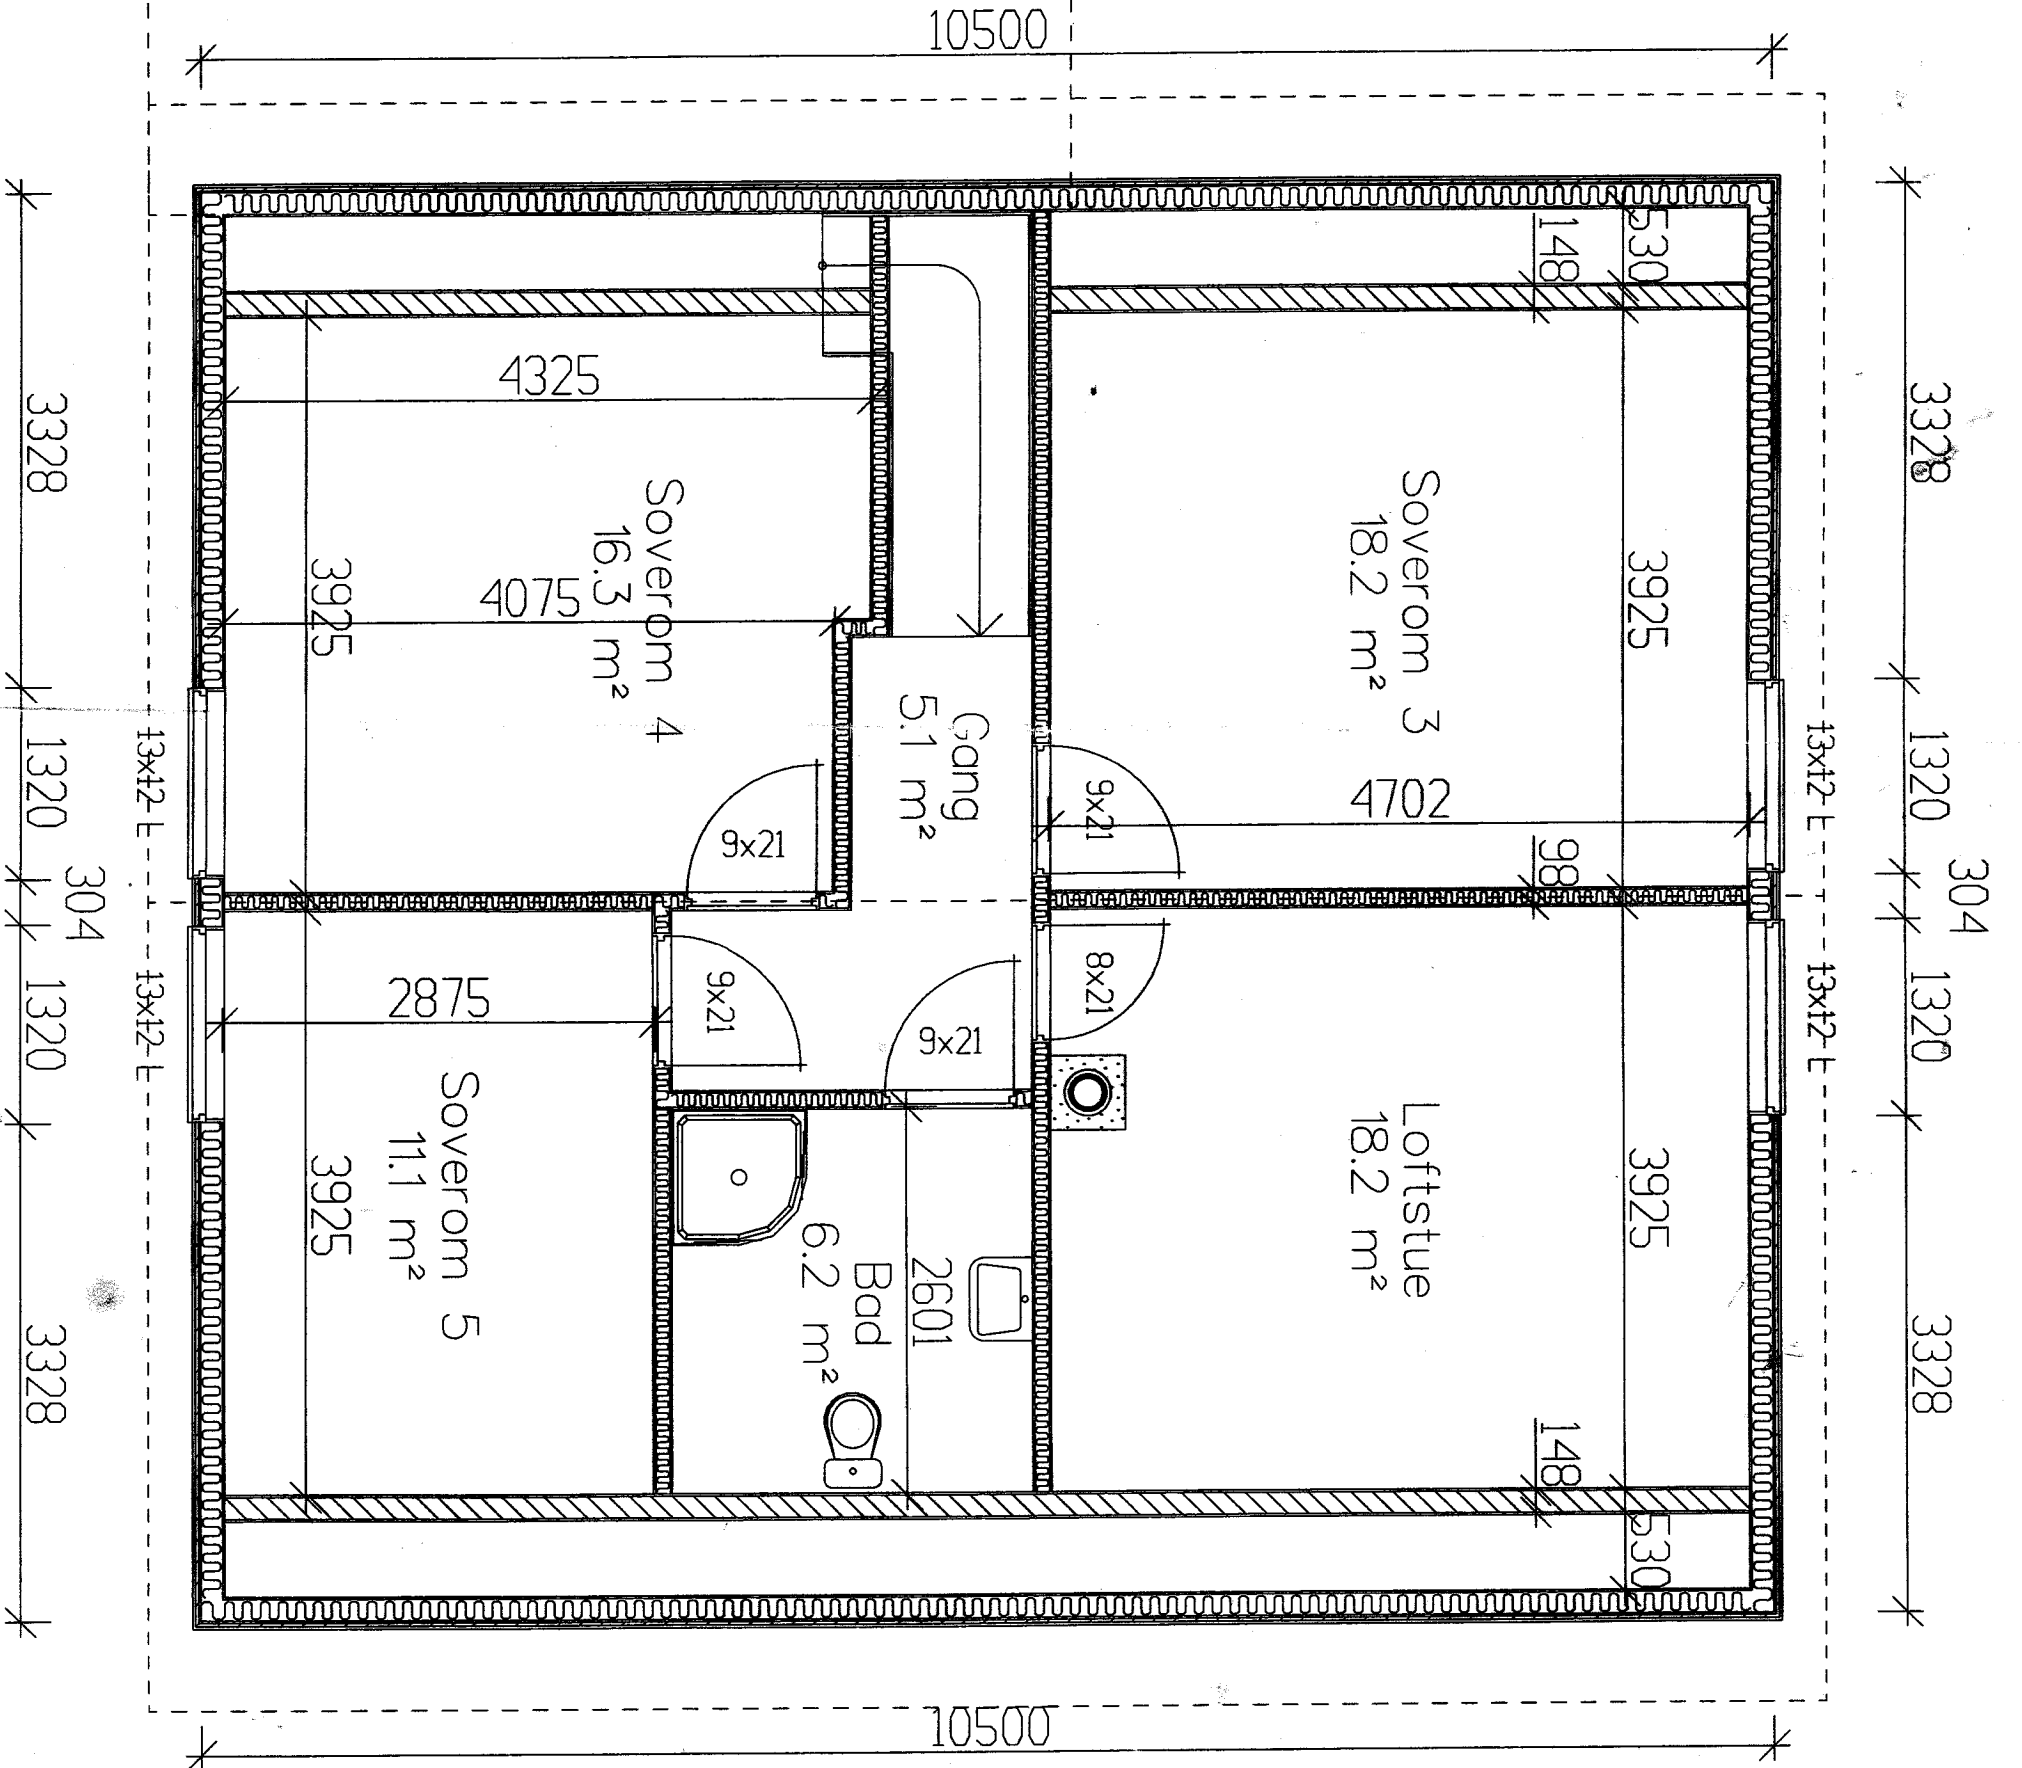

234/1827A

8 7 6 5 4 3 2 1

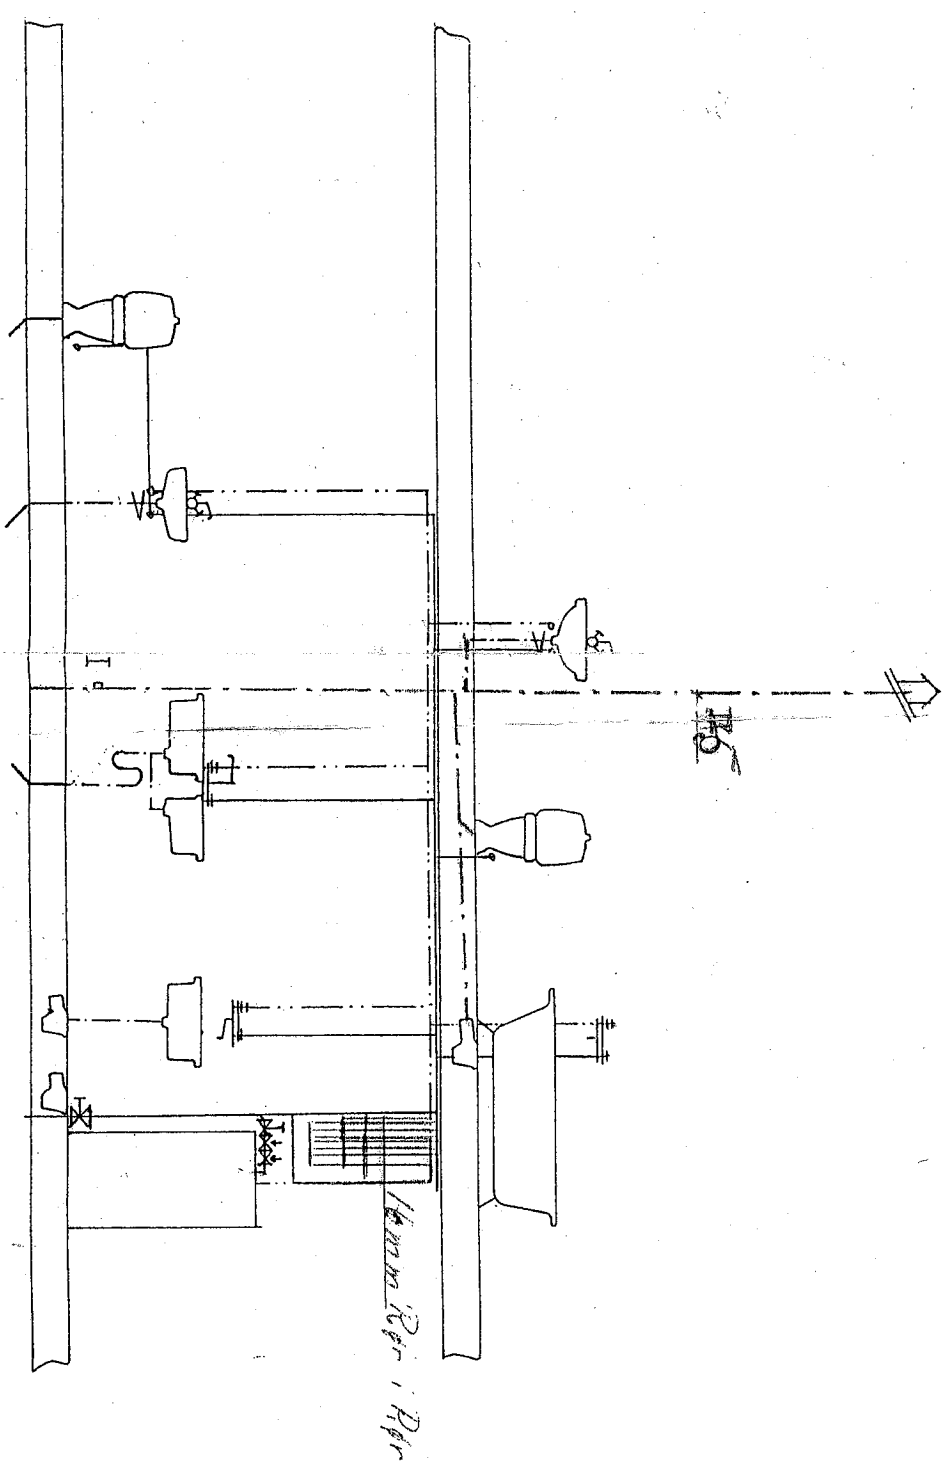

14 mm Rør i Rør

LINDÅS KOMMUNE	
Klassering	37/172
17. 02. 2009	
Saksnr	200/37
Tilgangsvnr	3387/2009
Saksnr	161

1/2-09	1.50	Oppl. styema
--------	------	--------------

Enebolig Gnr 137 Bar 172 Hus nr. 2	Sigmund Strainsto
---------------------------------------	-------------------

Havnshing
Referencing