




## Medaas Oppmåling

**Tiltak: Garasje gbnr 92/32.**

**Isdalstø 18.10.19**

**Innmålte bygg.**

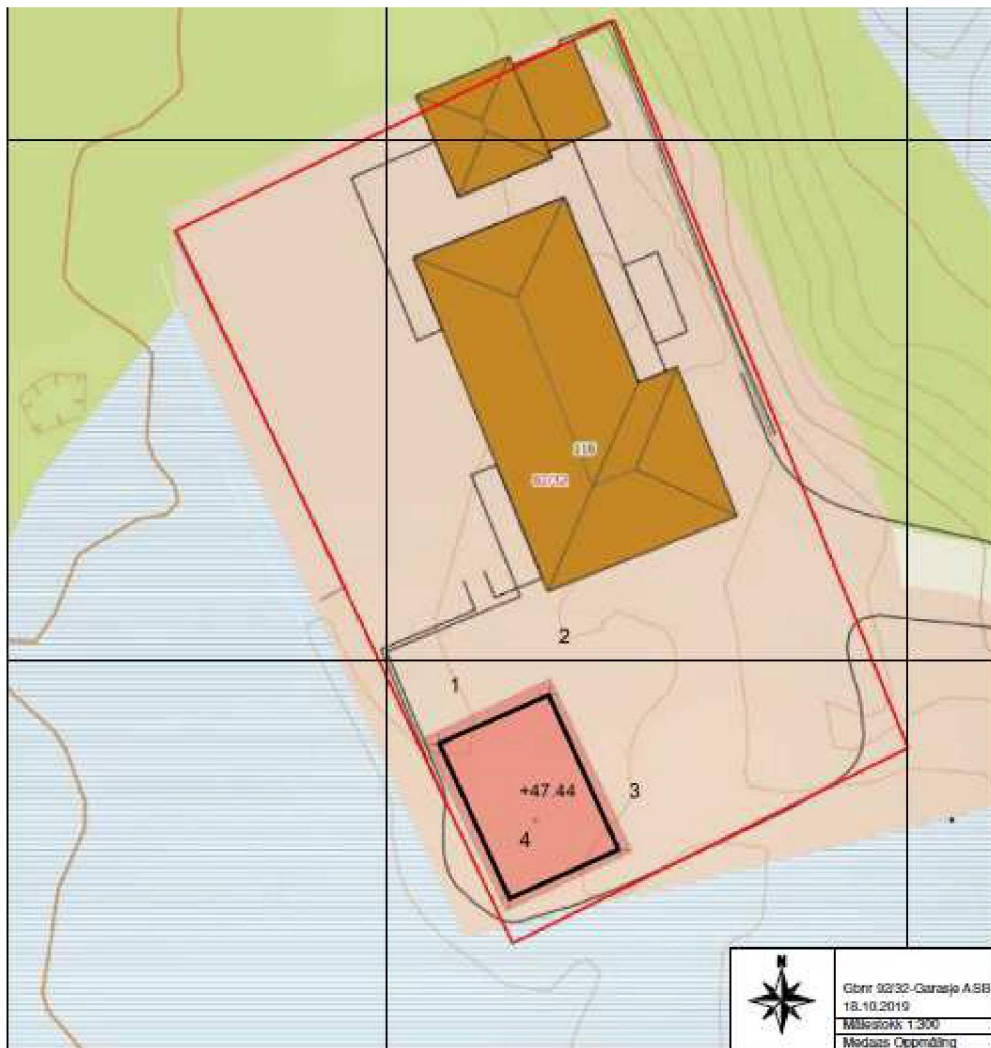

1	5006	6734155.167	293103.049	47.440
2	5006	6734157.972	293109.354	47.440
3	5006	6734149.042	293113.383	47.440
4	5006	6734146.205	293107.093	47.440

## Medaas Oppmåling

Litlevika 47  
5914 Isdalstø  
kjameda@online.no

Tlf: 56352227 – 48287186  
Org.nr.: 986 448 551 MVA  
Bank: 3632 10 19190