


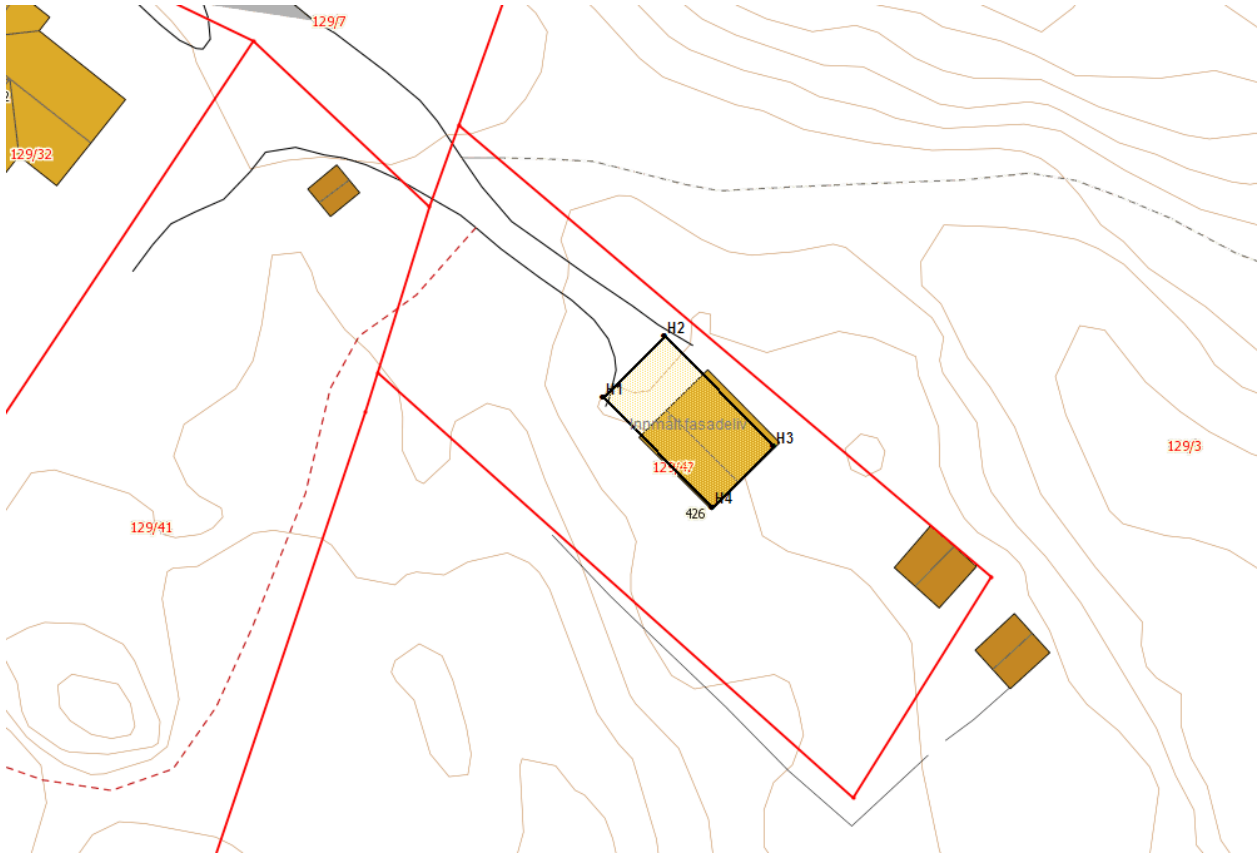

Lindås, gnr 129 bnr 47,
Data på innmålt fasadeliv

30.10.2014



PunktID	N-koord.	Ø-koord.
H1	6727402,01	291700,25
H2	6727405,52	291703,80
H3	6727399,20	291710,07
H4	6727395,70	291706,55