


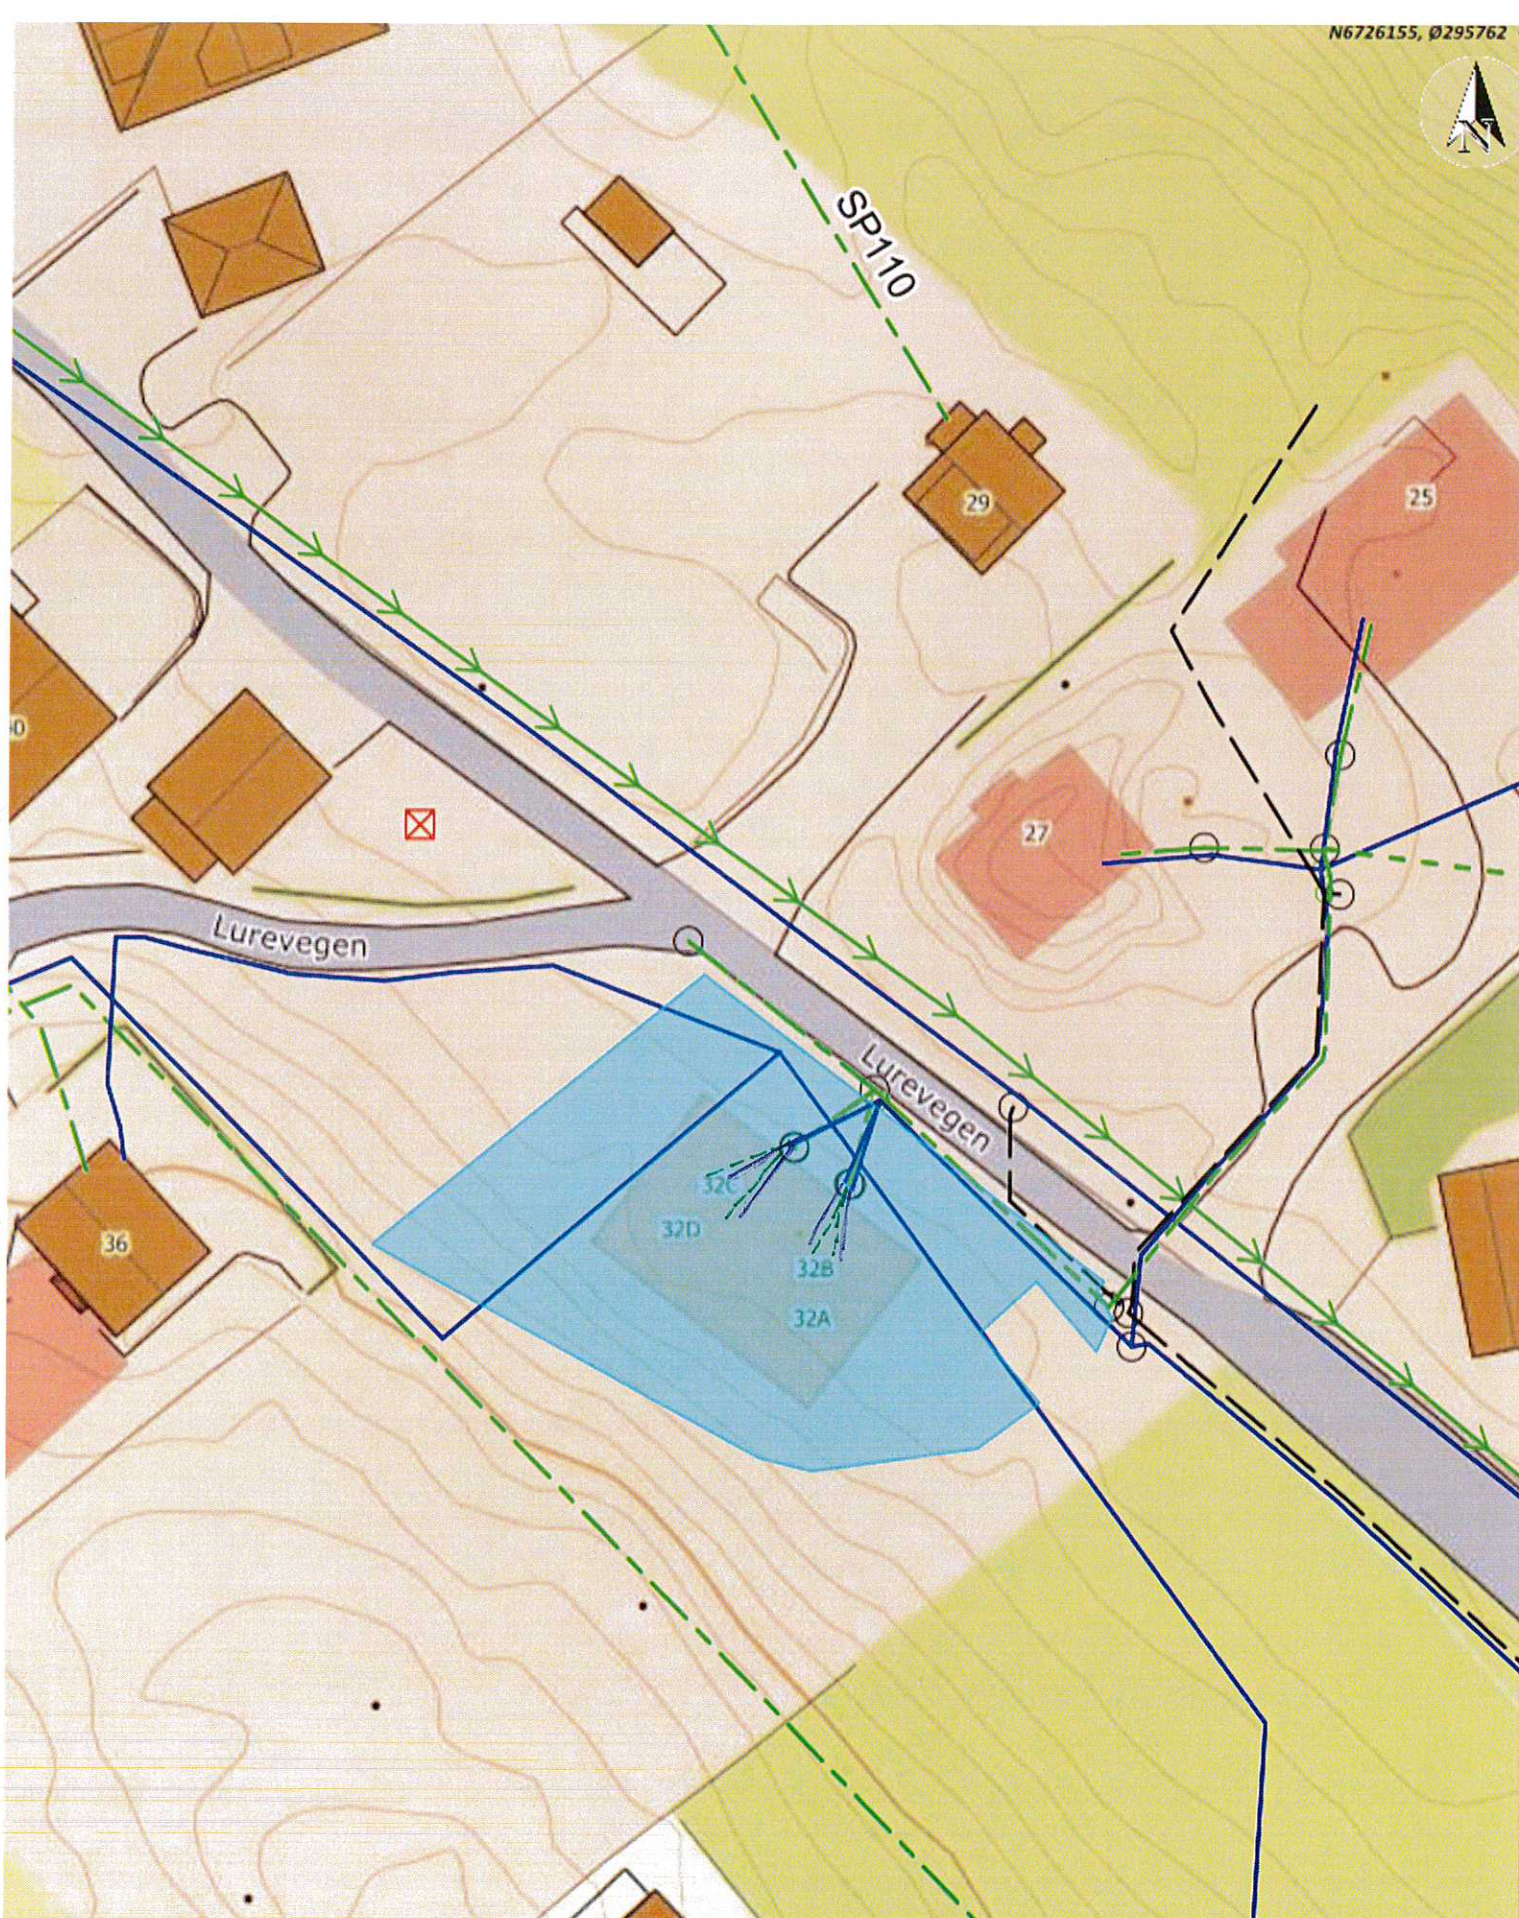

Situasjonskart - 172/201

Dato: 19-11-2019

NHdigi.no

Målestokk: 1:500

15m

172/201

○ = 32 mm ulv. stoppetkan
● = 110 mm stakepunkt

