

14/2360




STATENS KARTVERK

# Se eiendom

11-March-2014

21/02 2014

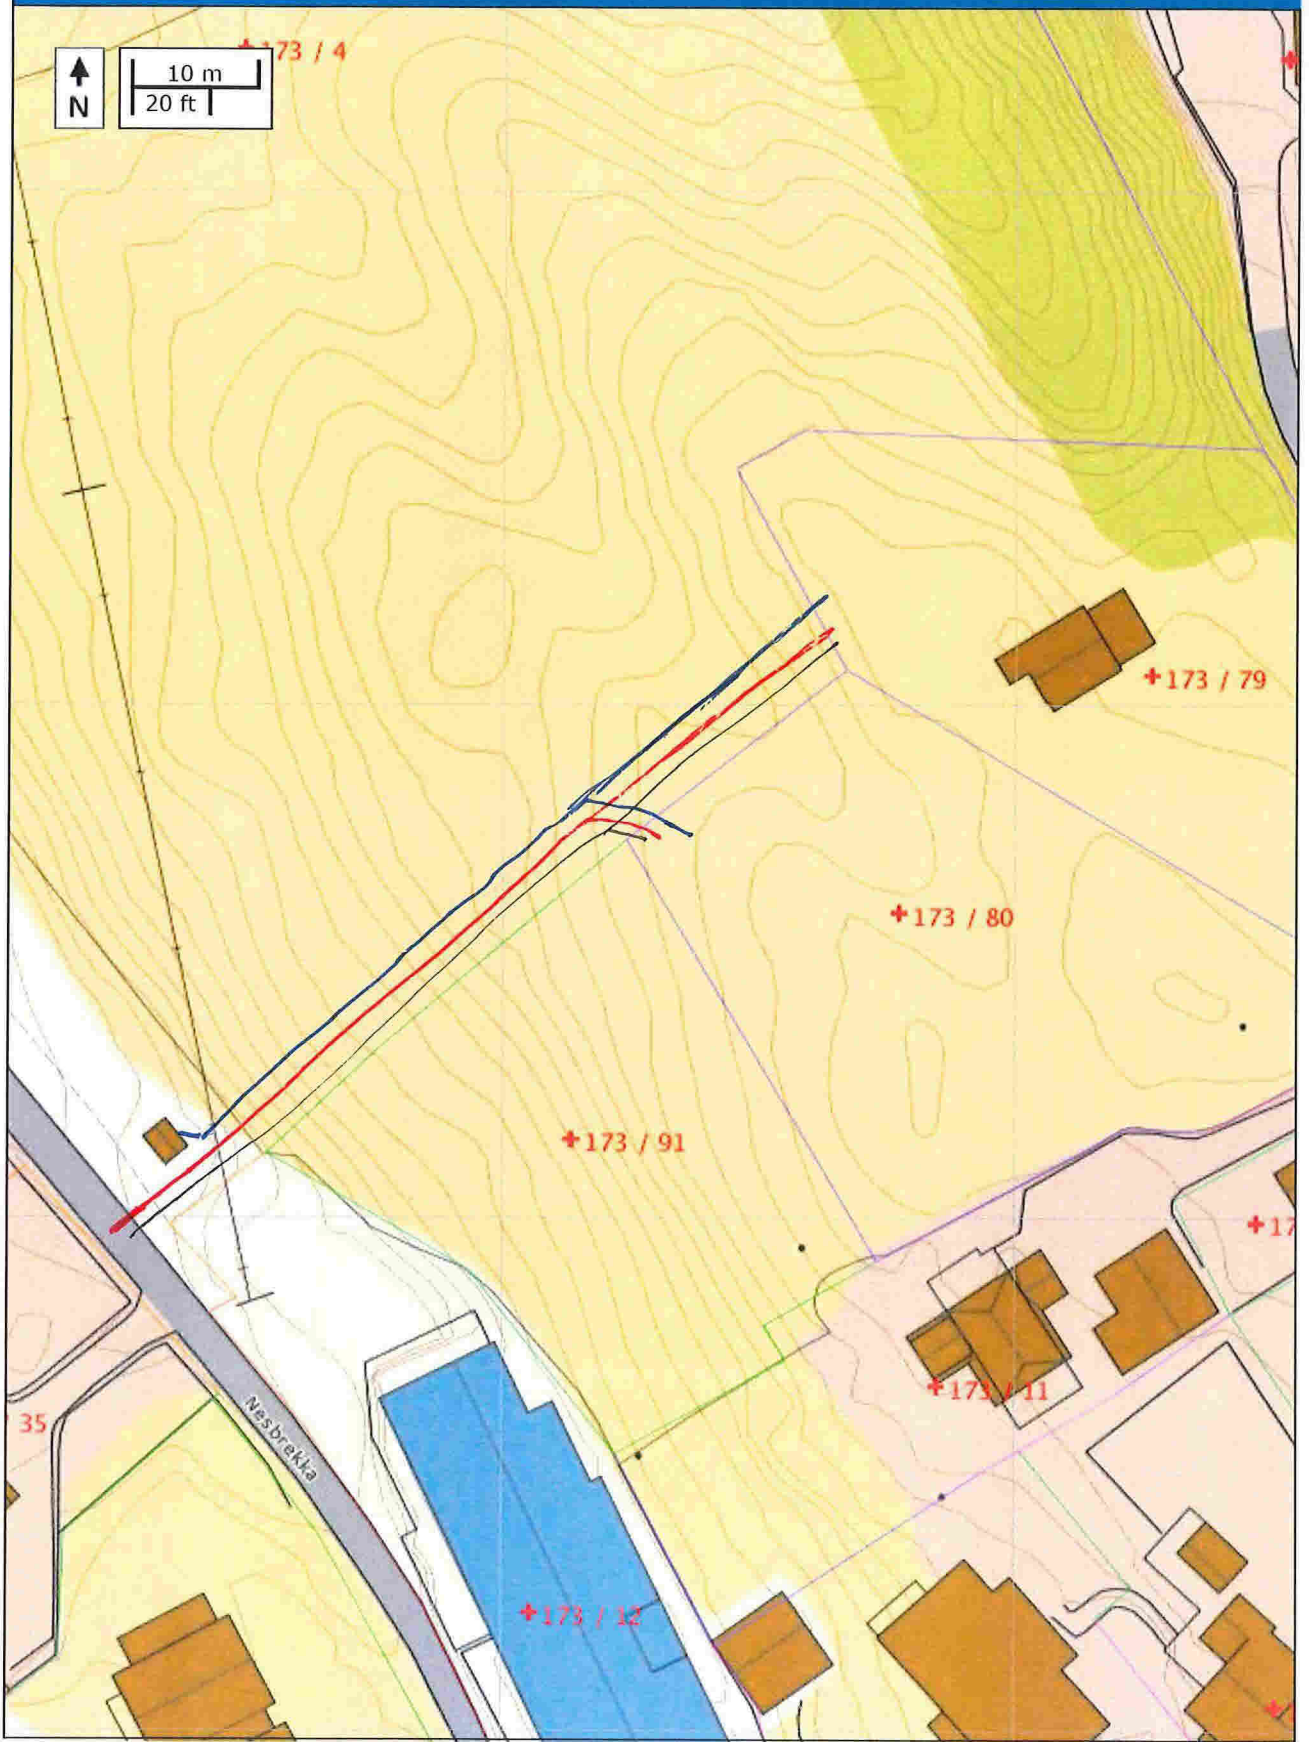

- VANN
- KLOAKK
- STRØM



STATENS KARTVERK

# Se eiendom

09/12 2013

