

---

**Fra:** Anne Lise Molvik  
**Sendt:** tirsdag 17. desember 2019 14:51  
**Til:** 'Arve Fyllingsnes'  
**Emne:** SV: 19/37703 Orientering om vedtak i Plan- og miljøutvalet - gbnr 214/4 Fyllingsnes

Hei,

Den stipla grå linja viser funksjonell strandsone og er fastsett med bakgrunn i ei vurdering av kva areal som i realiteten har funksjon som strandsone.

Med helsing

**Anne Lise Molvik** | Rådgjevar på byggjesak

**E-post:** [anne.lise.molvik@lindas.kommune.no](mailto:anne.lise.molvik@lindas.kommune.no) | **Telefon:** +47 56 37 56 40  
**Kundesenter:** +47 56 37 50 00 | **Heimeside:** [www.lindas.kommune.no](http://www.lindas.kommune.no)



---


**Fra:** Arve Fyllingsnes [<mailto:arfy@equinor.com>]  
**Sendt:** tirsdag 17. desember 2019 14:04  
**Til:** Anne Lise Molvik  
**Emne:** FW: 19/37703 Orientering om vedtak i Plan- og miljøutvalet - gbnr 214/4 Fyllingsnes

Hei 😊

Og takker for denne orienteringsmailen frå dykk.

Men eg lurar på kva den grå stripla linjen som markert i bilde nedenfor betyr ?

Mvh Arve Fyllingsnes

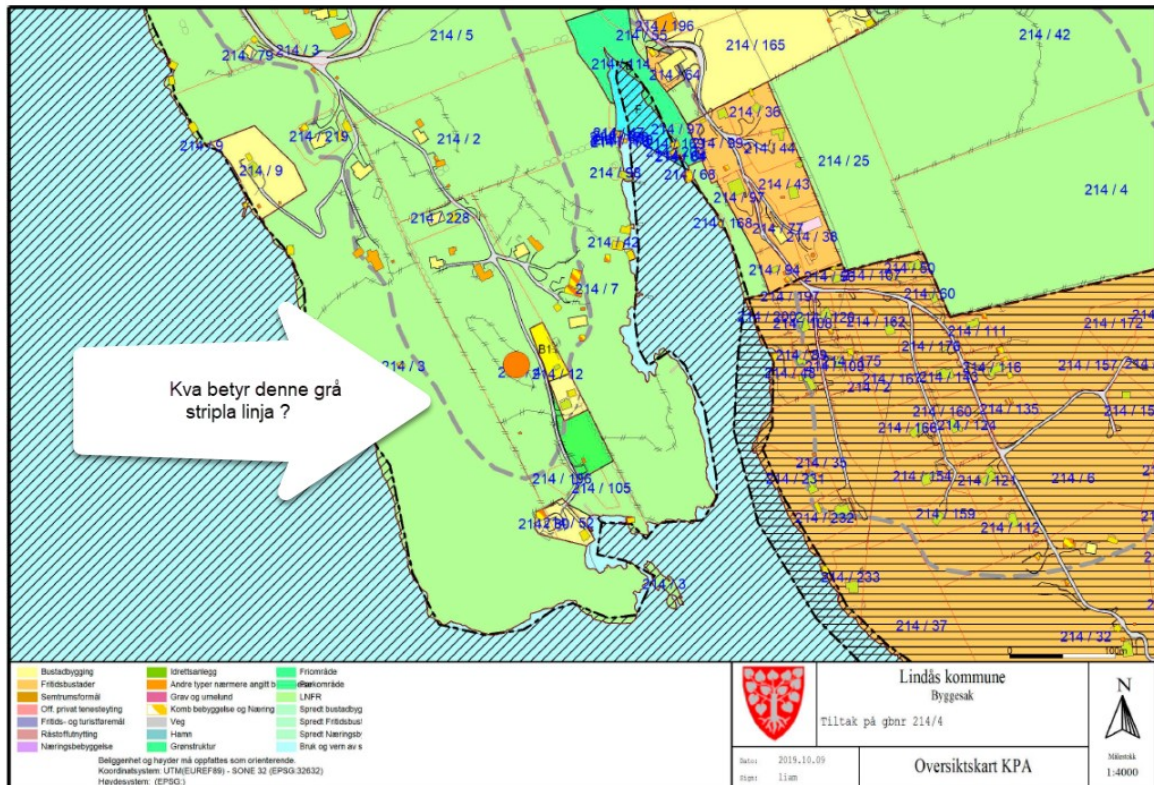

**From:** Anne Lise Molvik <[anne.lise.molvik@lindas.kommune.no](mailto:anne.lise.molvik@lindas.kommune.no)>

**Sent:** mandag 16. desember 2019 13:58

**Cc:** Arve Fyllingsnes <[arfy@equinor.com](mailto:arfy@equinor.com)>

**Subject:** 19/37703 Orientering om vedtak i Plan- og miljøutvalet - gbnr 214/4 Fyllingsnes

Sjå vedlegg

The information contained in this message may be CONFIDENTIAL and is intended for the addressee only. Any unauthorized use, dissemination of the information or copying of this message is prohibited. If you are not the addressee, please notify the sender immediately by return e-mail and delete this message.

Thank you