


137/156-260

10 JULI 2009

02/2101 12/21/17
LSPH
JEFRS7E
MRL 1:50

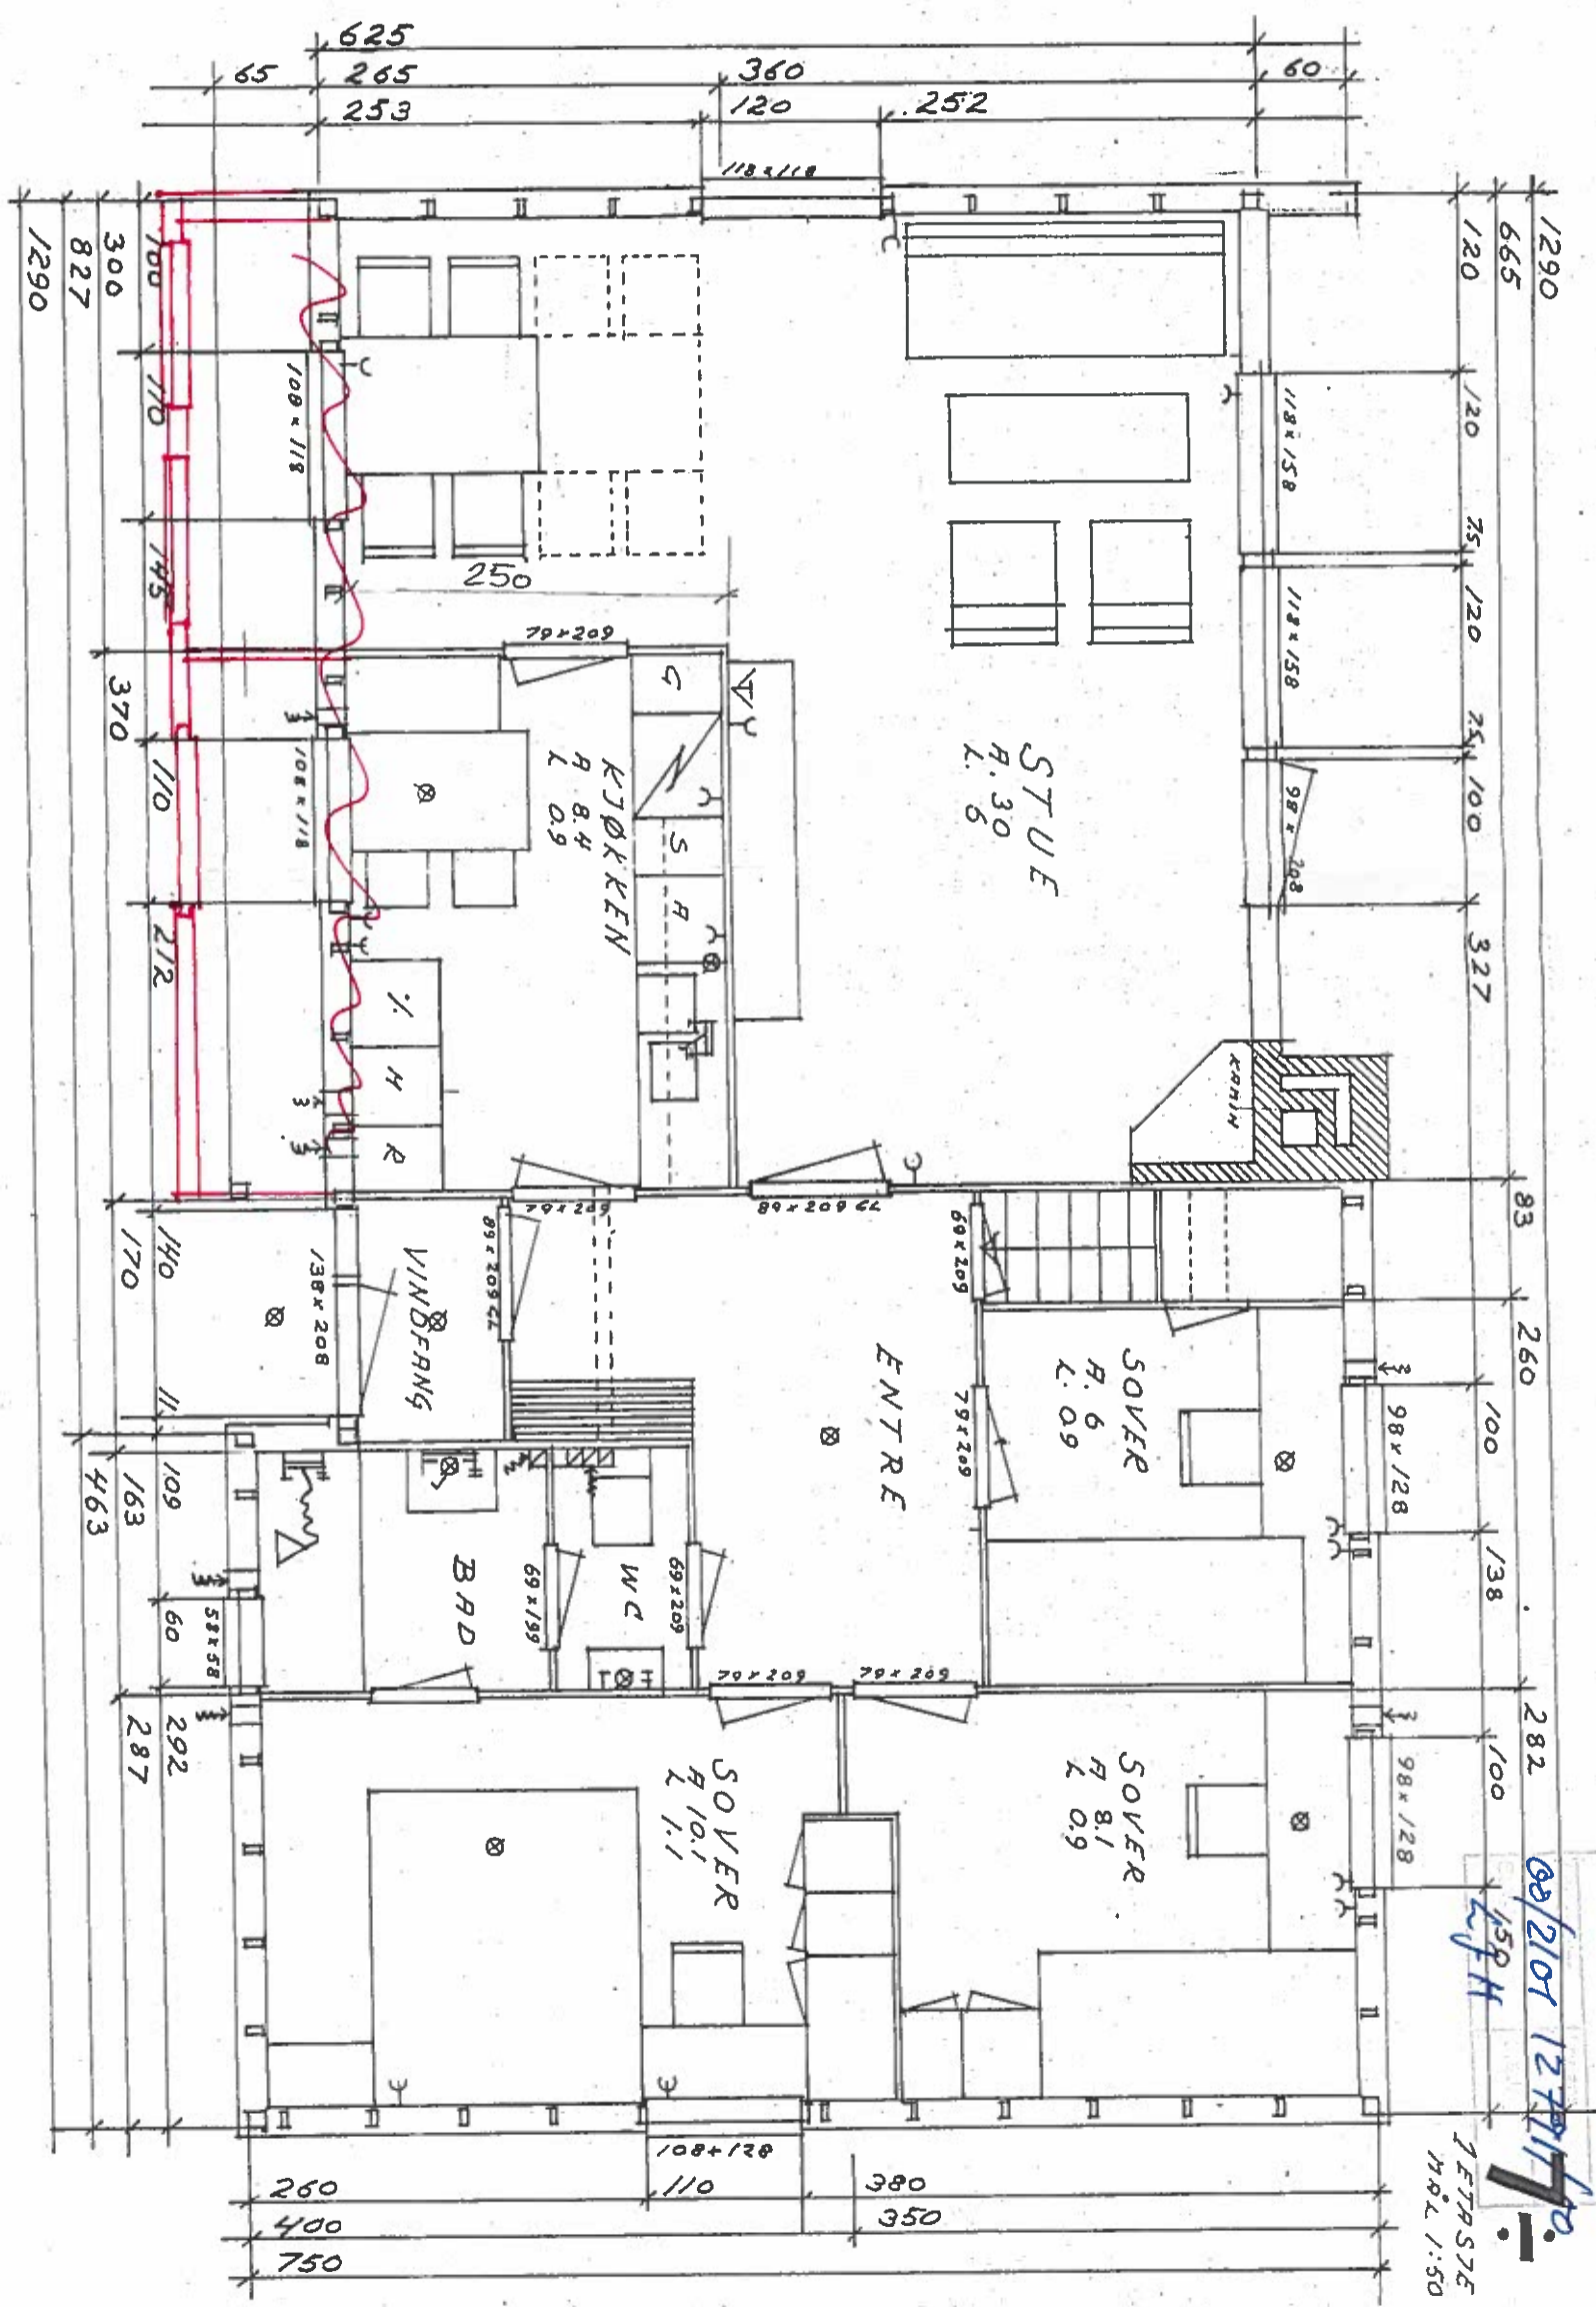


137/156


Blaug

137/158-2600
12 JUN 1980
464 / 37

137/158-2600
12 JUN 1980
09/2101 12.729/100
L.J.H.

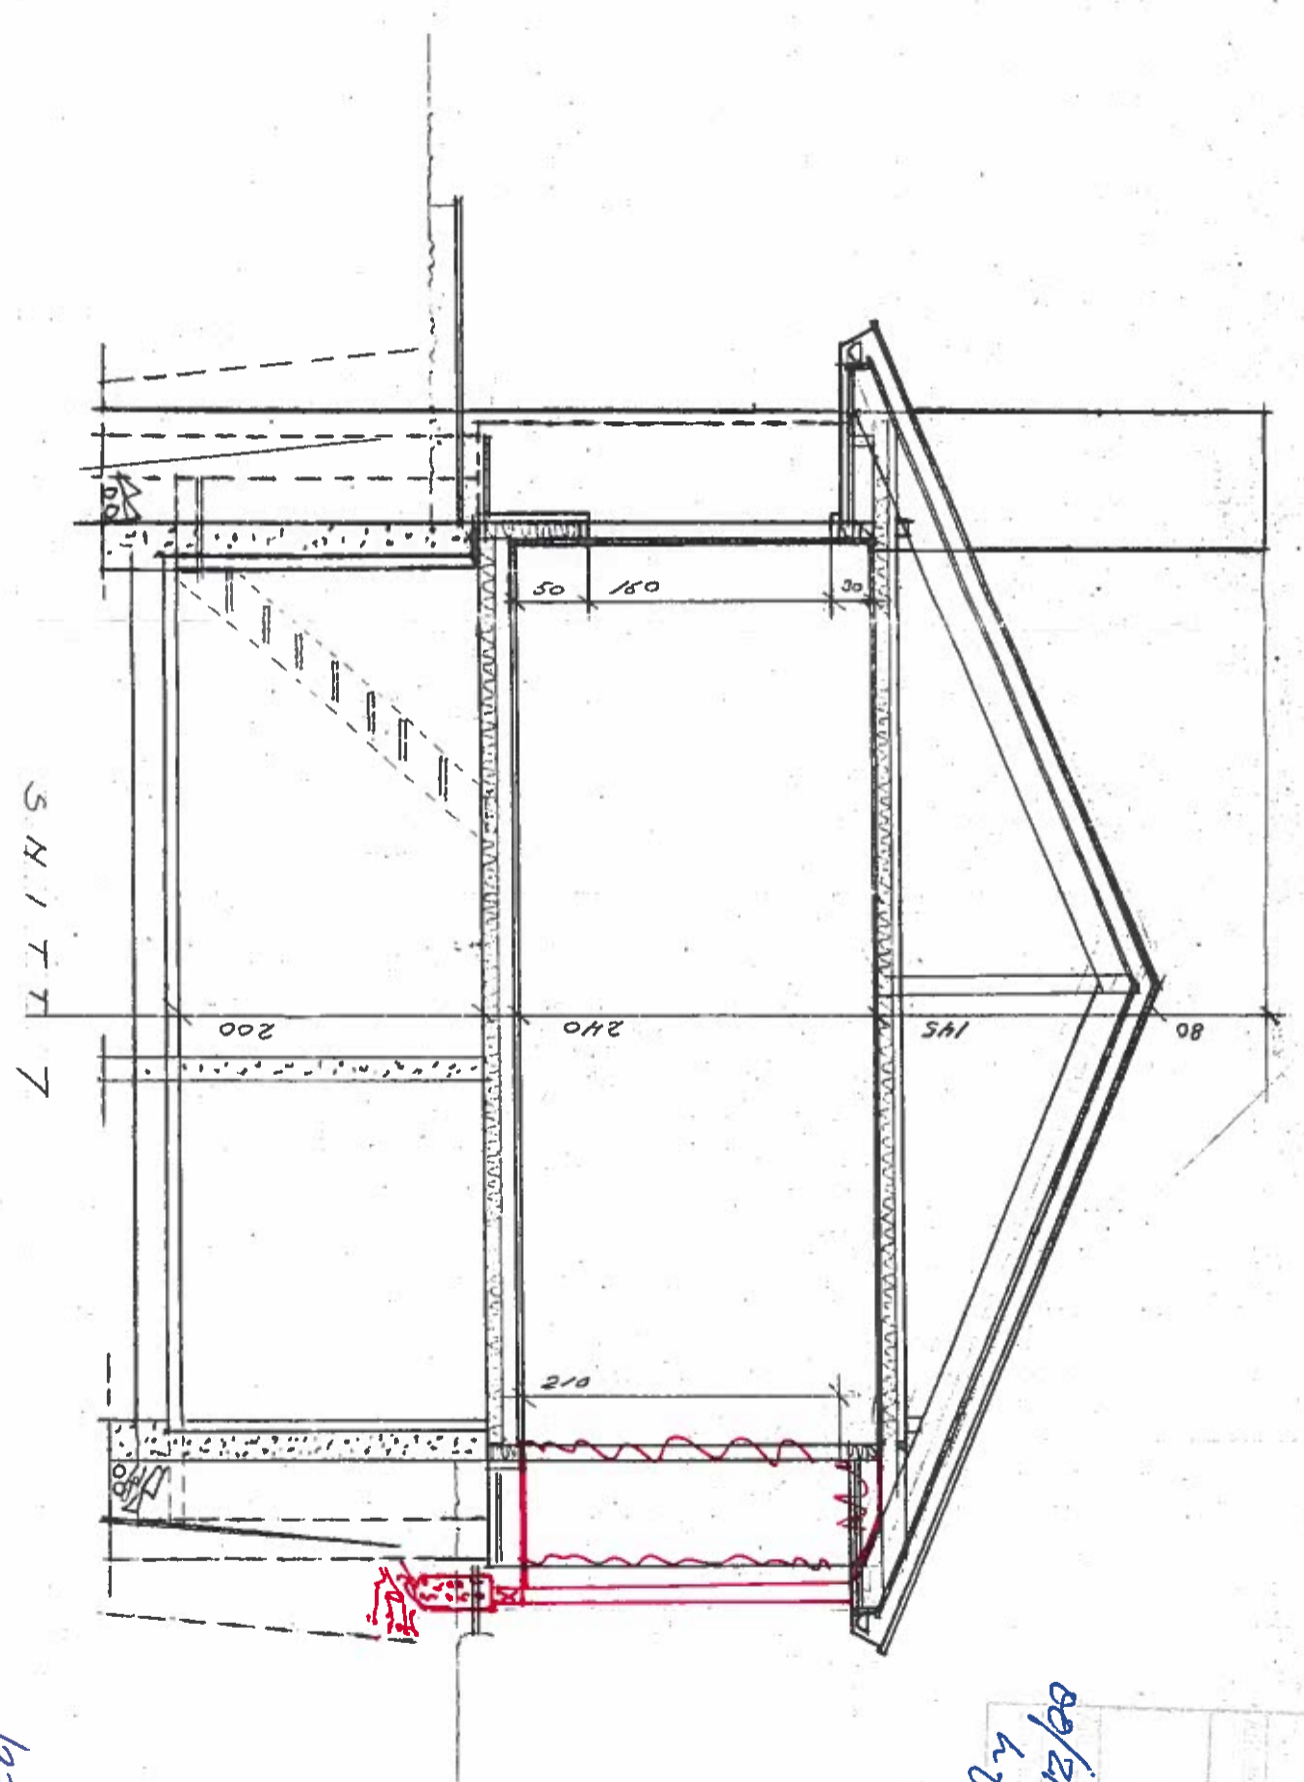

137/158
Shimberg

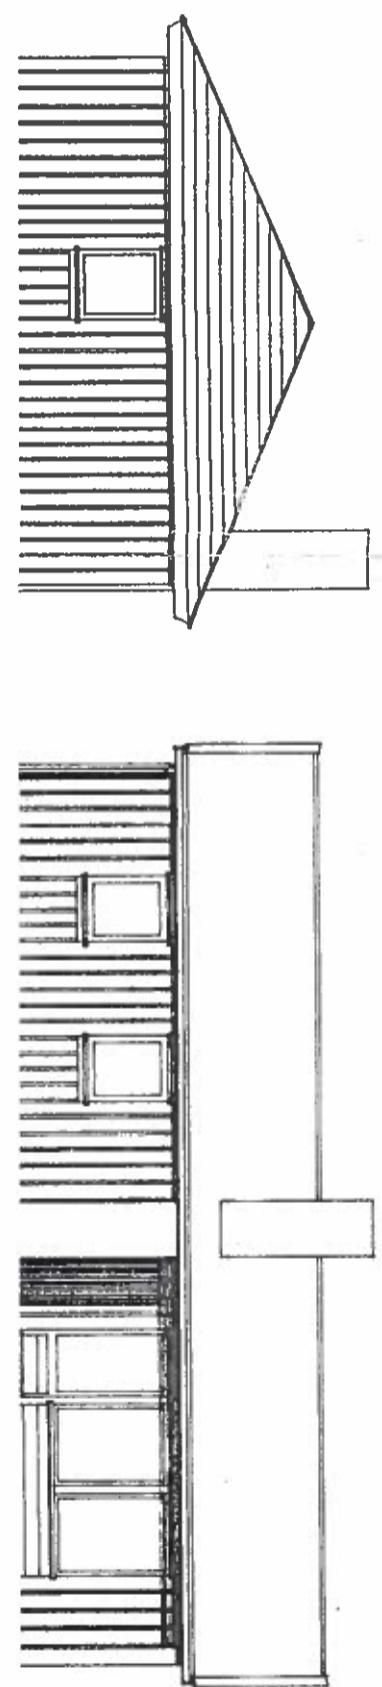

41