


137/156-660

10. JULI 2009

02/2101 127917/0

LPH

ETASJE  
MÅL 1:50

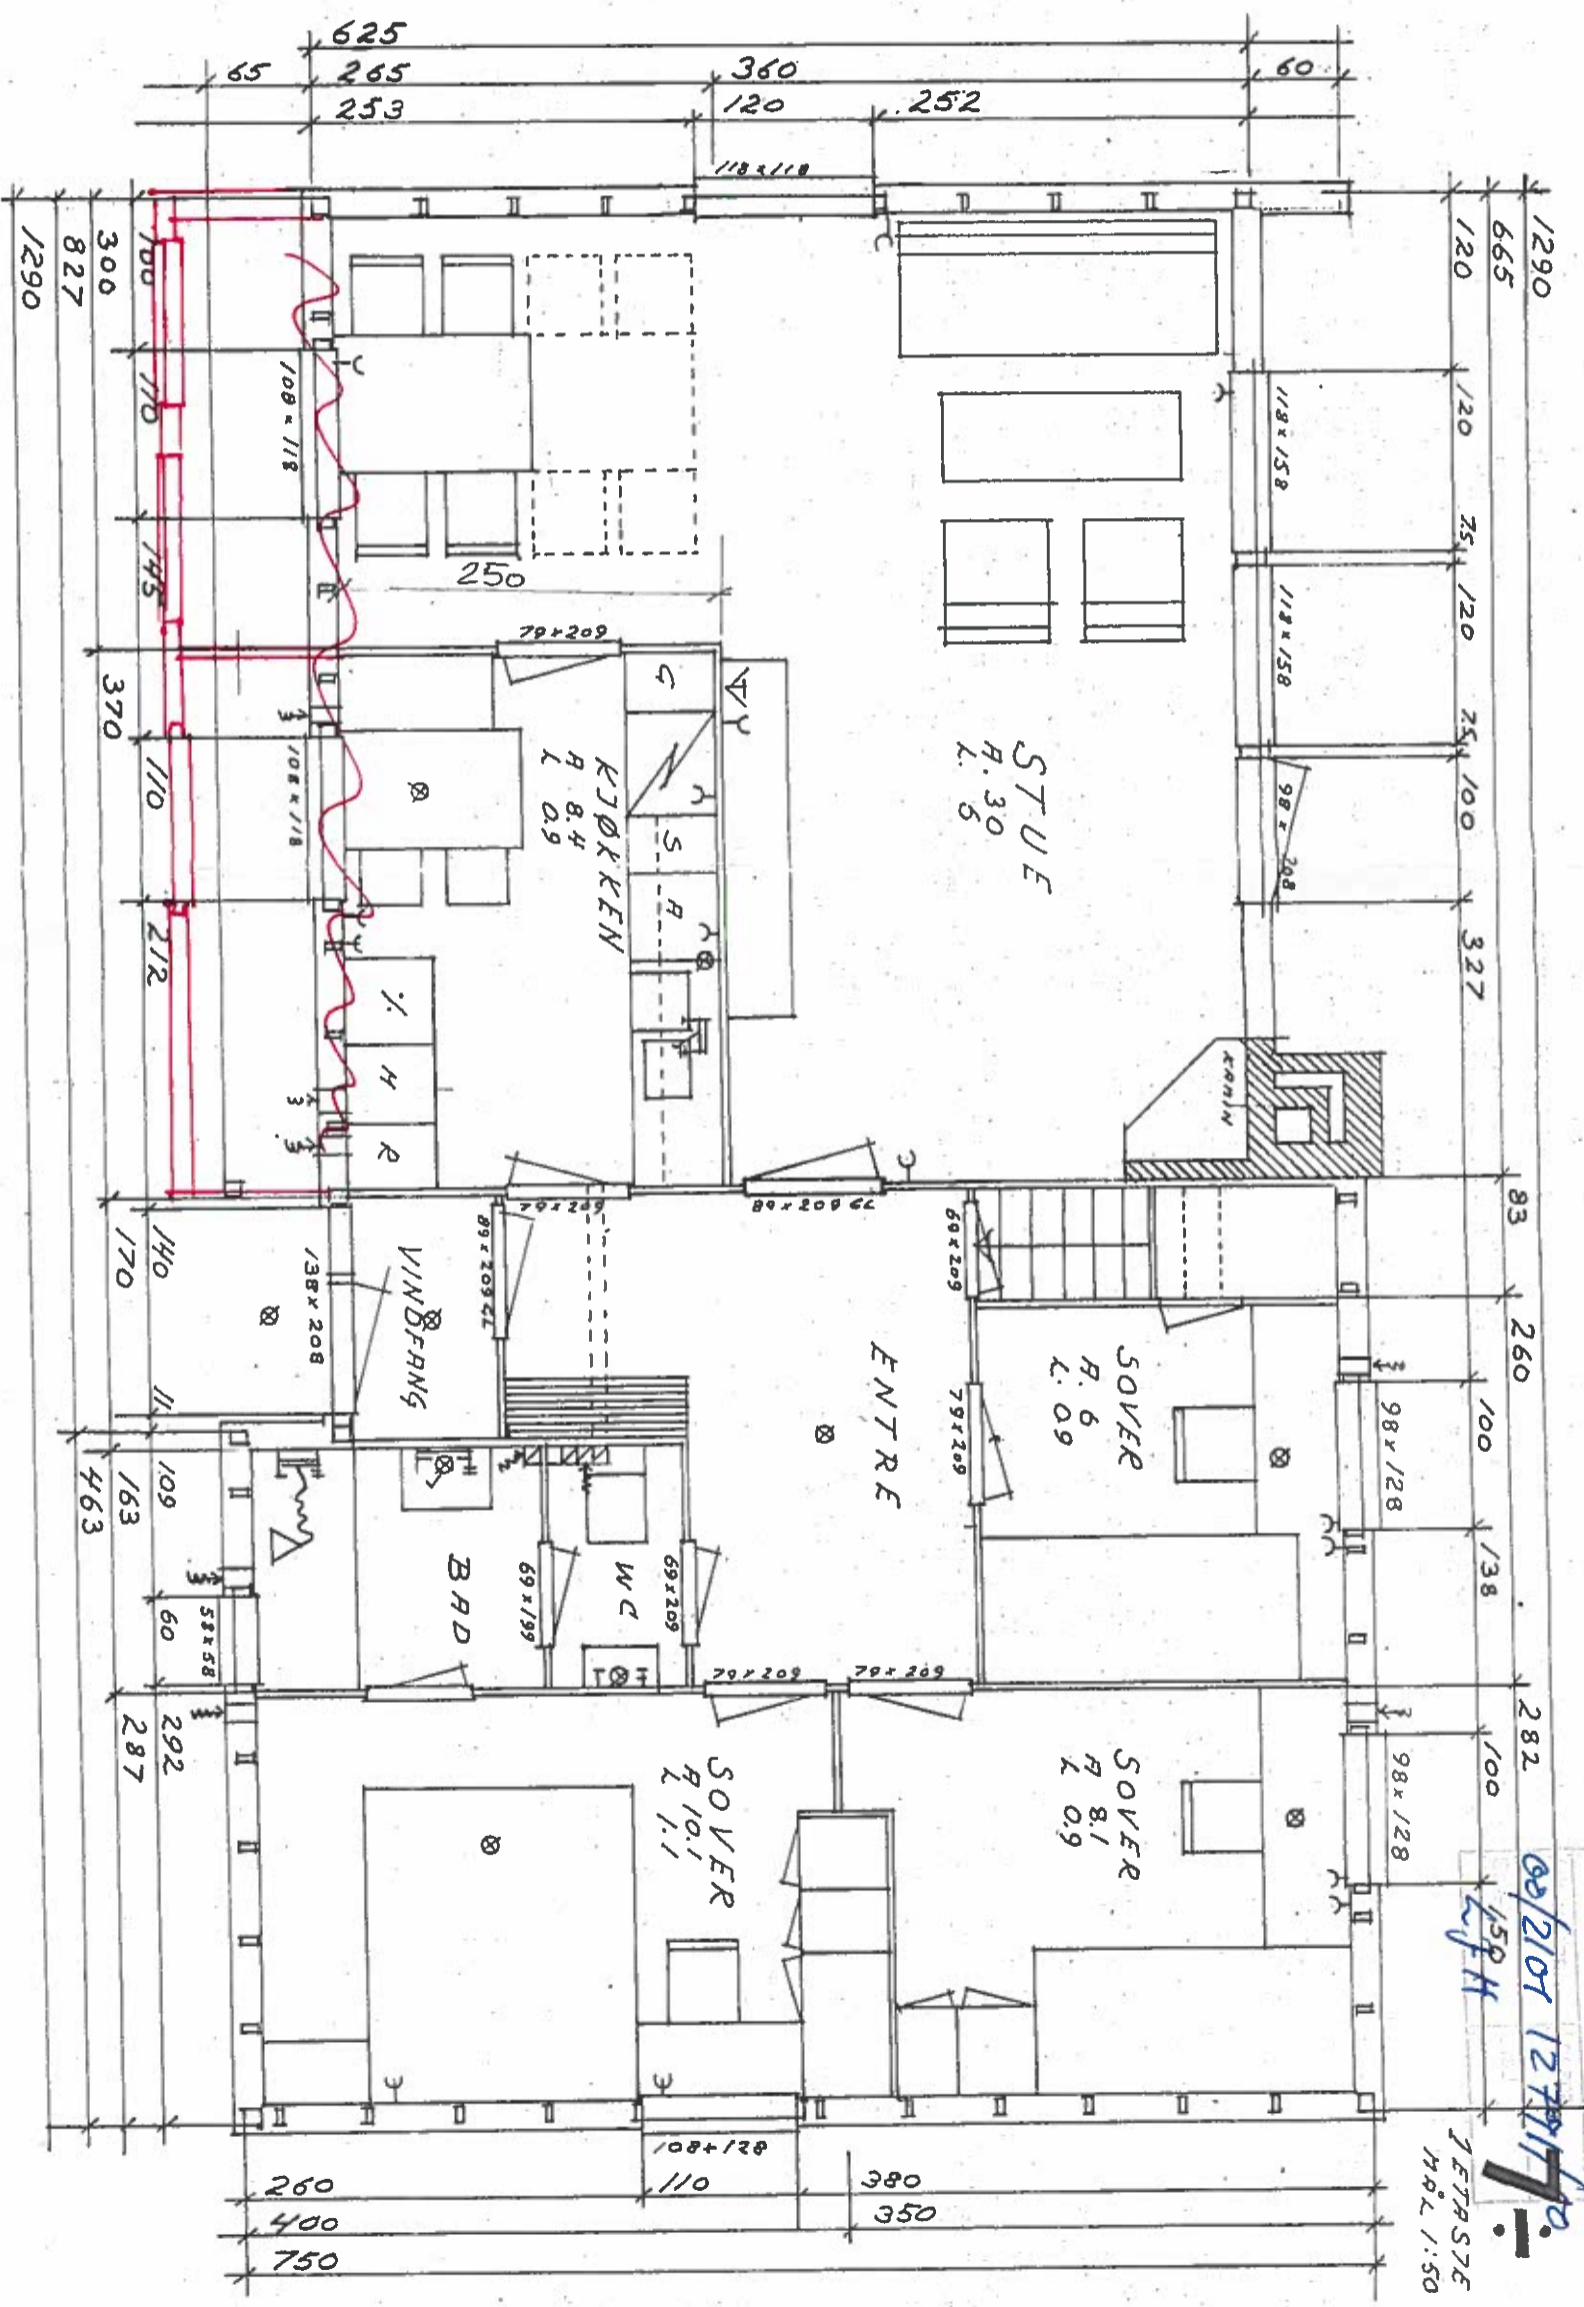

PLAN 1. ETASJE

187/156


Blaumberg


15867



464

137/158-260	10 JUN 1979
08/2101	12.29/80
L.J.H.	

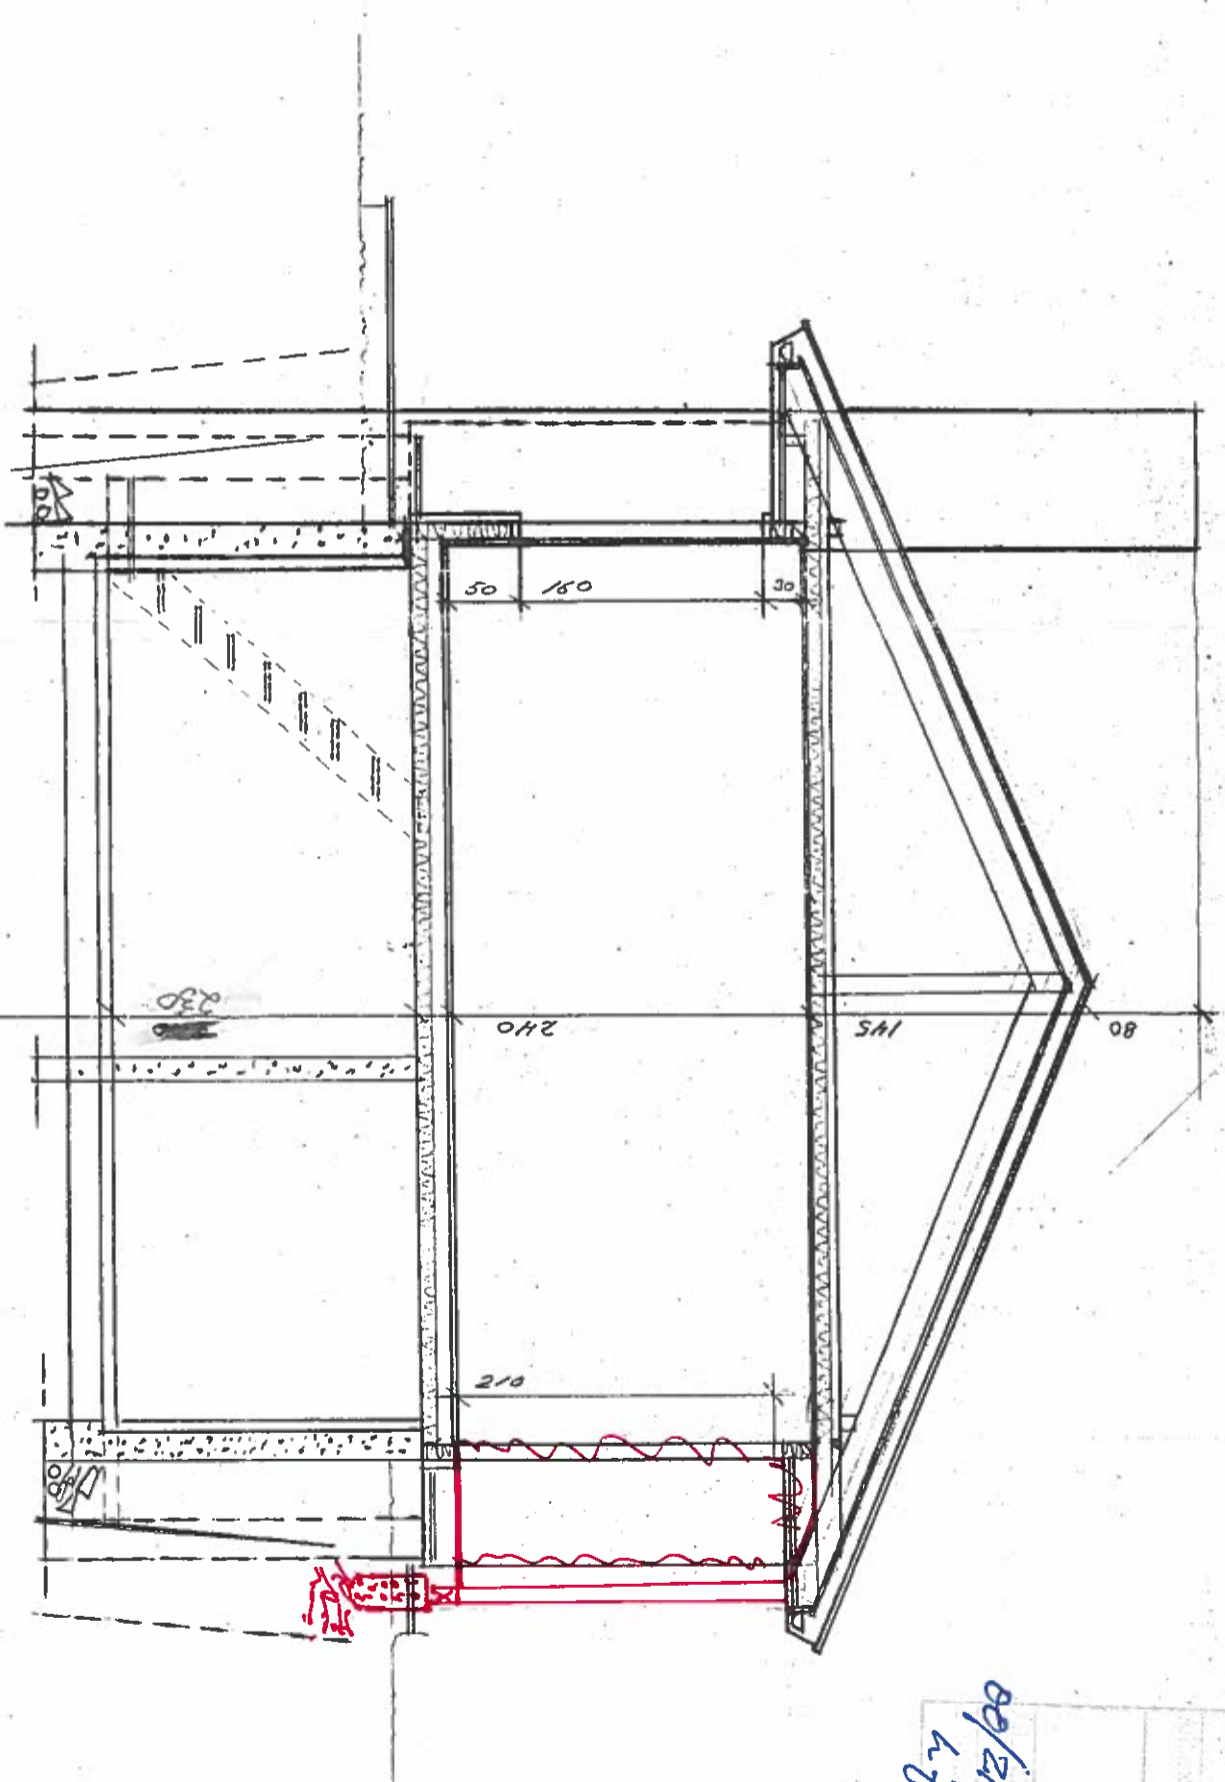

SNITT

SNITT

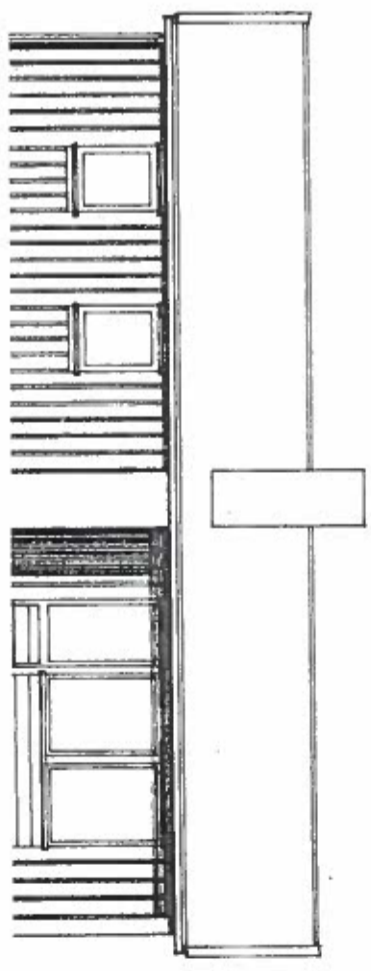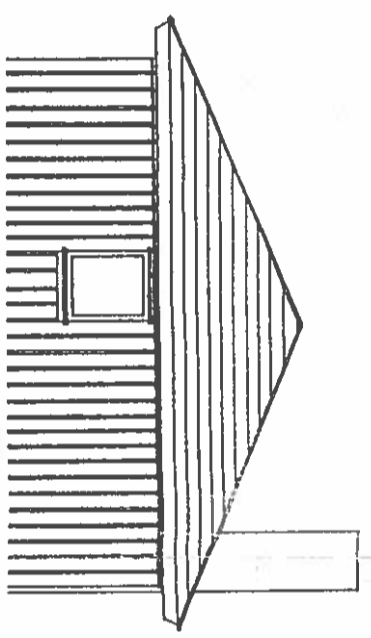

137/158  
 Plummerberg

11

EKSISTRENDE UNDERETASJE

