


E 305000

E 305050

N 6727550

N 6727500

N 6727450

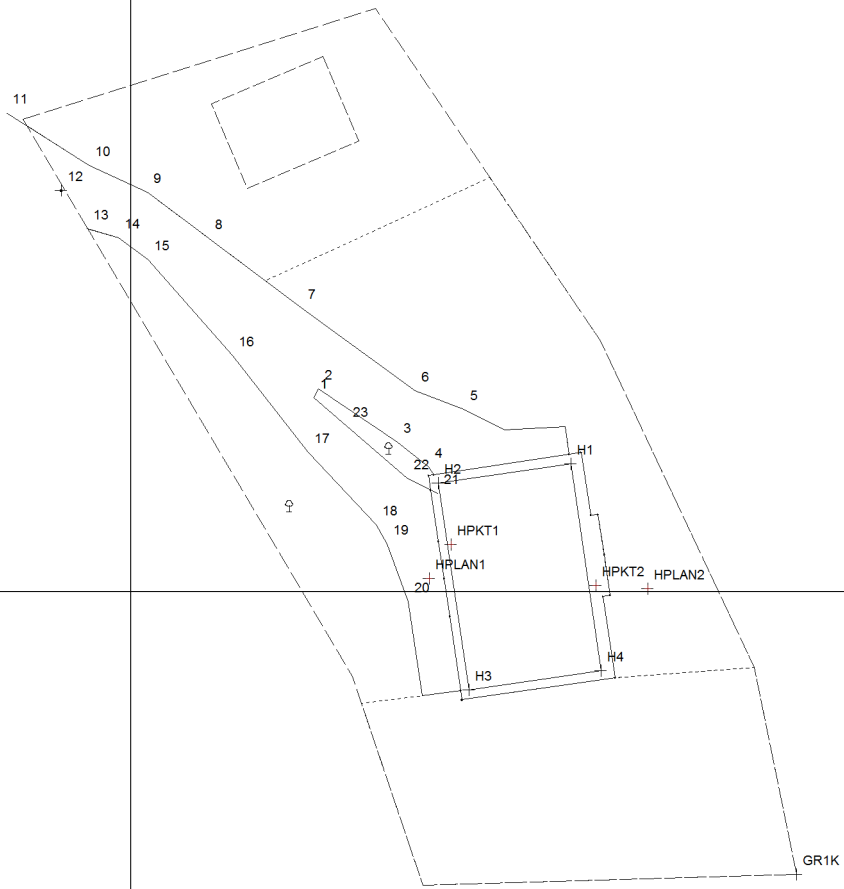

Gnr.241 bnr.13, Bjørge  
Innmålt grunnmur  
07.11.2014  
Målestokk 1:500  
Medaas Oppmåling