

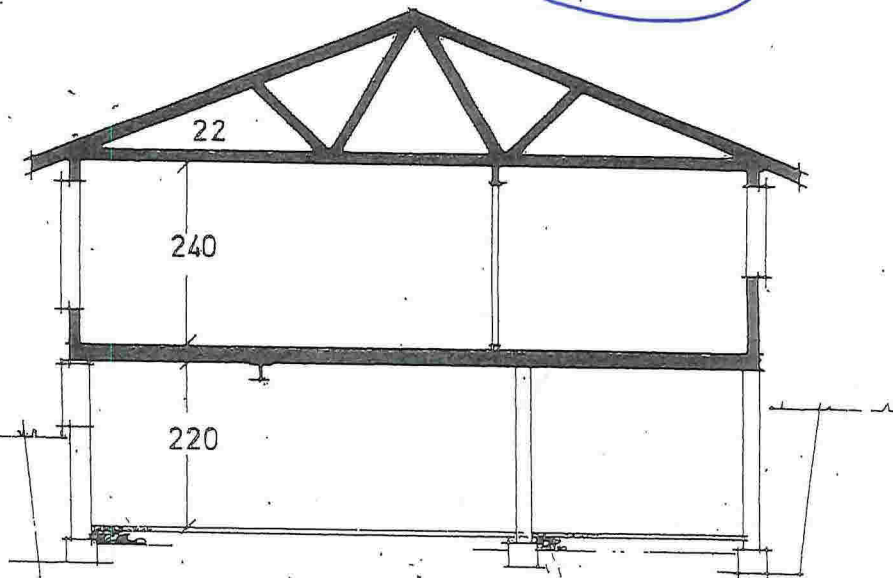
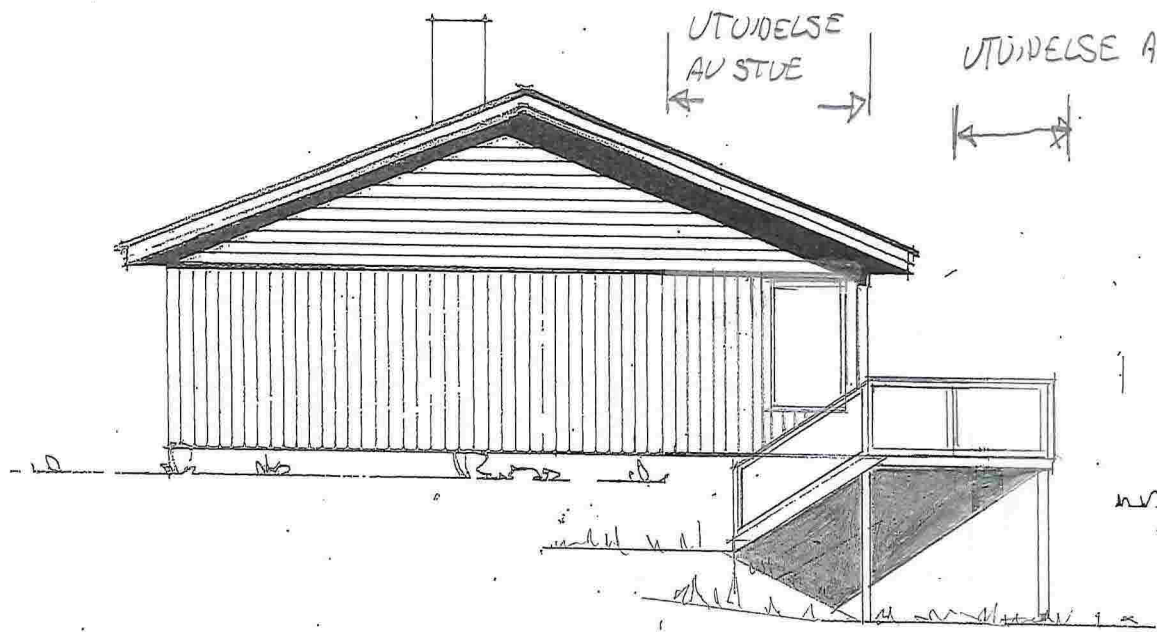
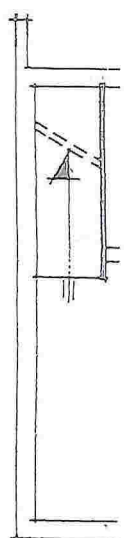
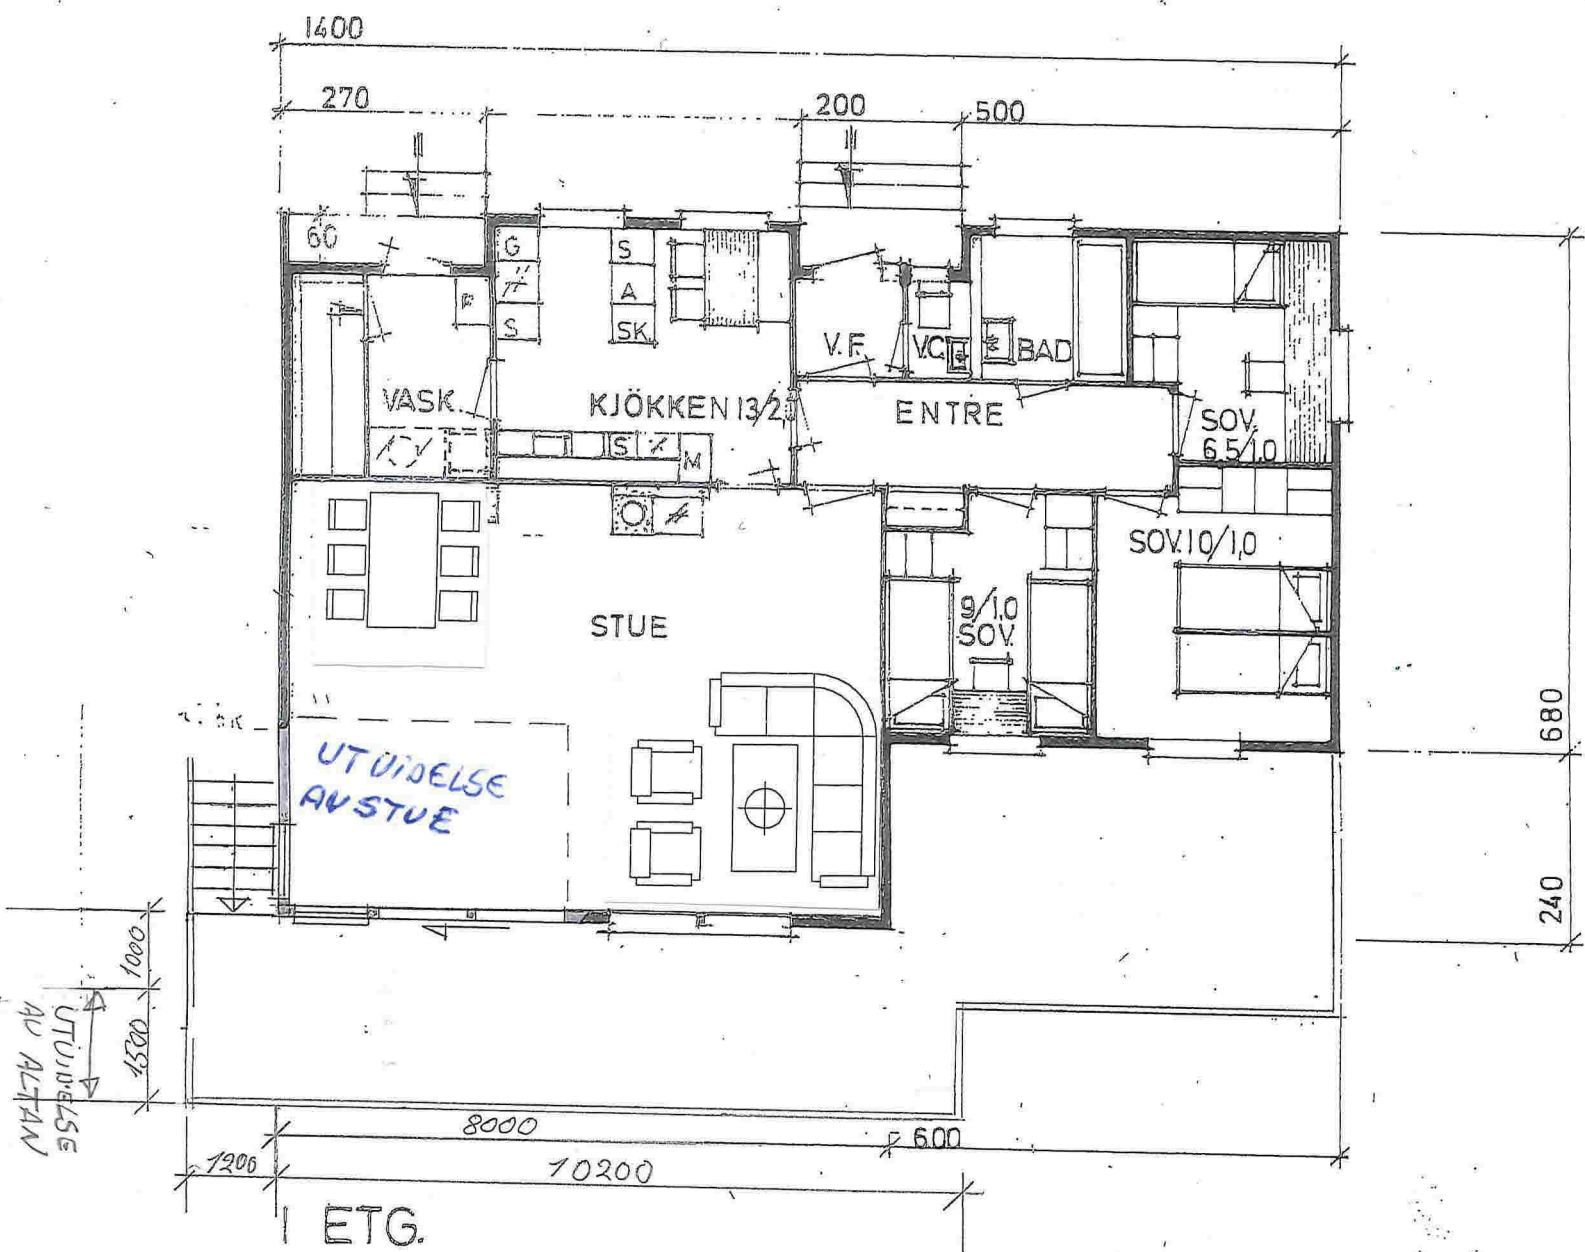


E-4

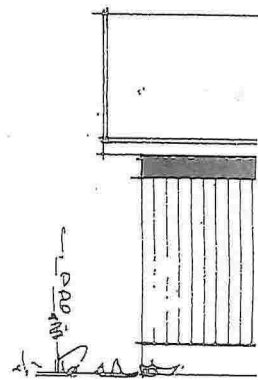


SNITT


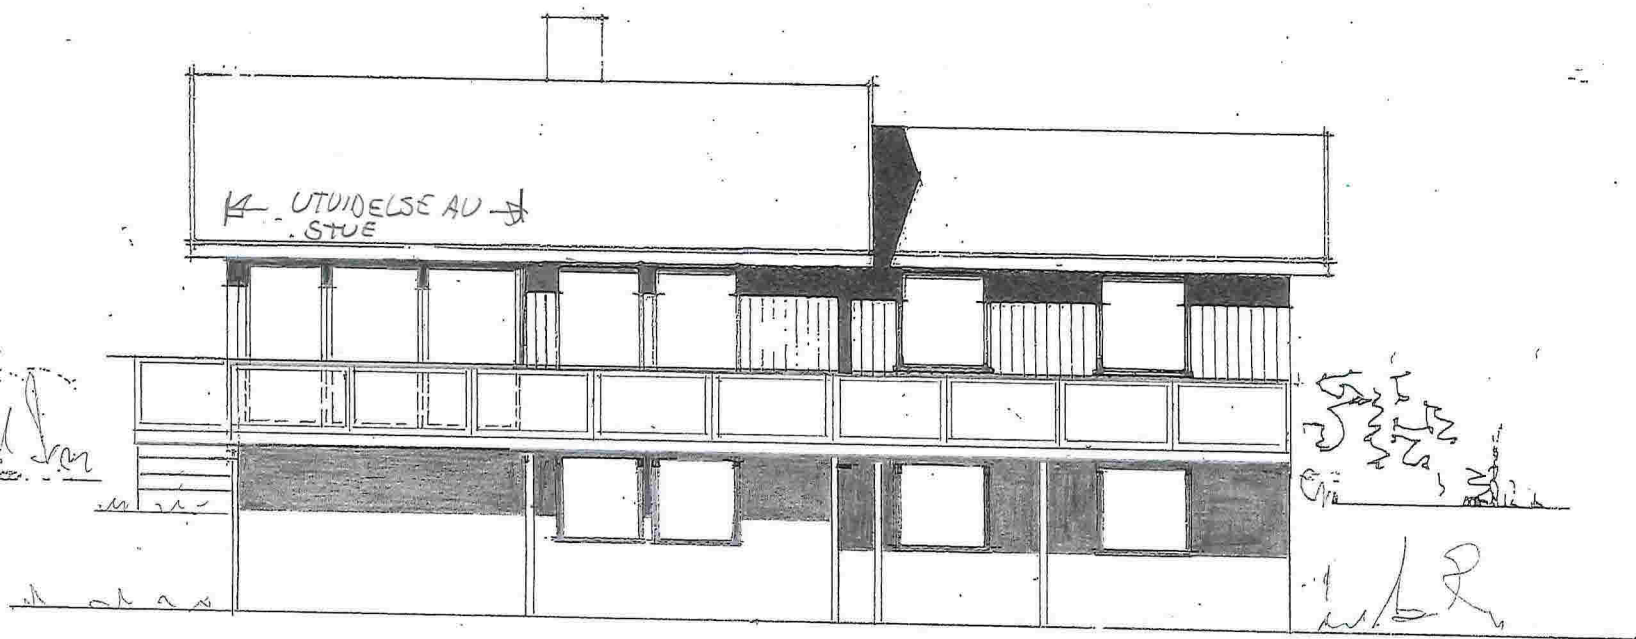


# KJE

E-3

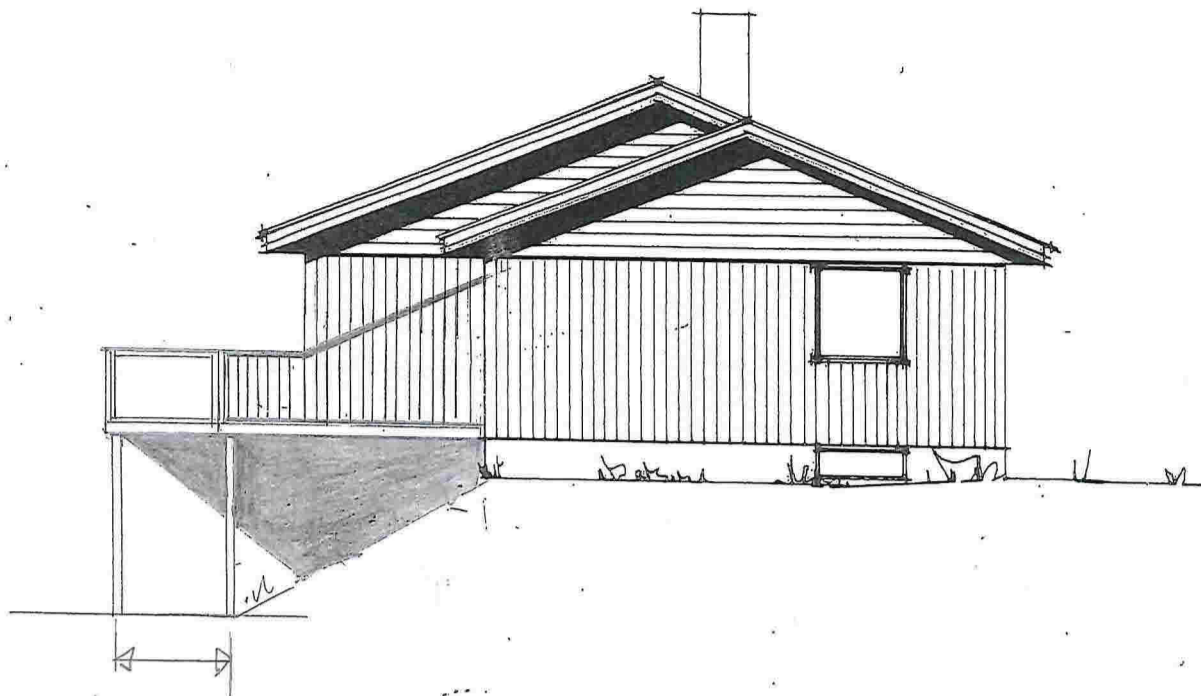

UTVIDELSE  
ACTAN

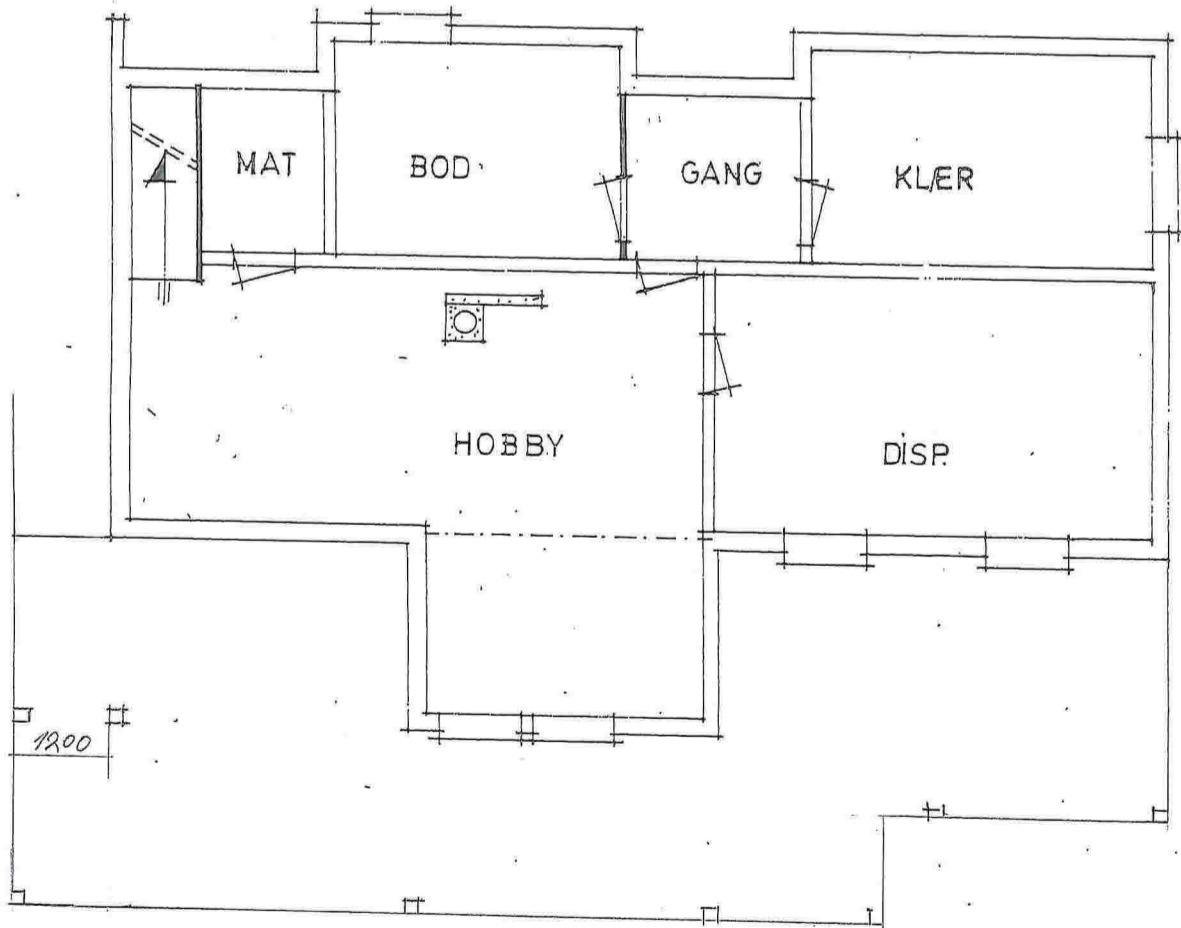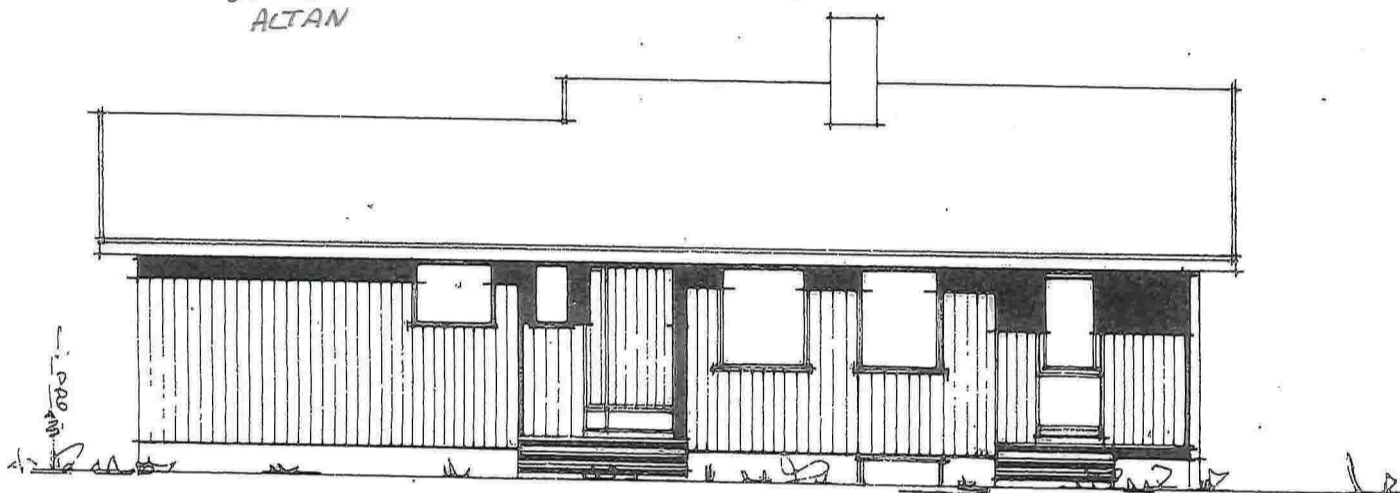

TYPE 66 A.



LEIEAREAL 95,1 m<sup>2</sup>





ARKITEKT  
HARALD HEGGHEIM  
2340 LØTEN

MÅL	DATO	13-8
1:100	REV.	
	TEGN.	<i>[Signature]</i>

E-2

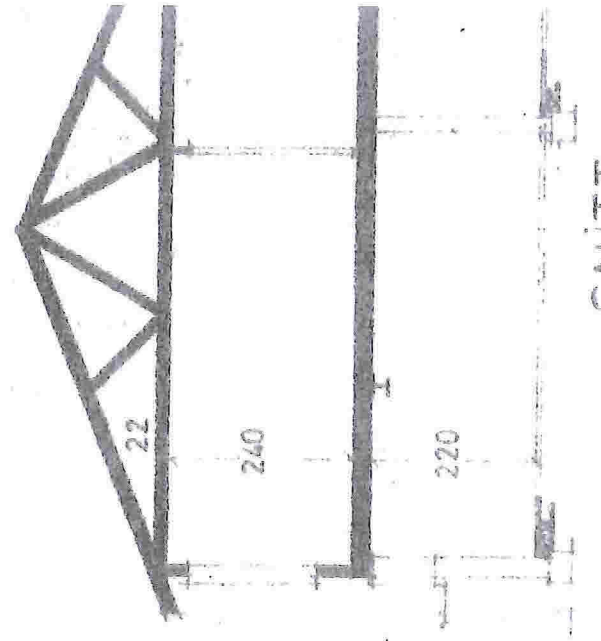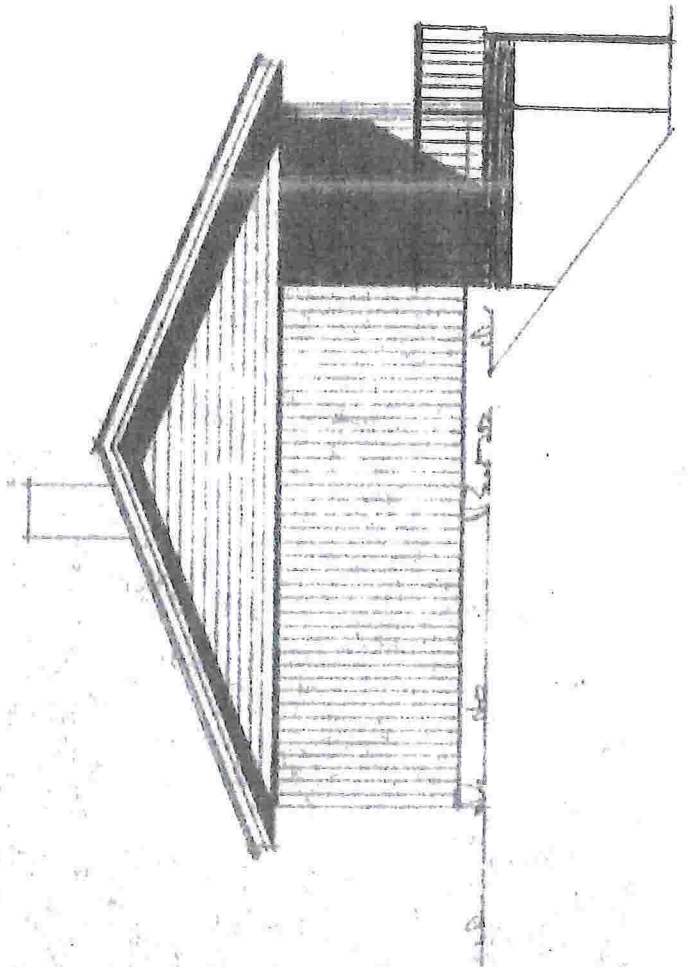



SNITT

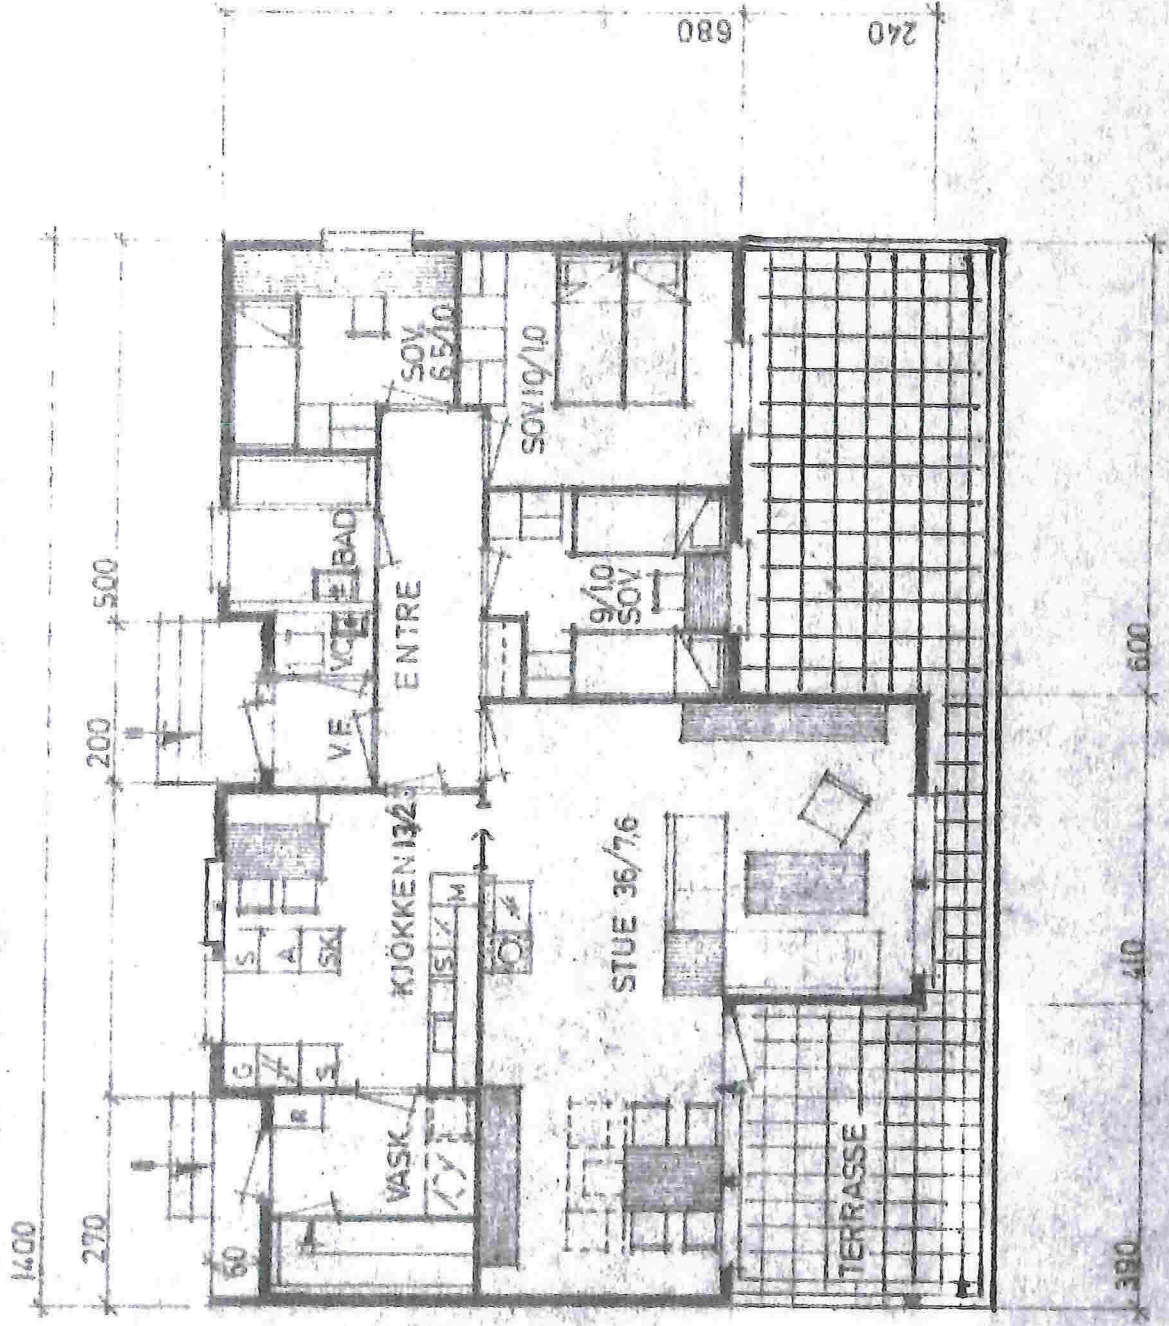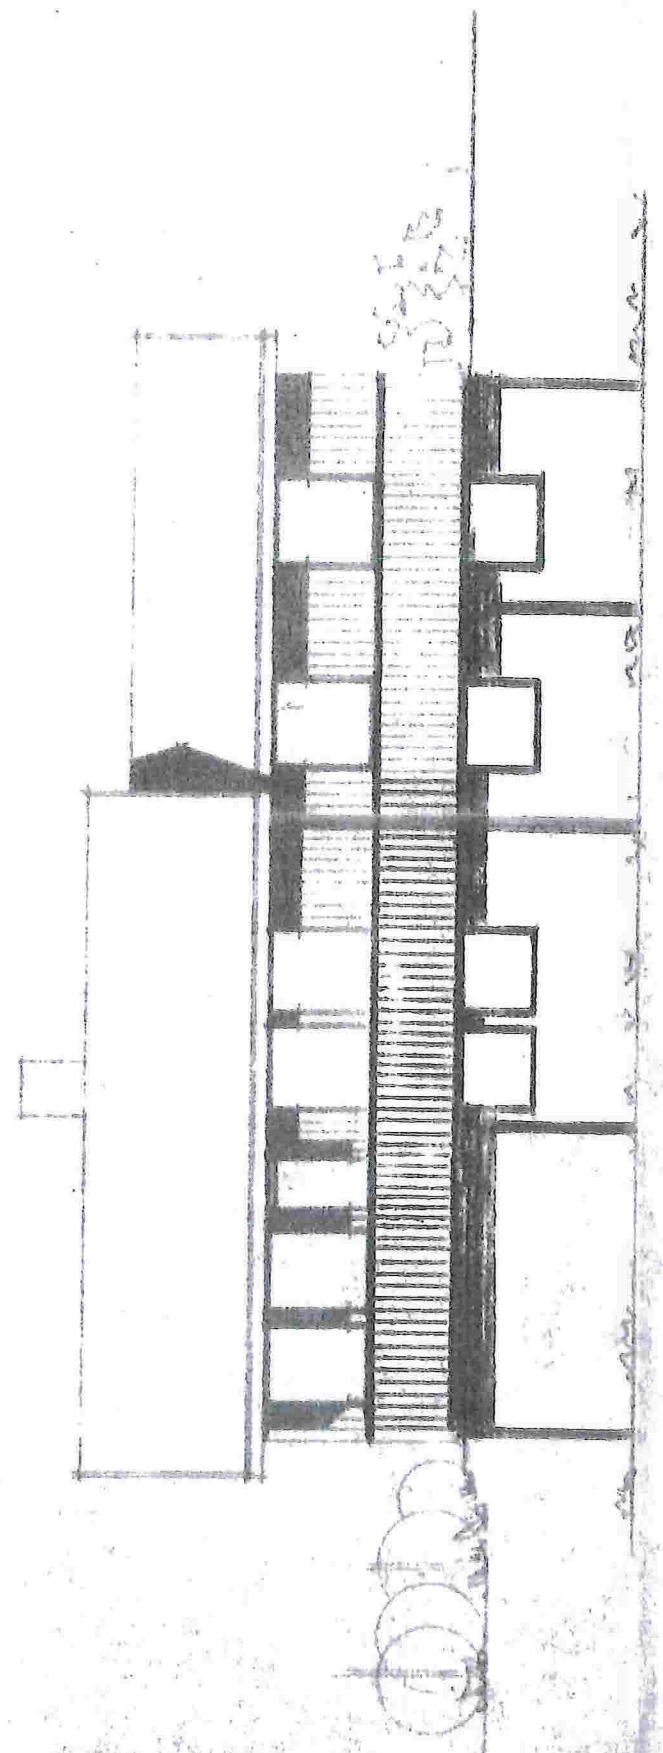

ETG.

E-1

ARKIV

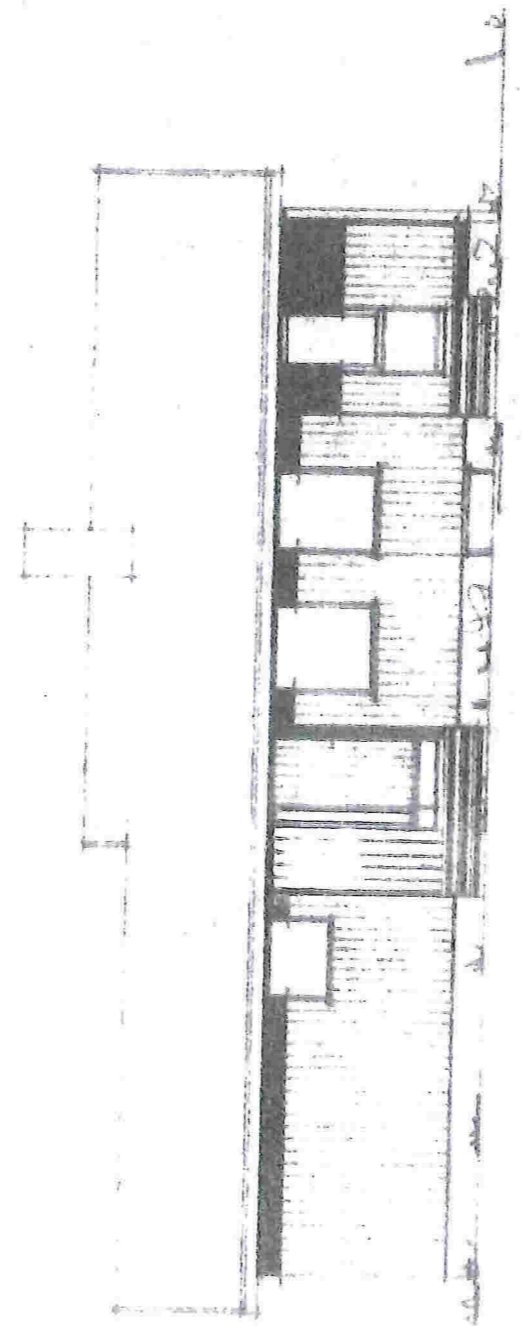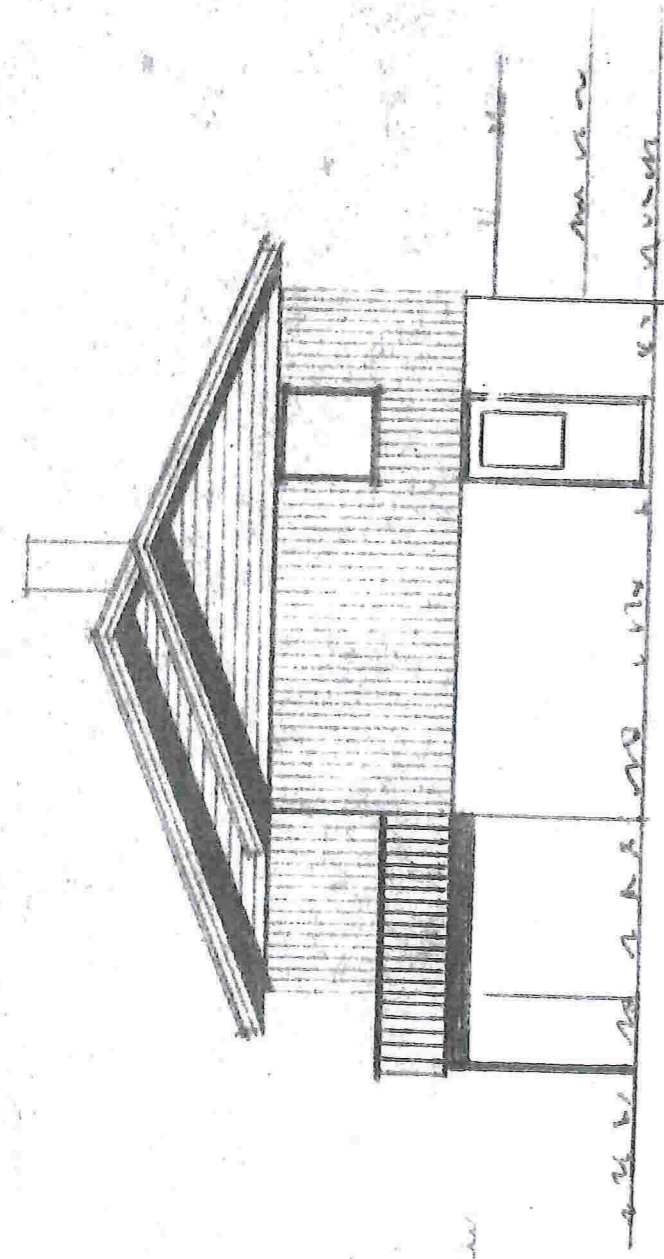


ARKIV

HANDLINGSBREV  
4 NOV. 1981  
BYGNINGSSJEFEN I LINDÅS

Hordaland  
HUS

LINDÅS  
01000 250001  
Arkiv nr. 185-

TYPE 66 A.

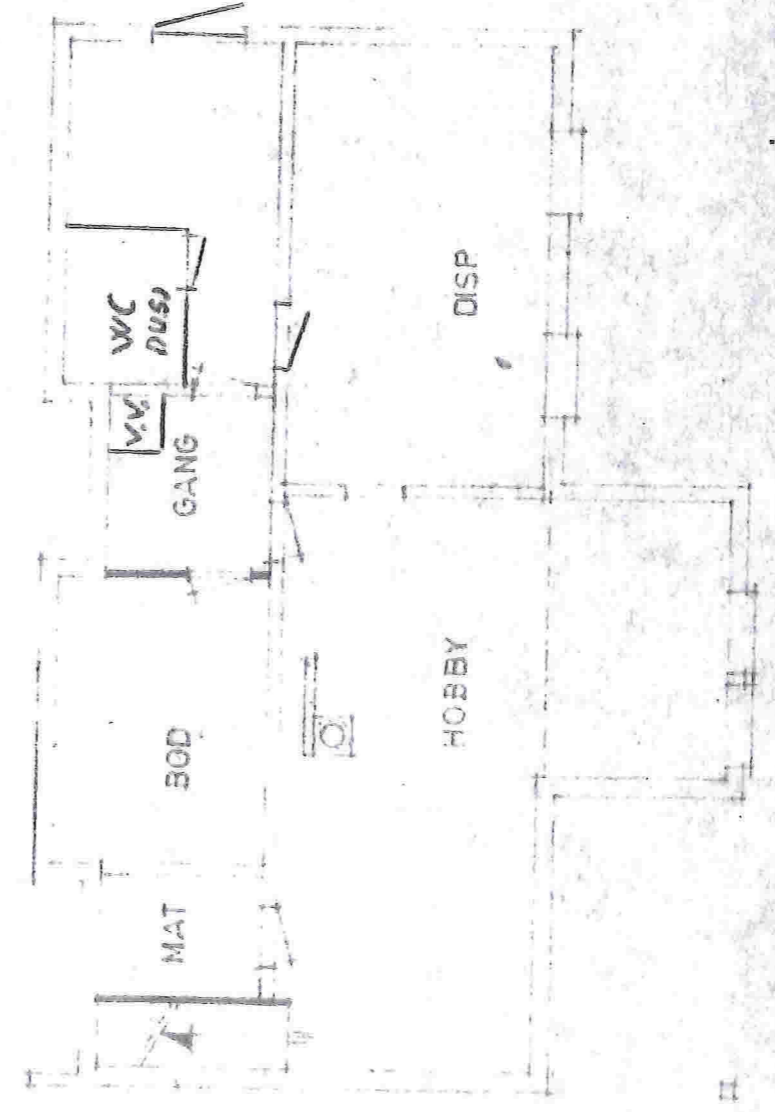

FJELLER

LEIEAREAL 95,1 M

HERLEIF OG TORTLD KYAMME

ARKITEKT  
HARALD HEGGHEIM  
2340 LØTEN

MÅL 1:100	DATA	13-8-75
	REV	
	TEGN	Heggheim