
909:1

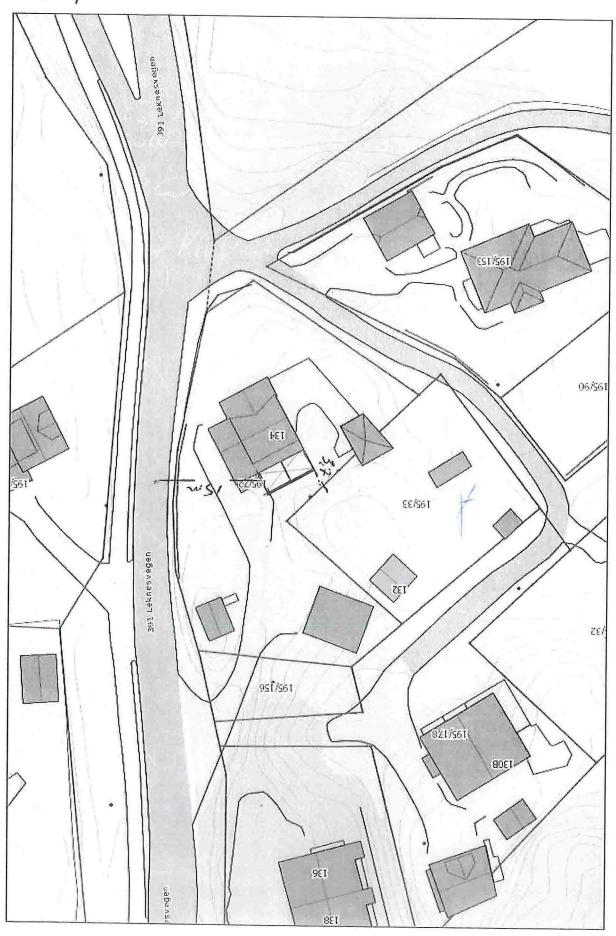

{