




Lindås, gnr 55 bnr 32,  
Data på innmålt fasadeliv

09.10.2014

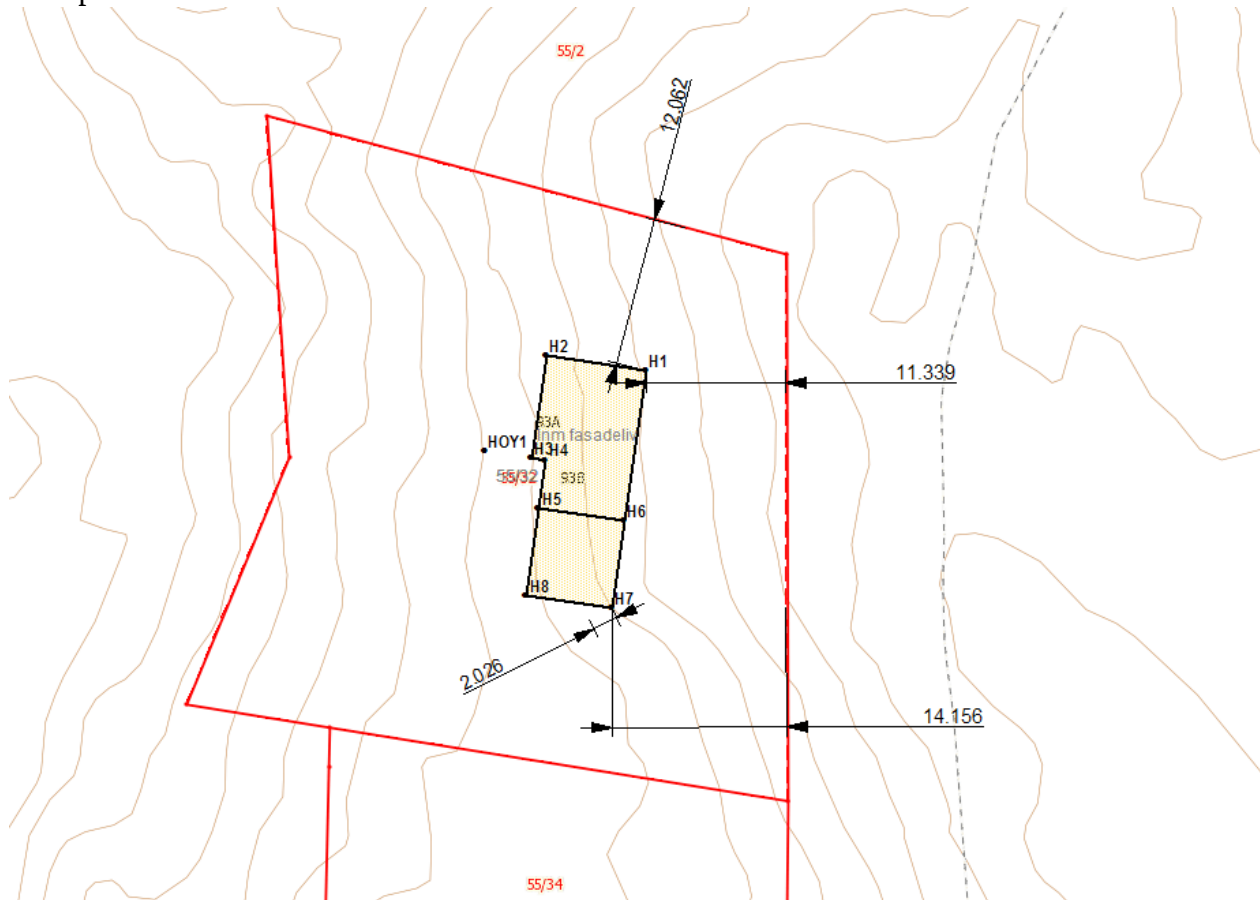

PunktID	N-koord.	Ø-koord.	Høyde
H1	6733883,53	293421,23	
H2	6733884,77	293413,18	
H3	6733876,48	293411,96	
H4	6733876,31	293413,11	
H5	6733872,36	293412,55	
H6	6733871,36	293419,47	
H7	6733864,28	293418,46	
H8	6733865,30	293411,53	
HOY1	6733877,03	293408,20	55,24

**Planert høyde: kote +55,24**