



FASADE MOT SYD-ØST

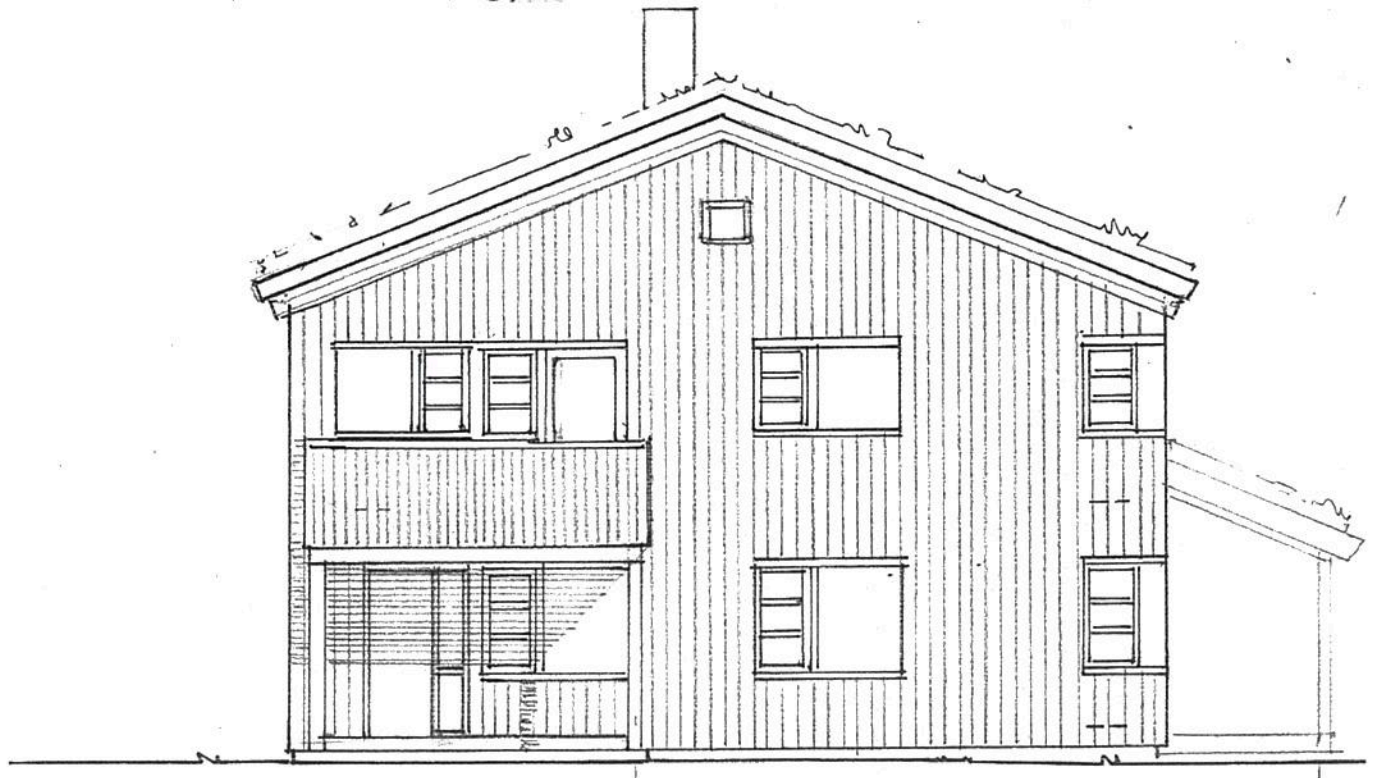


FASADE MOT NORDVEST

DYRKOLBOTN FJELLSTOVE - PERSONALBOLIG	15.06.2015
Fasader Nord-vest og Syd-øst	M 1 : 100
Siv. ark. MNAL Anne Lise Nos	
Øvre Baklandet 1B	
7013 Trondheim – Tlf. 911 12 757	

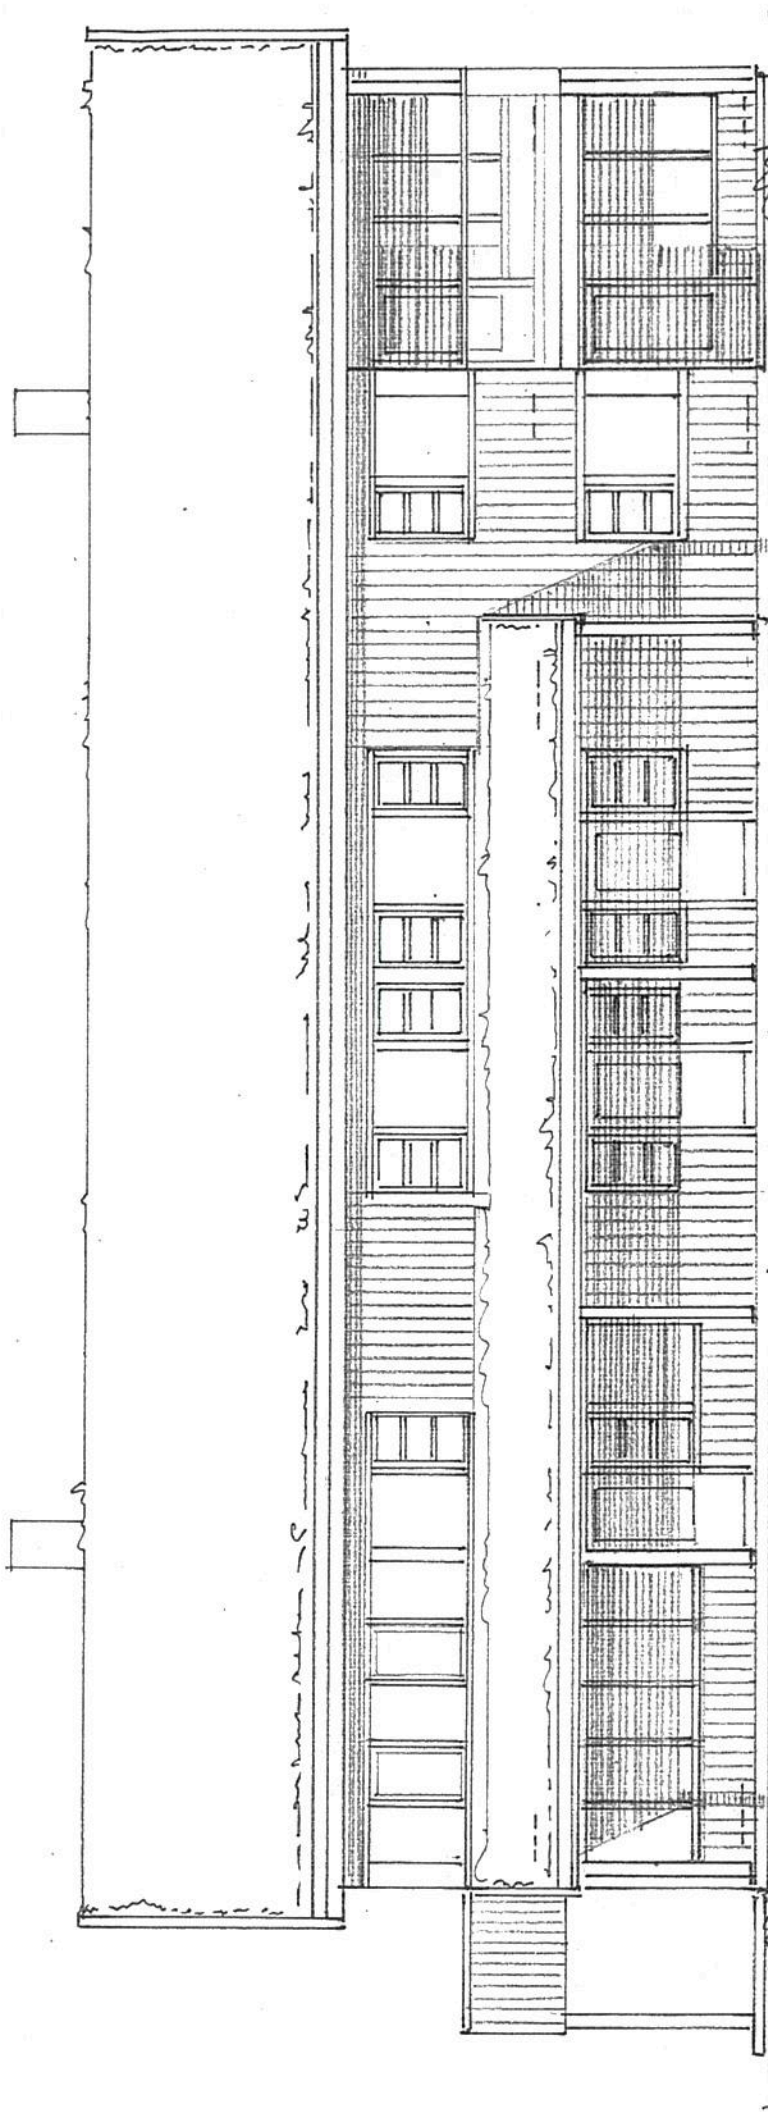


IFASADE MOT SYD-VEST

DYRKOLBOTN FJELLSTOVE - PERSONALBOLIG	15.06.2015
Fasade Syd-vest	M 1 : 100
Siv. ark. MNAL Anne Lise Nos Øvre Bakklundet 1B 7013 Trondheim - Tlf 911 12 757	05

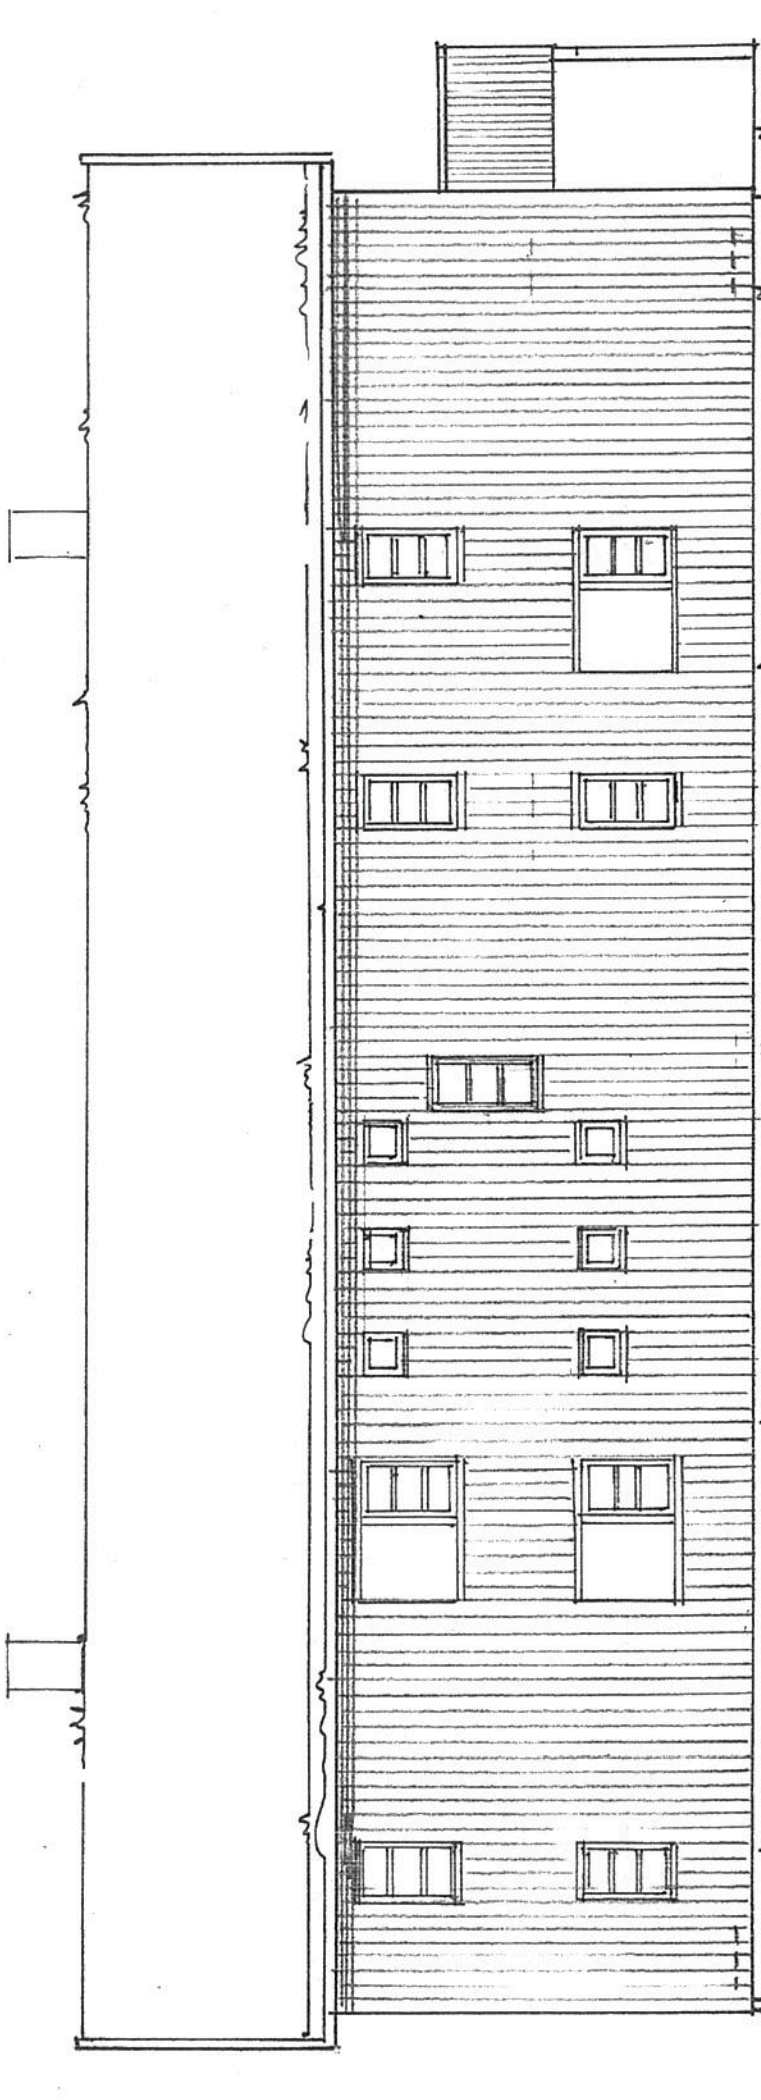

FASADE MOT HORD-ØST

DYRKOLBOTN FJELLSTOVE - PERSONALBOLIG	15.06.2015
Fasade Nord-øst	M 1 : 100
Siv. ark. MNAL Anne Lise Nos Øvre Baklandet 1B 7013 Trondheim - Tlf 011 12 757	06

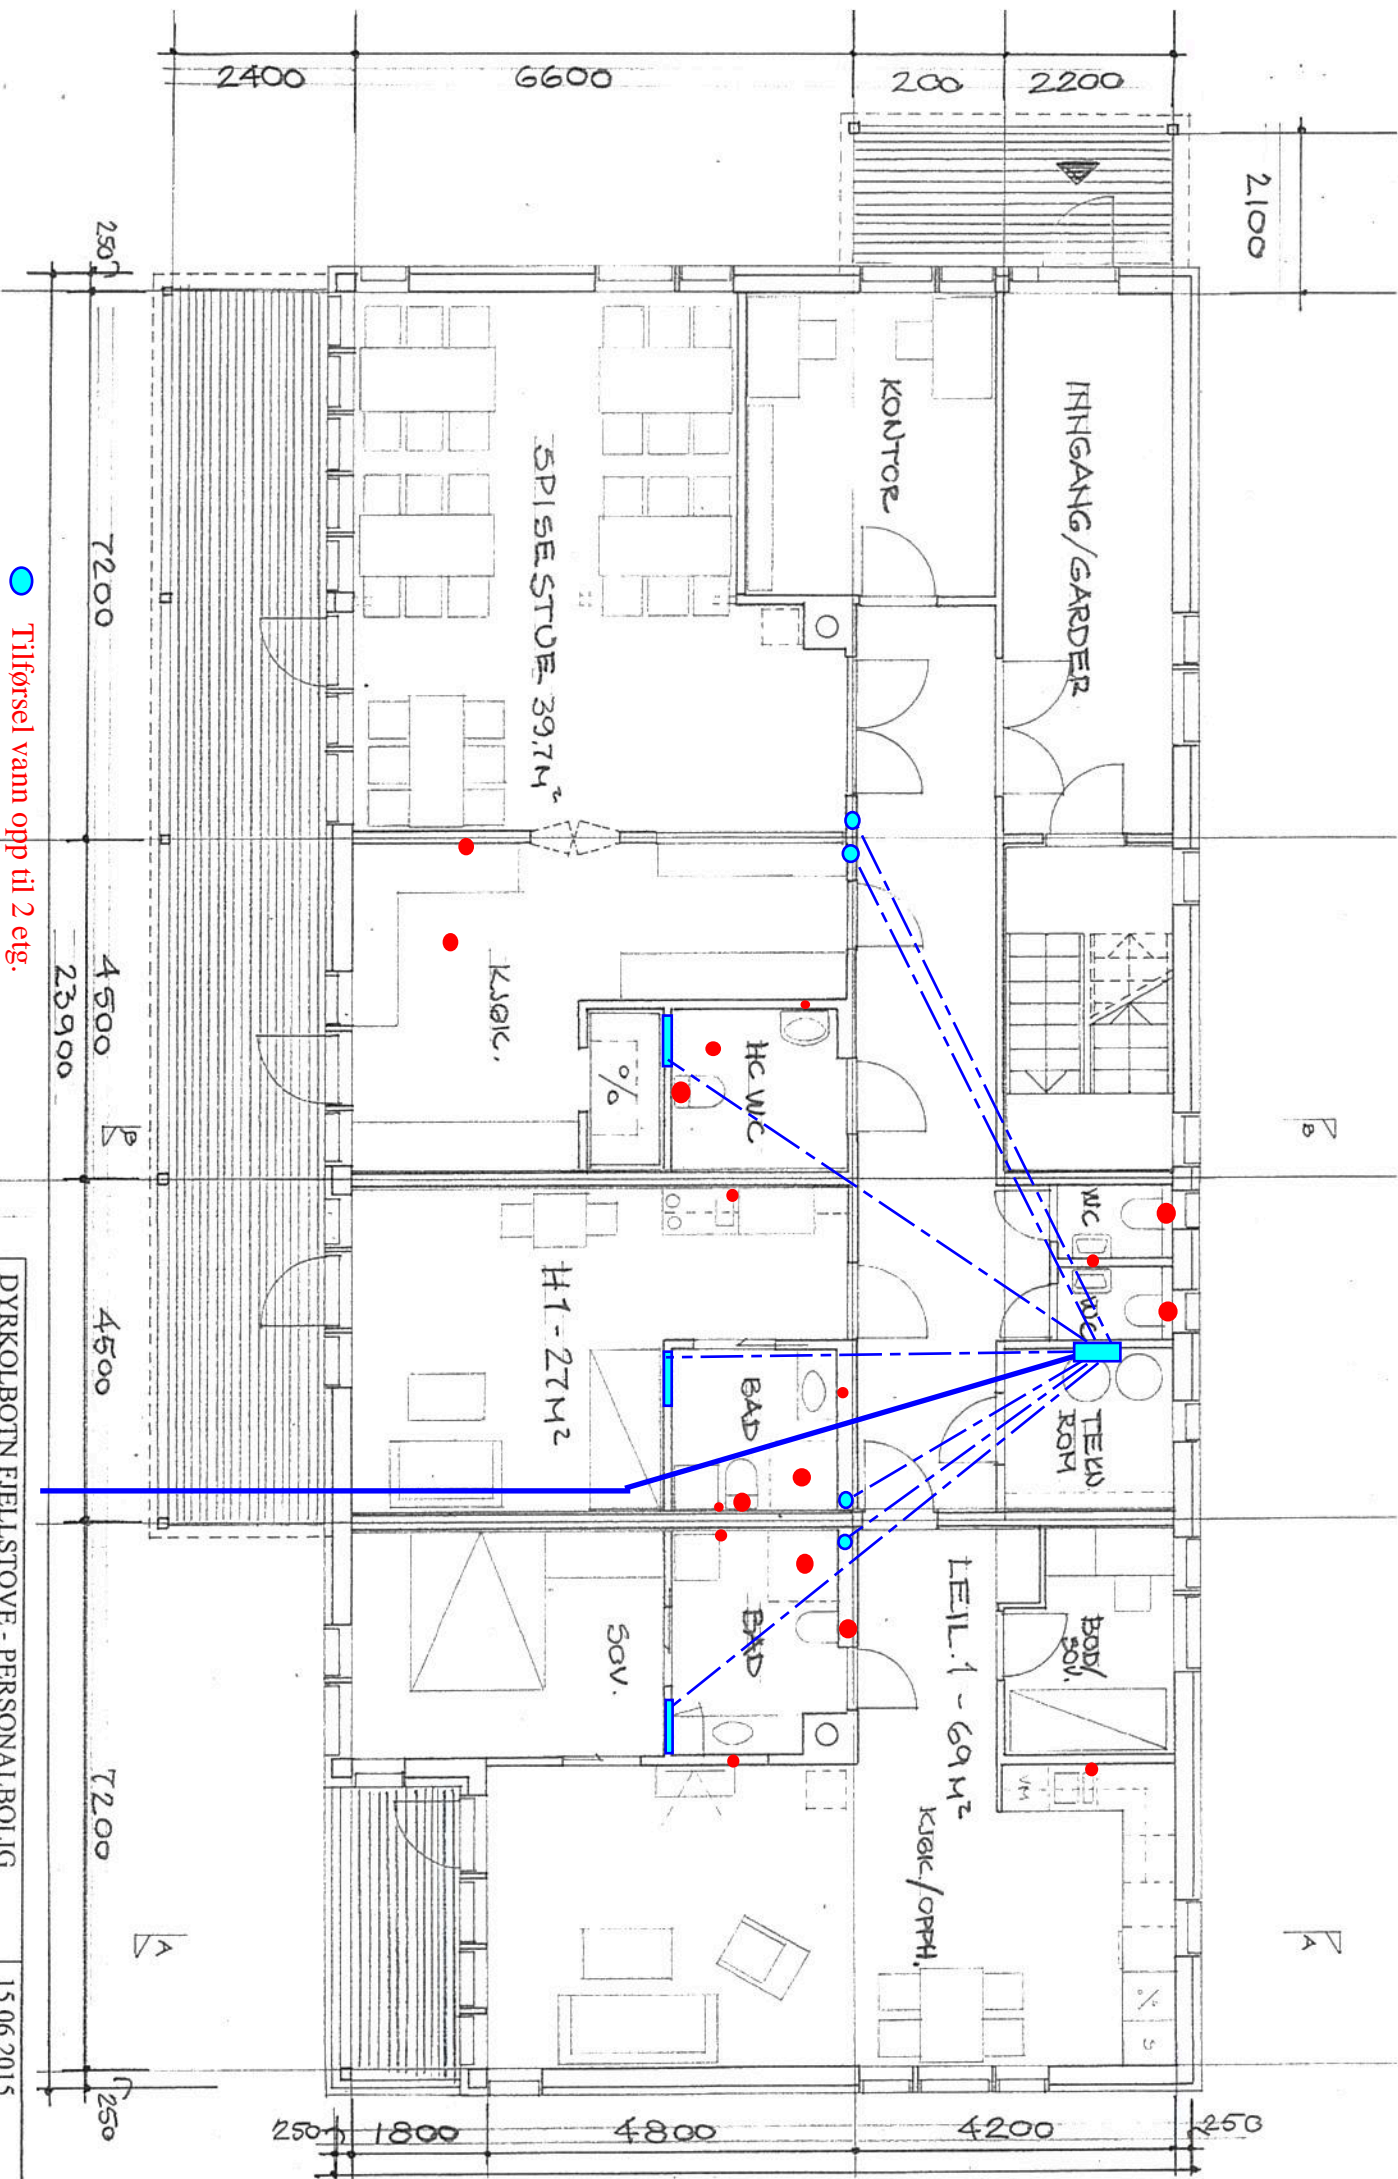


Stusdal VVS a/s

Kvalitet i fokus

● Tiltørrel vann opp til 2 etg.
50mm pe hovedledning.


■ Rør i rør tappevannskap, Vannsentral.
22mm rør i rør pex.

DYRKOLBOTN FJELLSTOVE - PERSONALBOLIG	15.06.2015
Plan 1. etg.	M 1 : 100
Siv. ark. MNAL Anne Lise Nos	
Øvre Bakklundet 1B	
01	

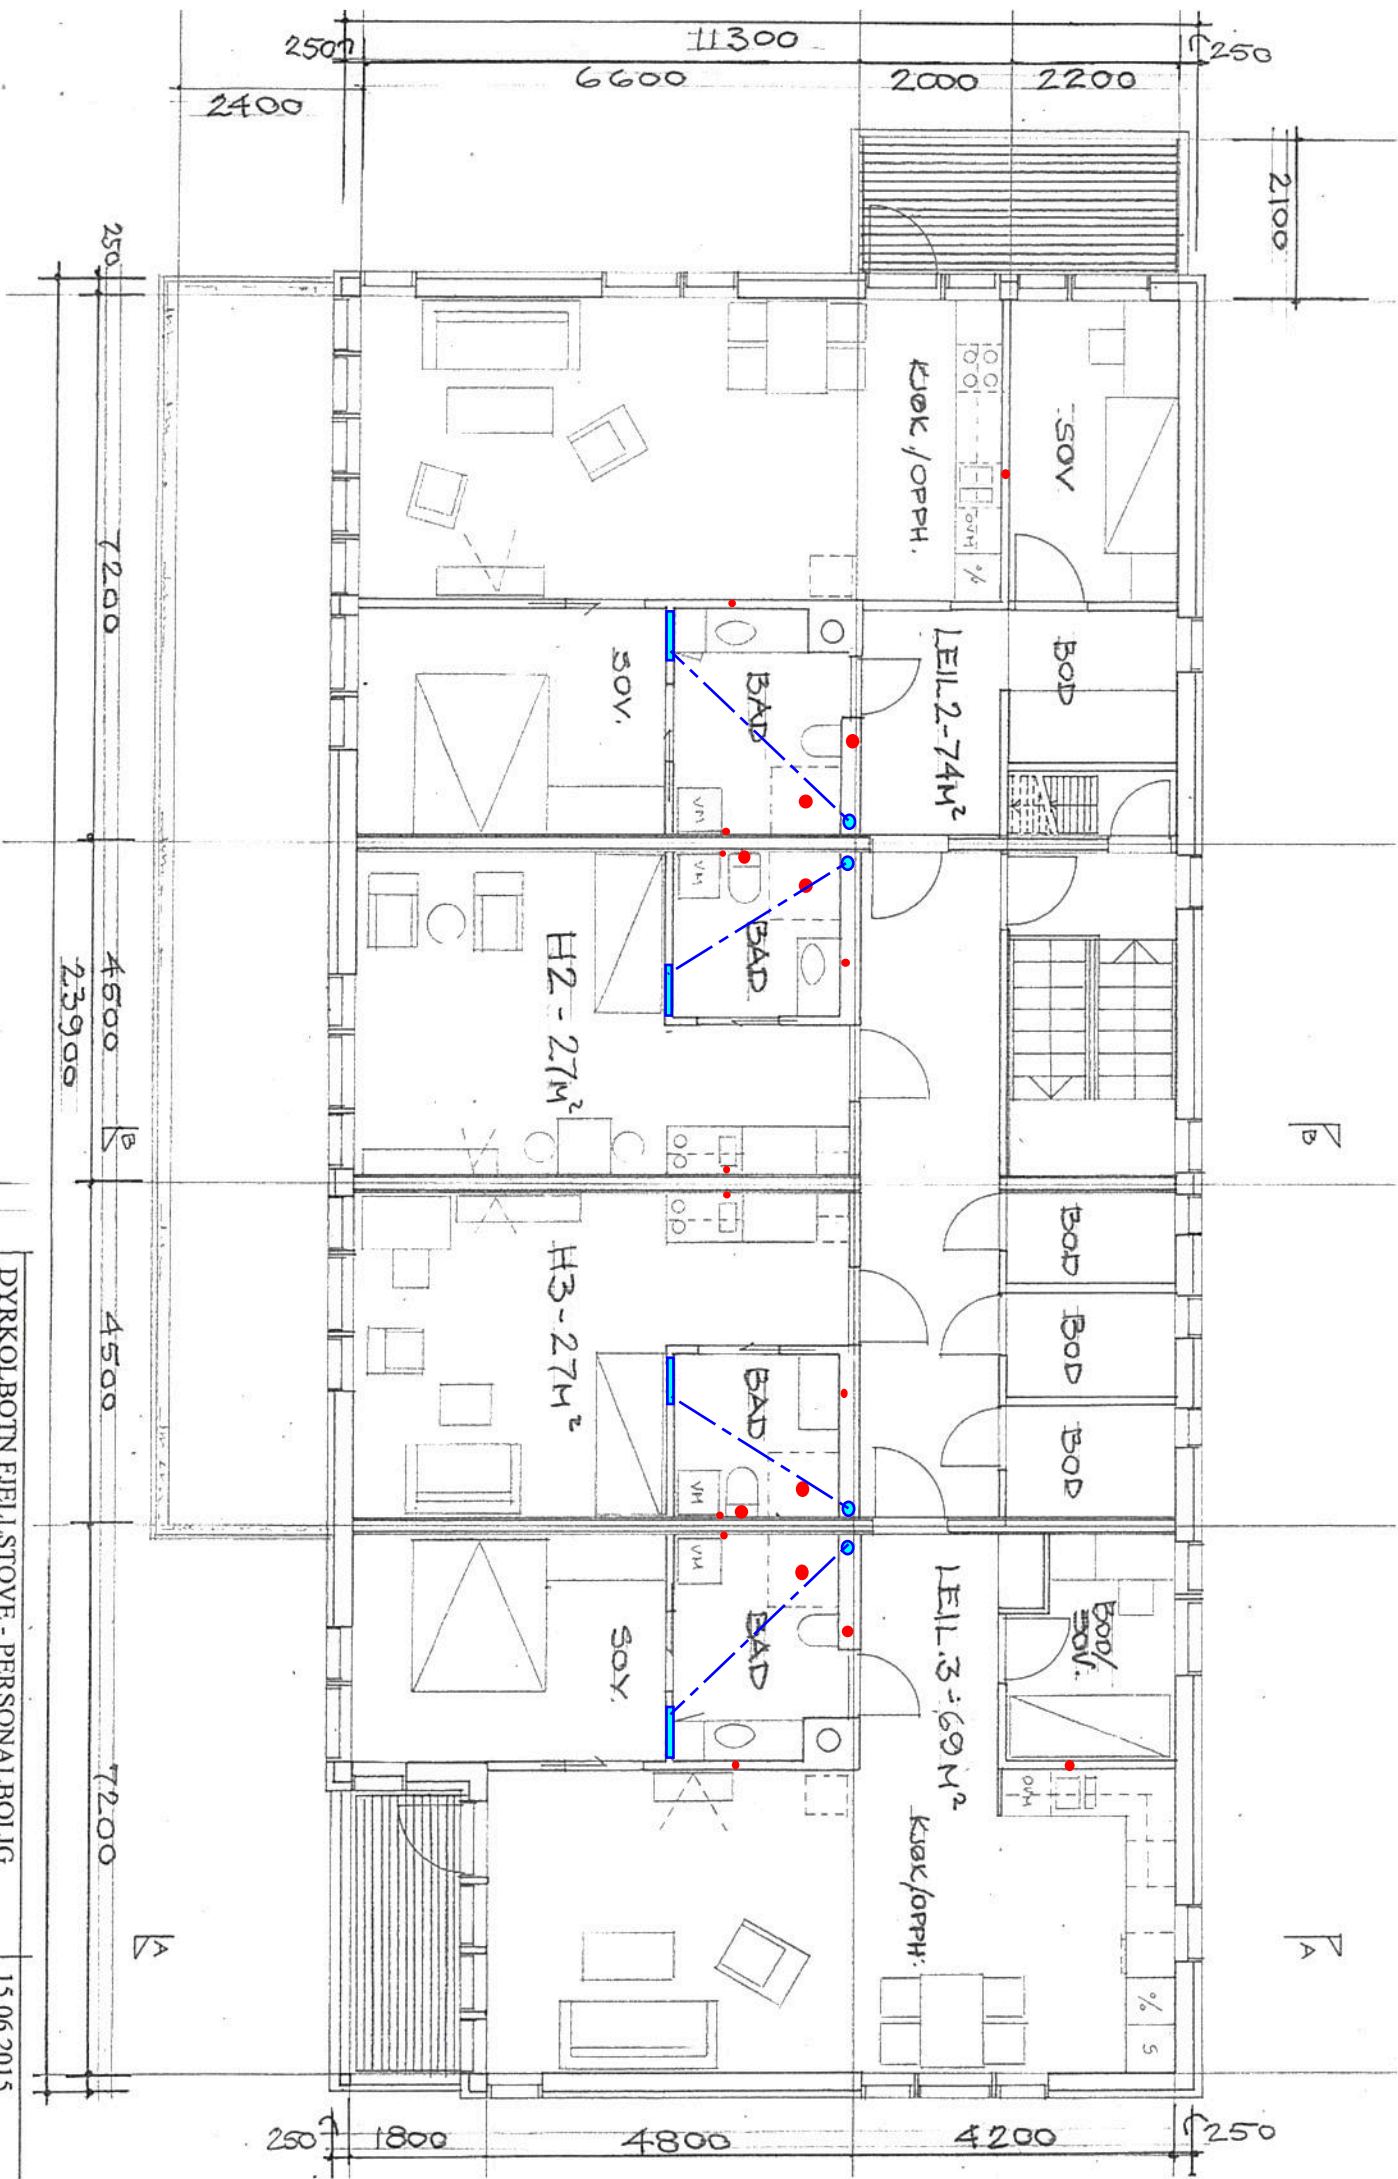


--- 22 mm rør i rør pex.
 Rør i rør tappevannskap.


DYRKOLBOTN FJELLSTOVE - PERSONALBOLIG	
Plan 2. etg.	15.06.2015
Siv. ark. MNAL Anne Lise Nos	M 1 : 100
Øvre Baklandet IB	
7012 Trondheim Tlf 011 19 727	

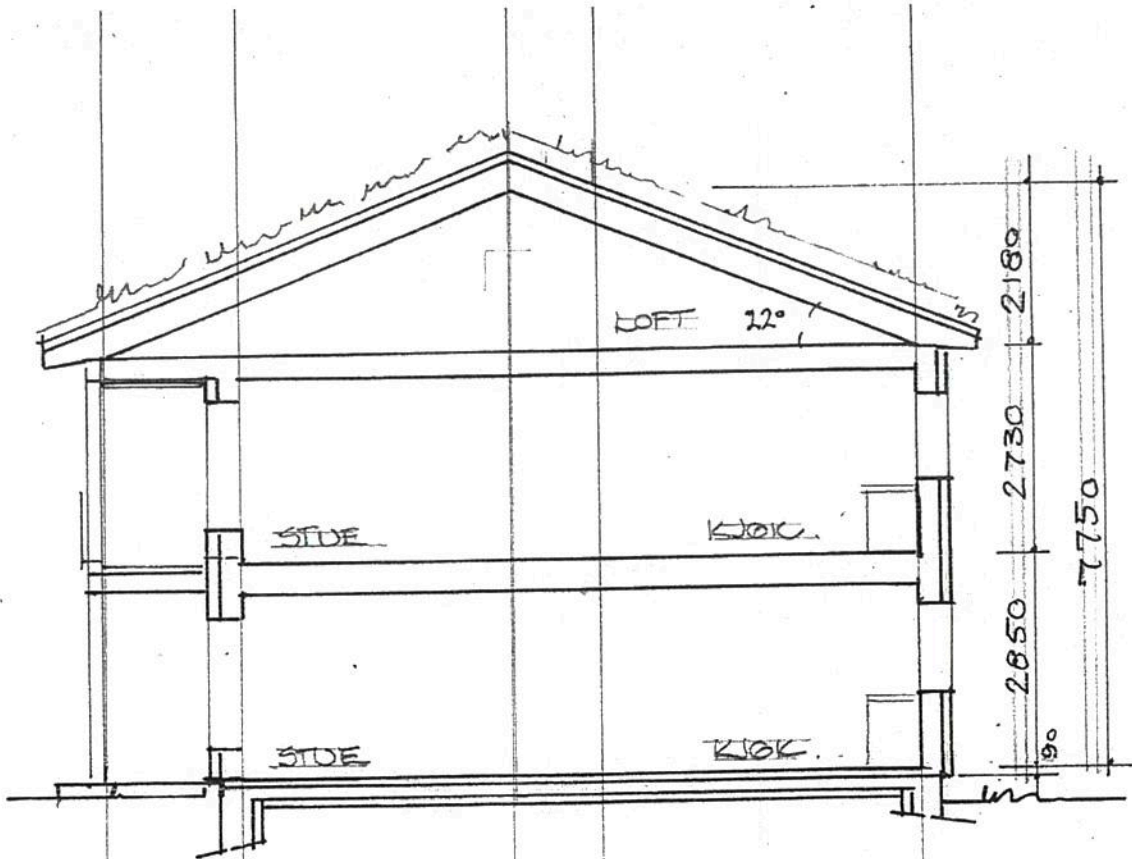

SNITT A-A

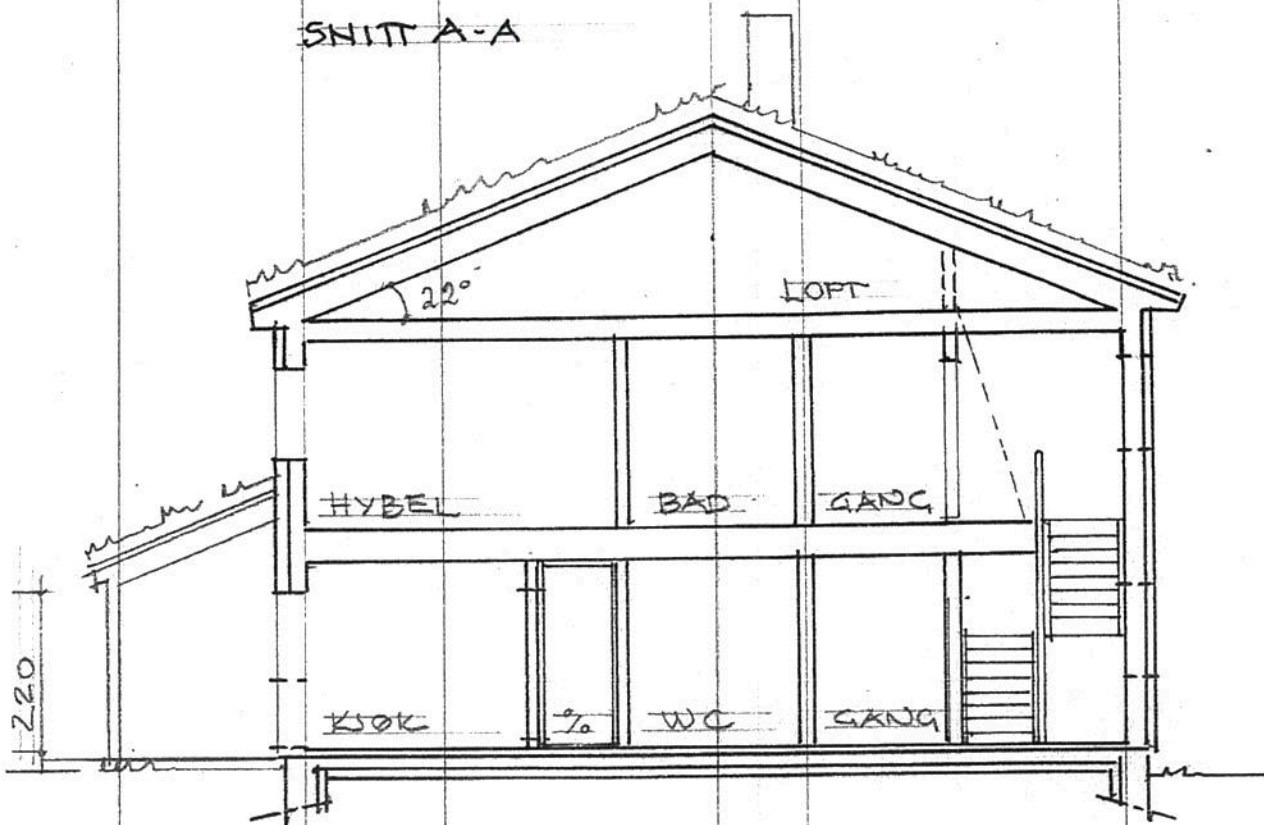

SNITT B-B

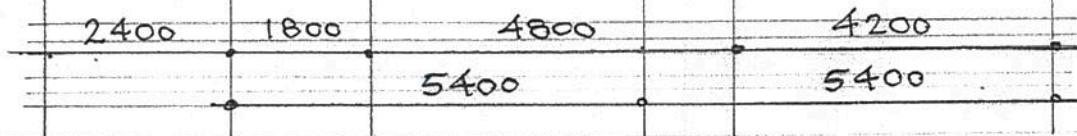

DYRKOLBOTN FJELLSTOVE - PERSONALBOLIG	15.06.2015
Snitt A-A og B-B	M 1 : 100
Siv. ark. MNAL Anne Lise Nos	
Øvre Baklandet 1B	
7013 Trondheim - Tlf. 911 12 757	03