


Fasade Øst

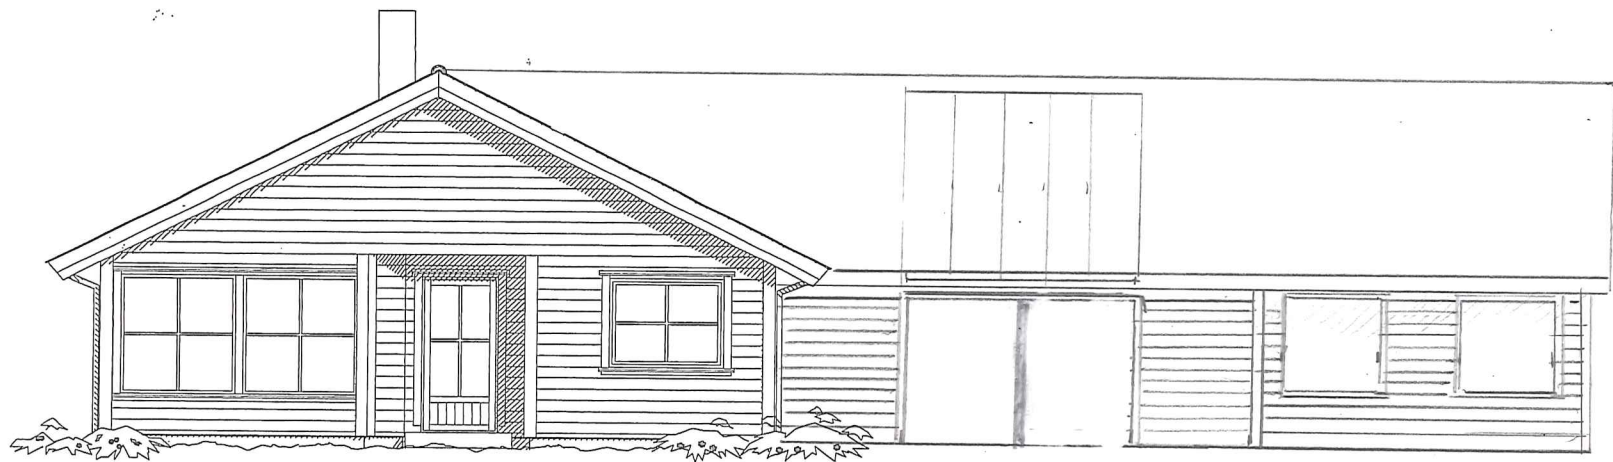


18.11.15



Fasade Vest

18.11.15 R.K

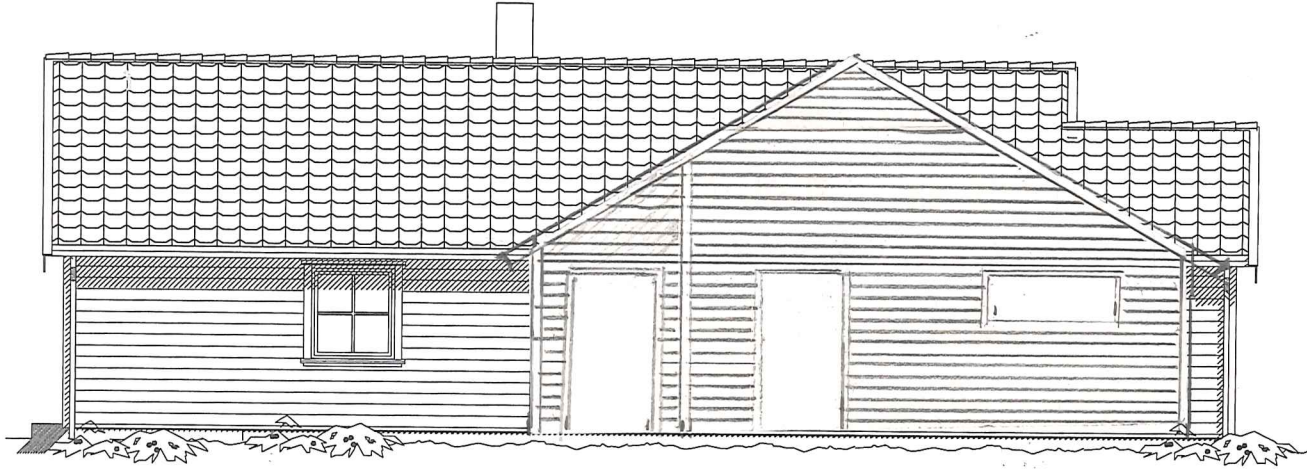

Fasade sør

18.11.15 R.K