


D 8


Ny 5.11.2015
Plassering

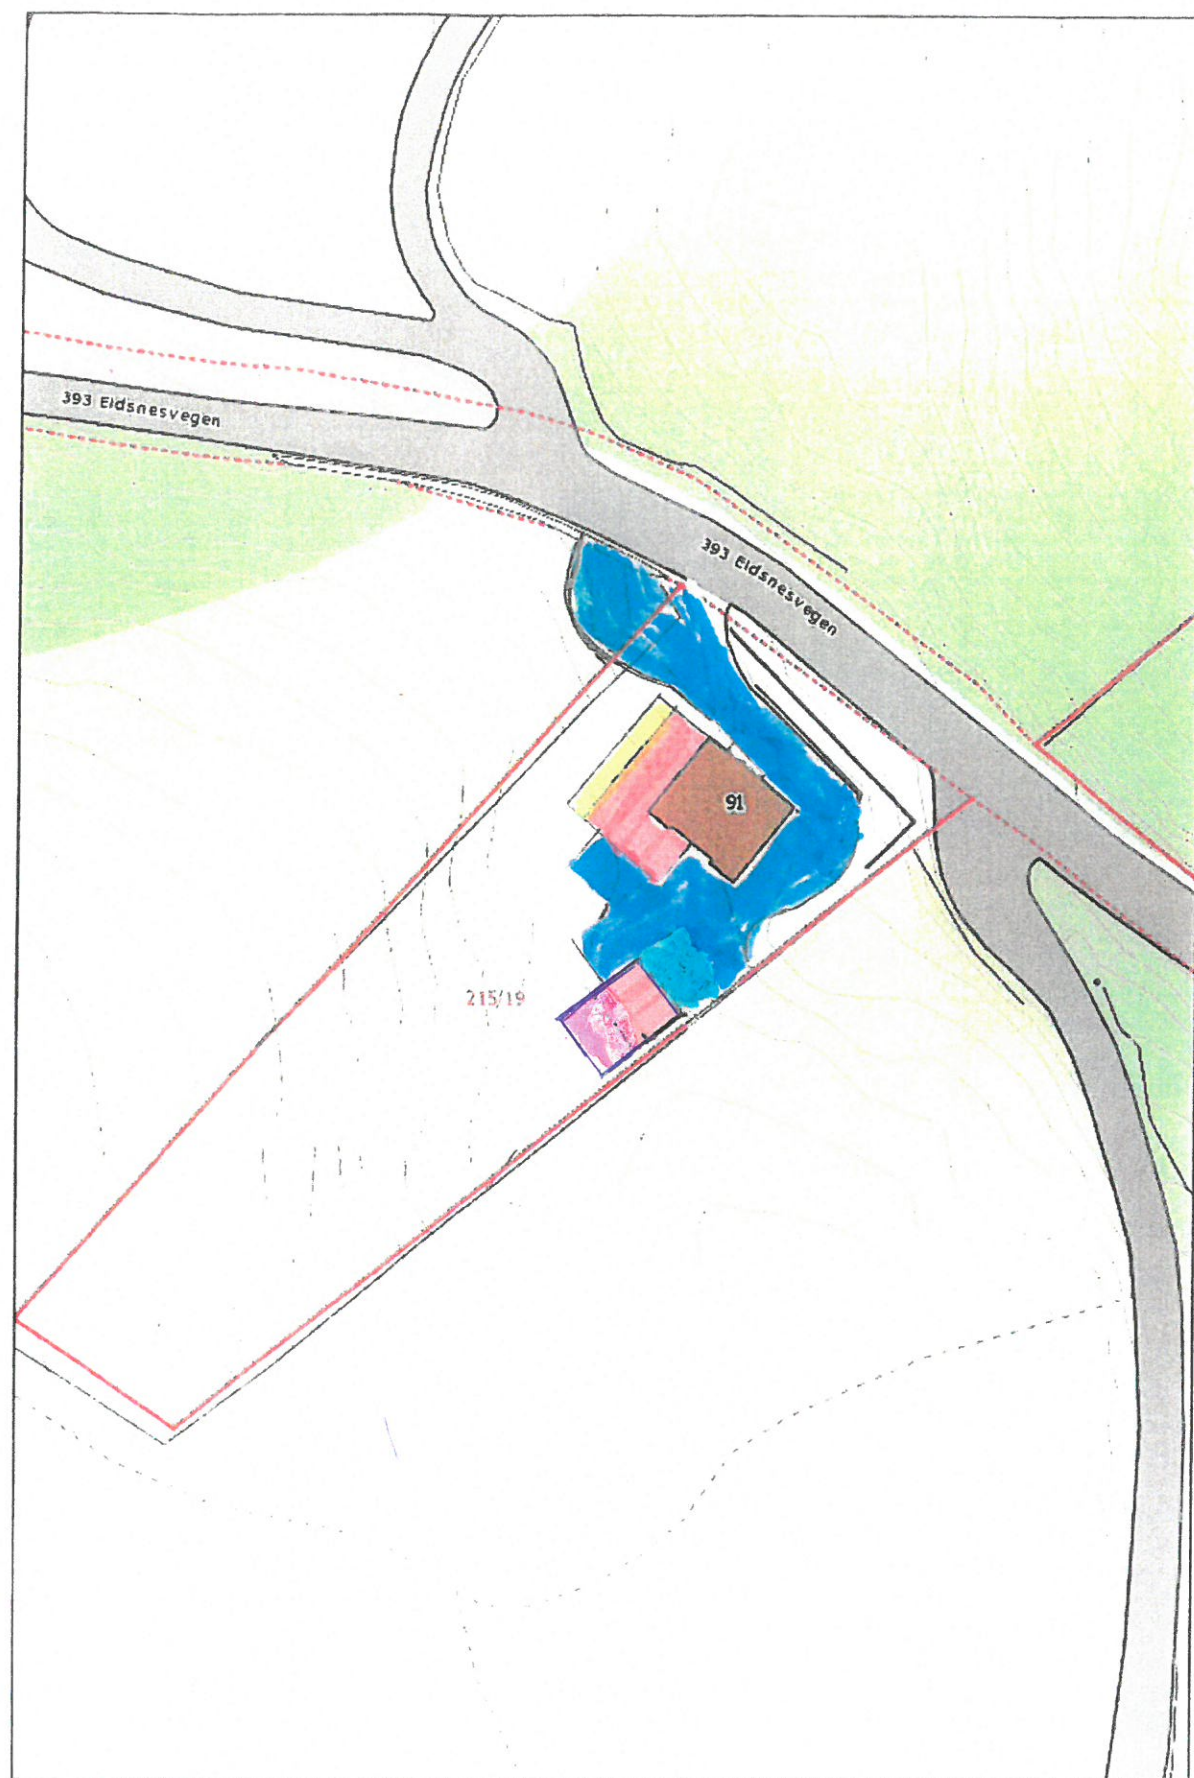

Målestokk 1:500

D 8

Gammel
Plasering (02.03.2015)

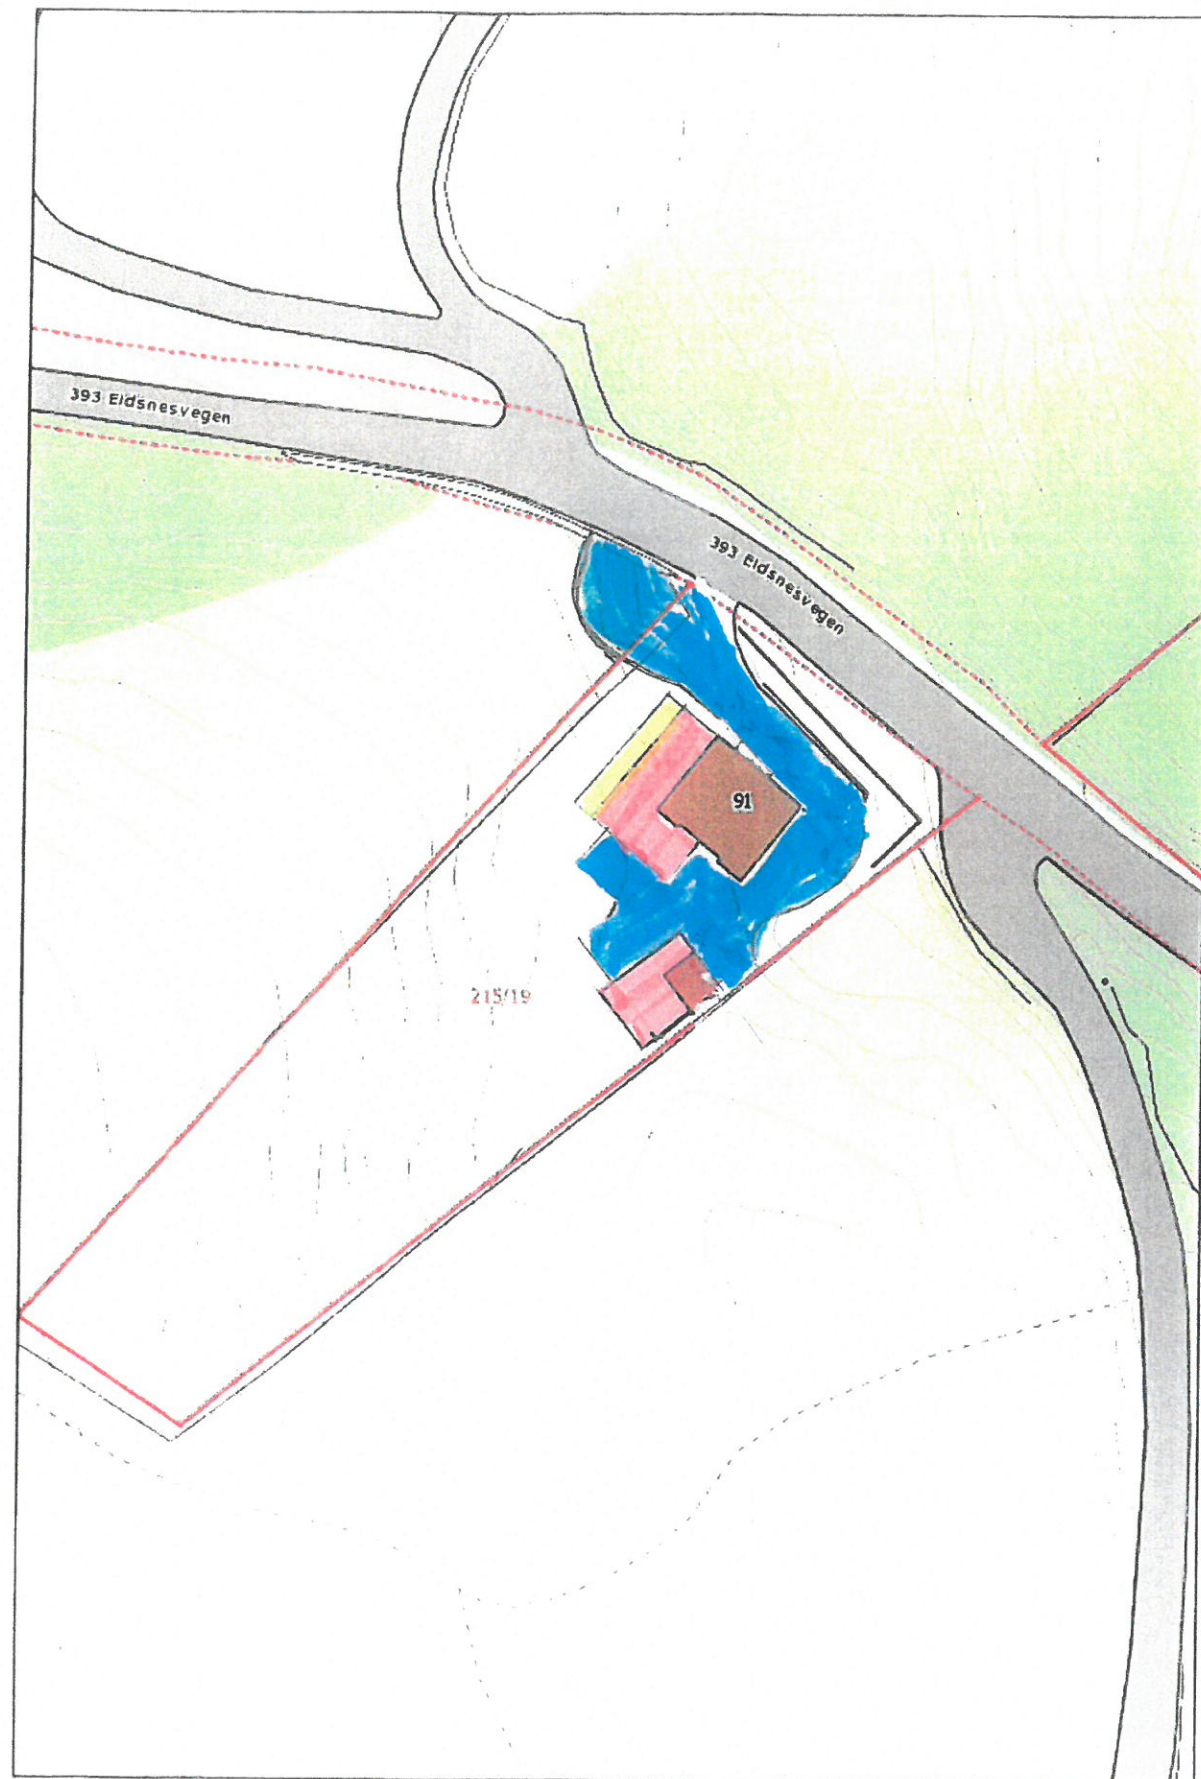

Målestokk 1:500