


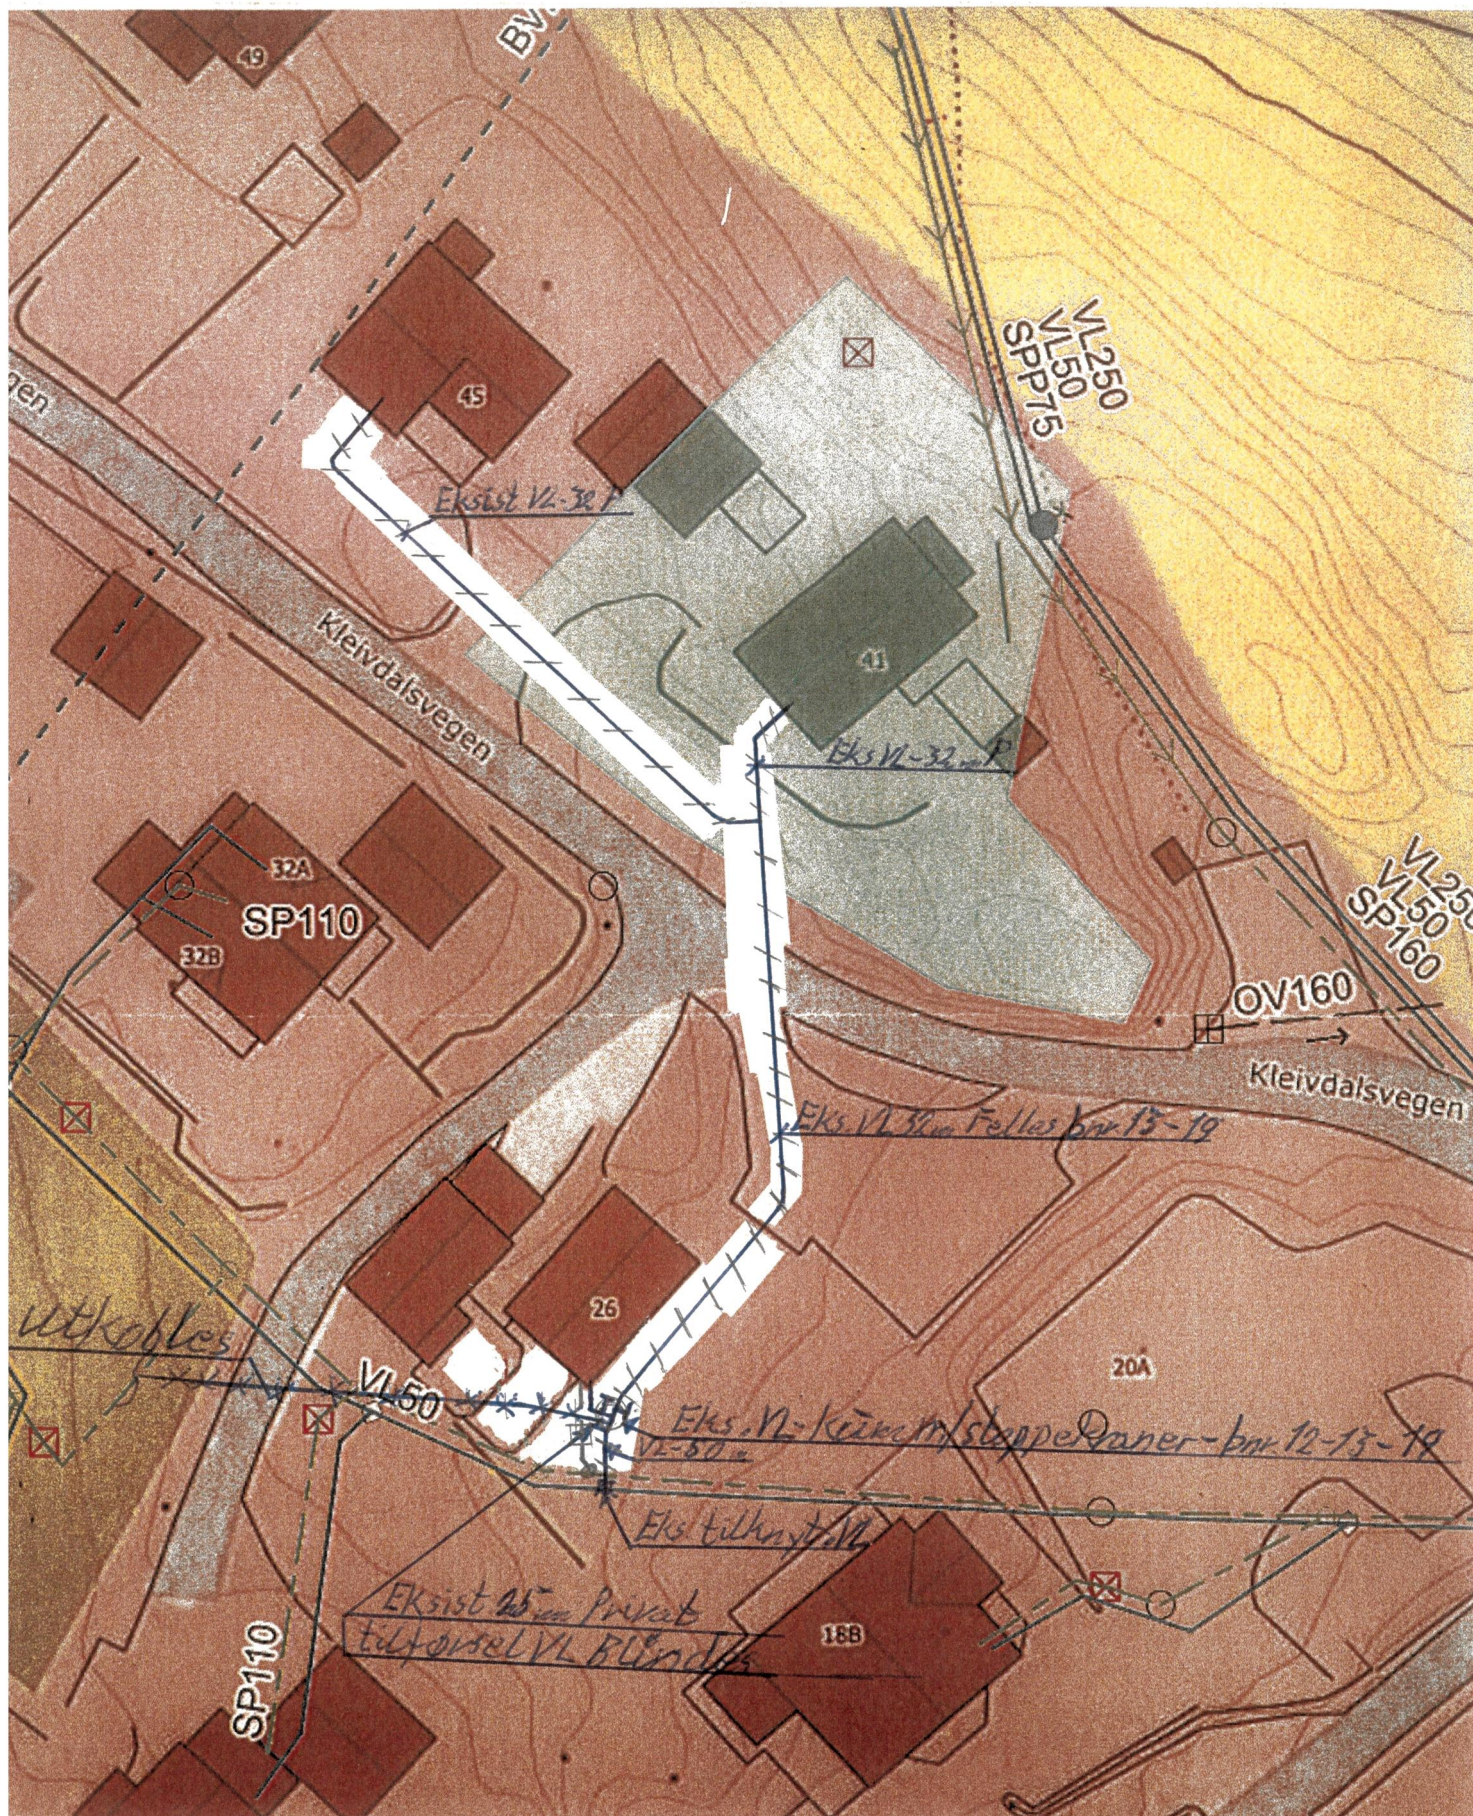

Situasjonsplan. Utv. Vassledninger. Private
Kleivdalsveg. 26-41-45 - Gbnr. 196/12-13-19
Håkon Rongved

Gbnr 196/
06.10.19



**LINDÅS RØR &
SANITÆR**
5914 IRDALSTU

TLF. 56 35 74 50
FAX 56 35 22 05