



Alternativ 2: Ridebane og luftegård Gbnr 195/4:

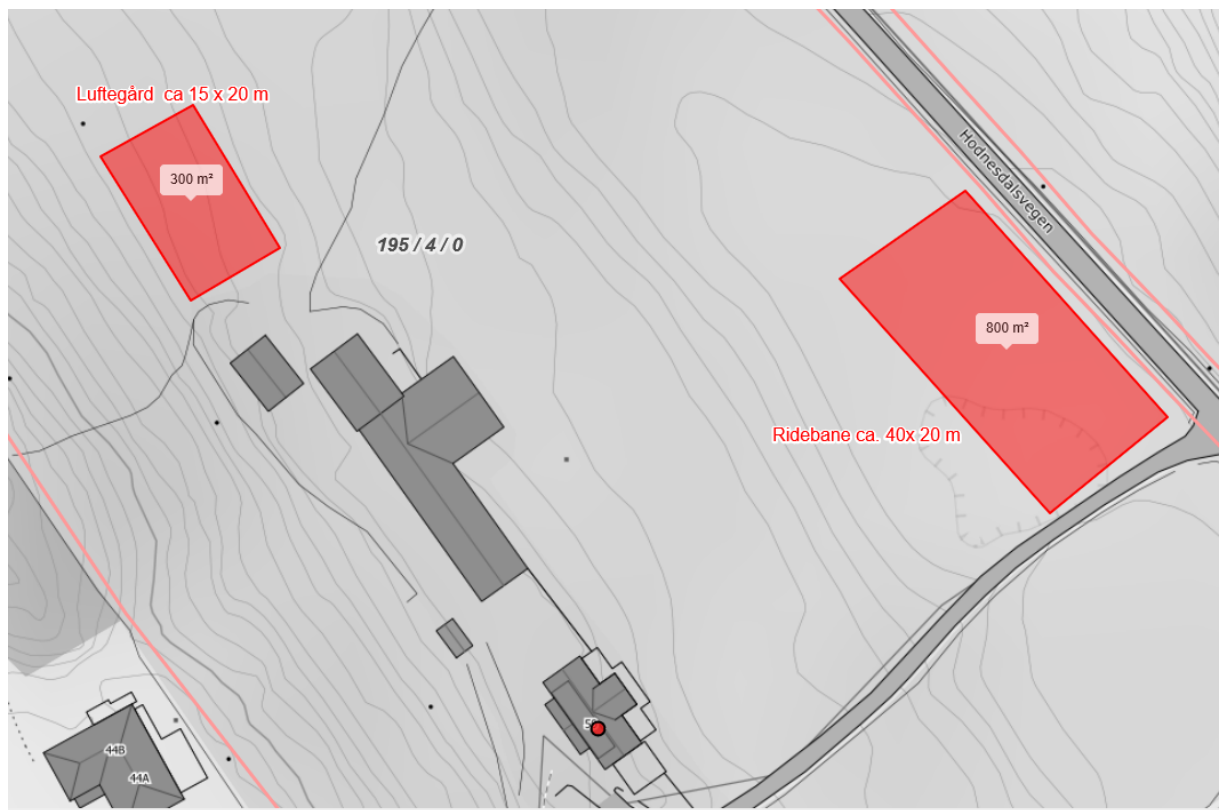

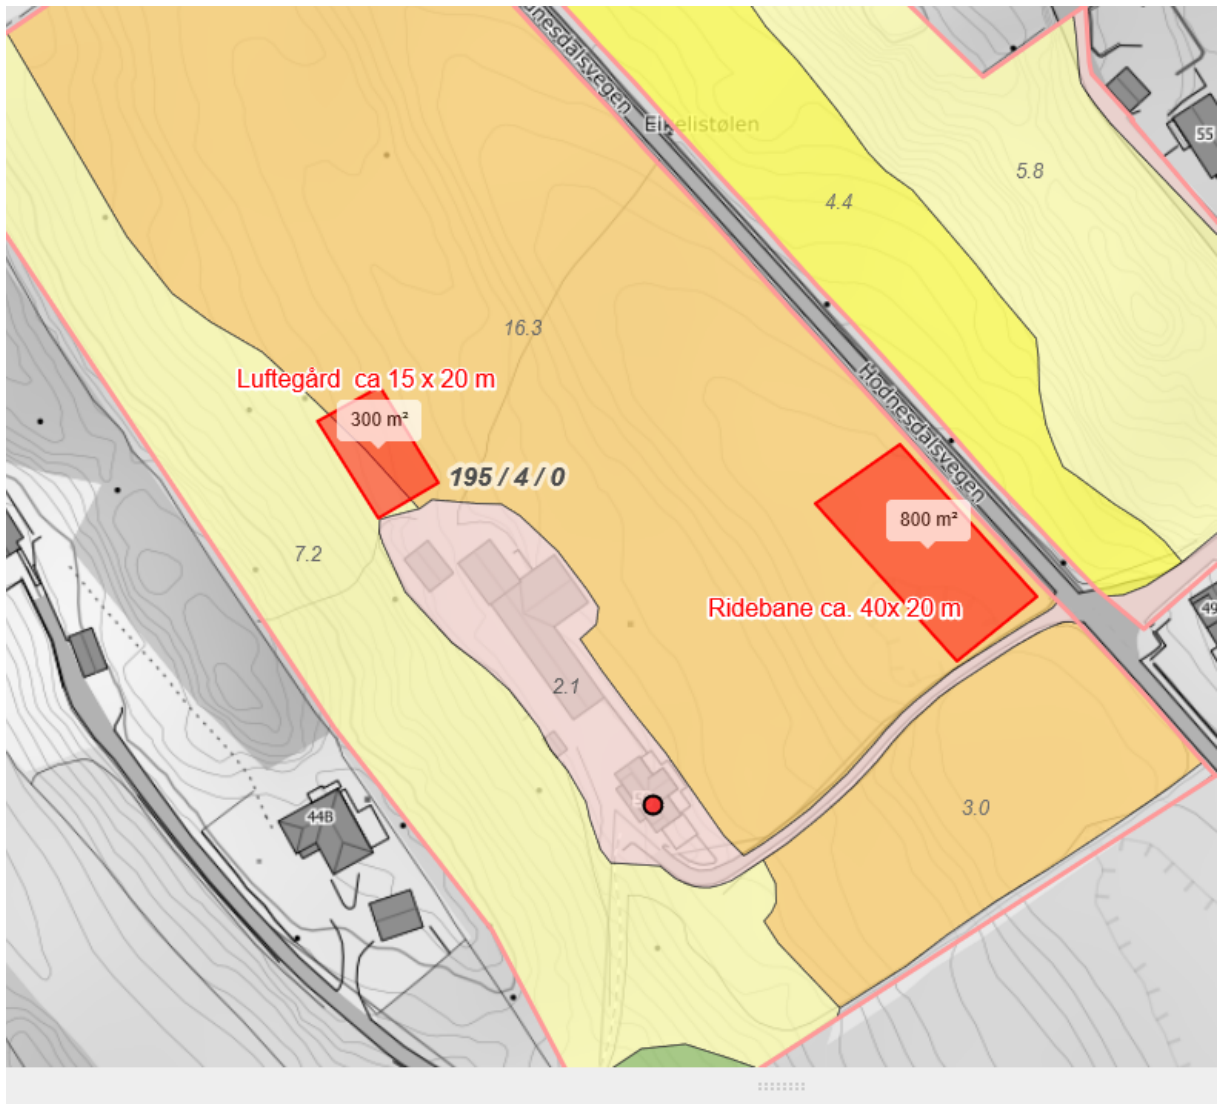



Fulldyrka jord	Overflatedyrka jord	Innmarksbeite	Produktiv skog	Annet markslag	
	19,4	4,4	21,2	32,8	3,1
	19,4	4,4	21,2	32,8	3,1