

Gbnr 137/203
Innmålt VA
28.11.2019
Målestokk 1:100
Medaas Oppmåling

VL63  
SP110  
OV160


VL50  
SP110  
OV160




B



Gbnr 137/203  
Innmålt VA  
28.11.2019  
Målestokk 1:100  
Medaas Oppmåling

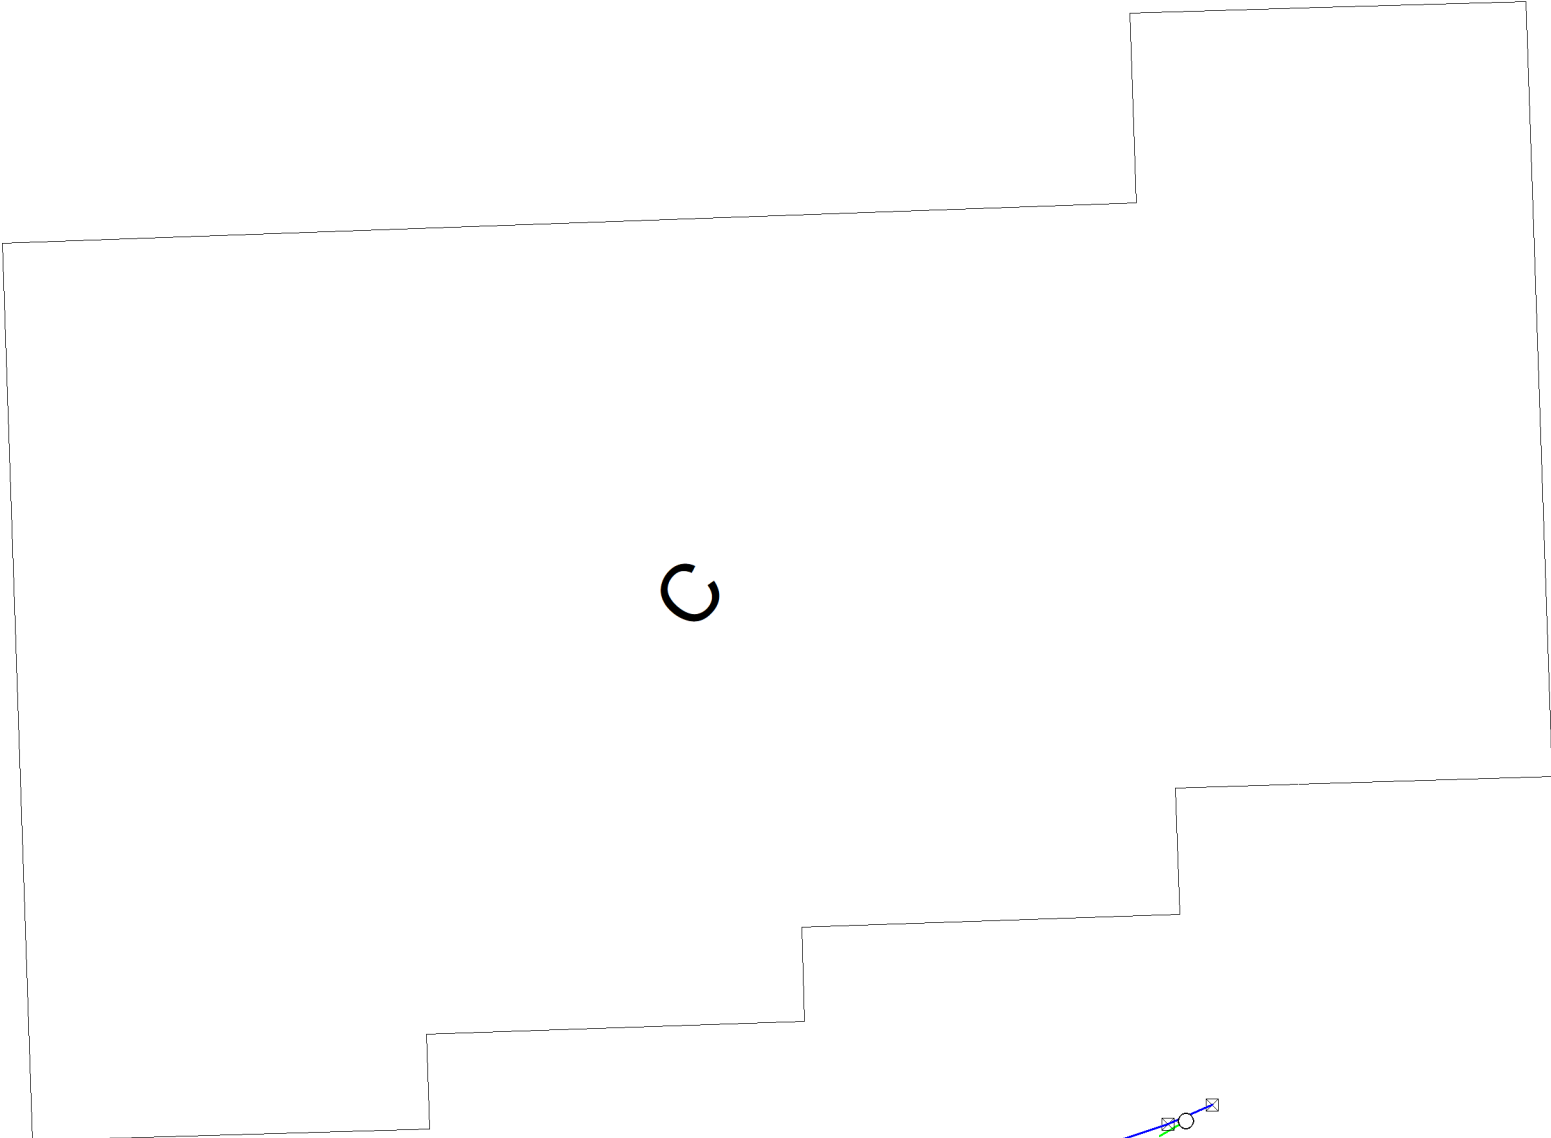


C

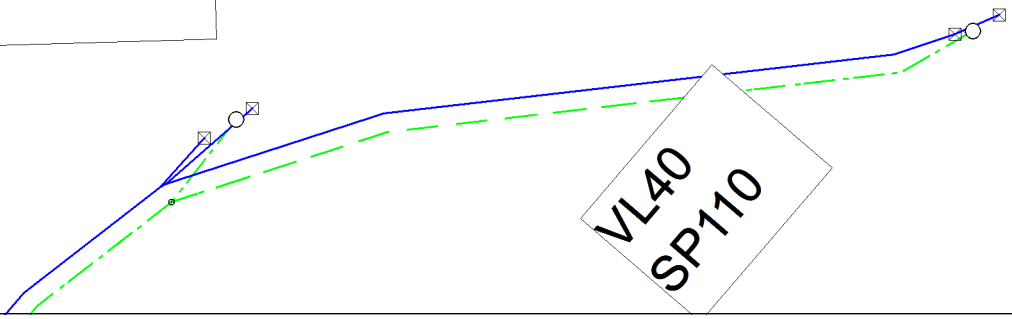

VL40  
SP110



Gbnr 137/203
Innmålt VA
28.11.2019
Målestokk 1:120
Medaas Oppmåling

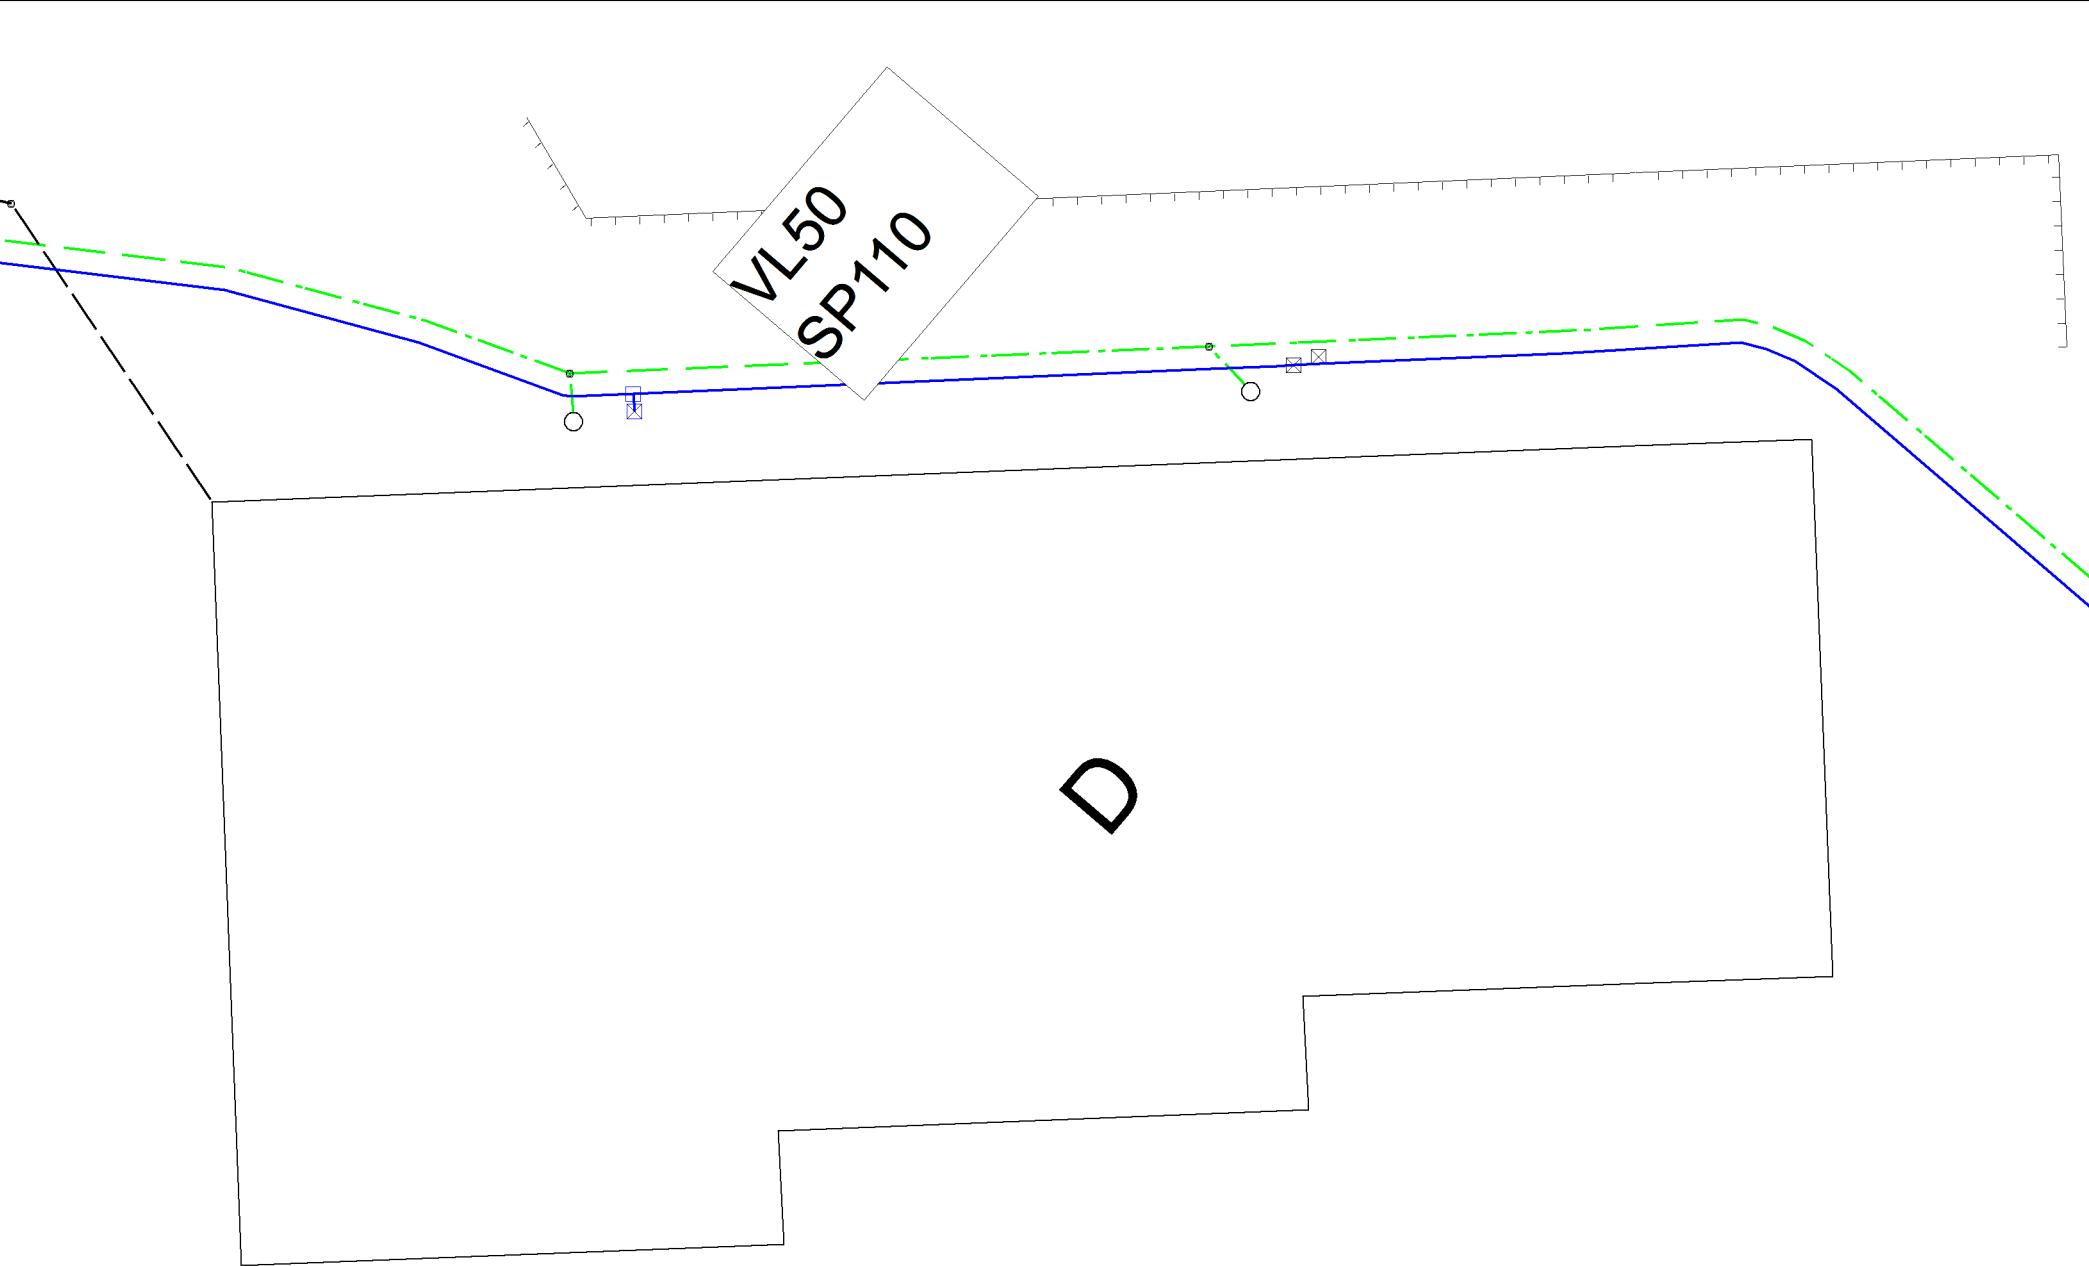

	Gbnr 137/203
	Innmålt VA
	28.11.2019
	Målestokk 1:100
Medaas Oppmåling	