


Snitt A-A

1 : 100

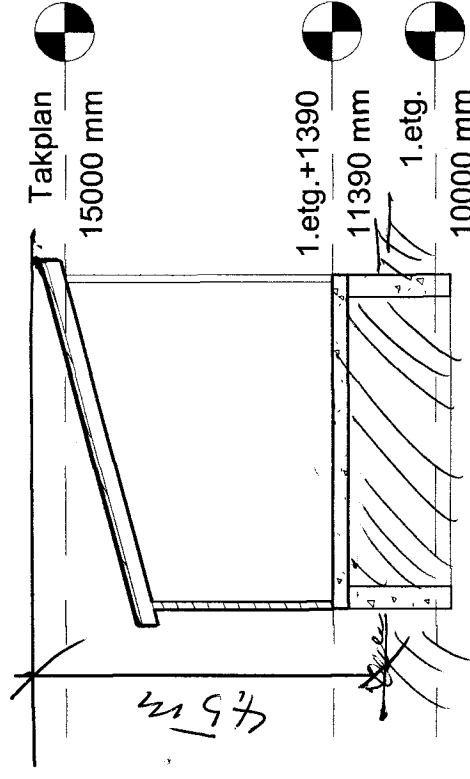

Snitt B-B

1 : 100

PROSJEKT		KVARVIK VDG. SKOLE		KVERNHUSMYRANE 2, 5914 ISDALSTØ	
TEGN.	MATERIALLAGER	MSL	1:100	DRG FORM	AIL3
PROSJ.NR.	2208	FAG	ARK 03	SIGN.	J.AKSE
		BYGGNR.	TEGN.NR.	DEL	
			E-Z		
		DATE	28.03.19	REV.	

