


E 288870

N 6716400

N 6716370

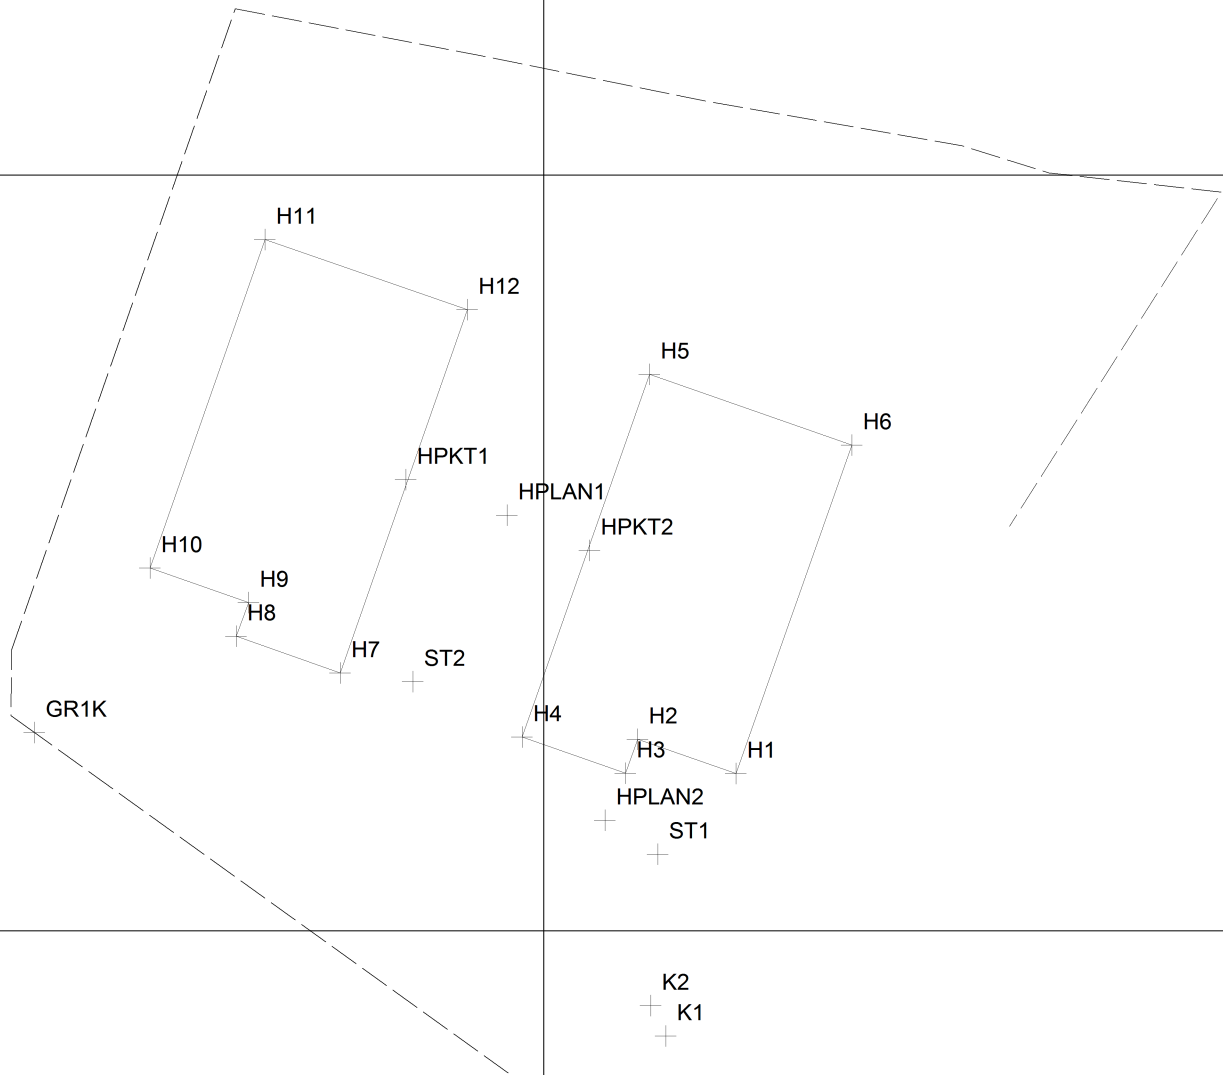

Gnr.10 bnr.160, Holmeknappen  
INNMAALT BYGG  
19.12.2013  
Målestokk 1:300  
Medaas Oppmåling