
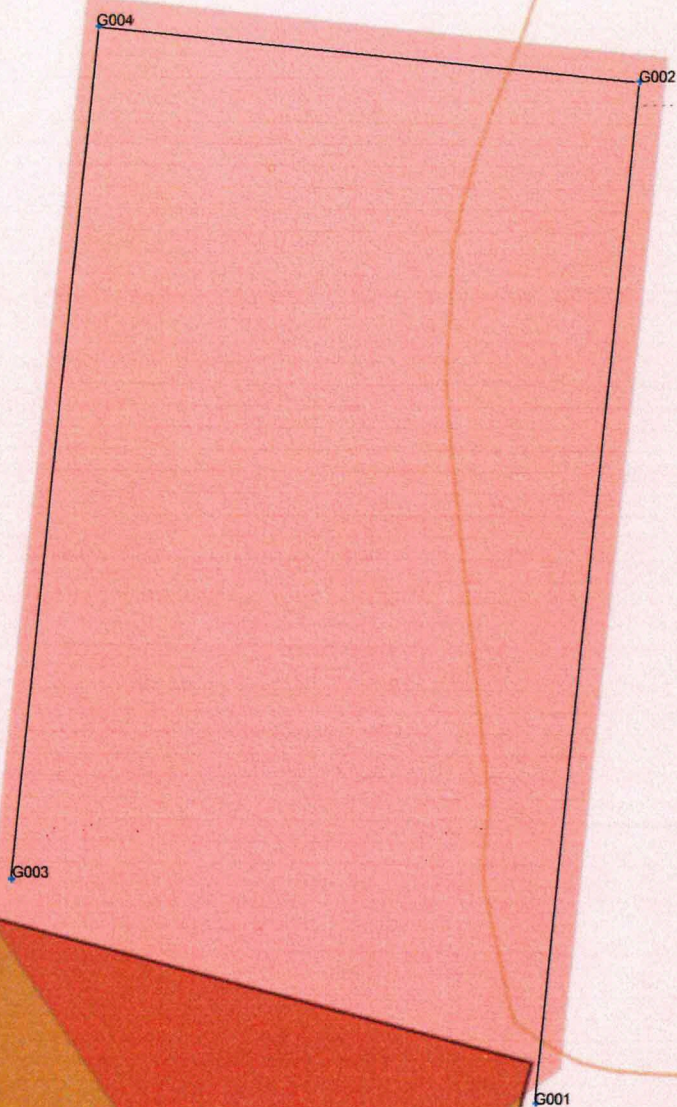


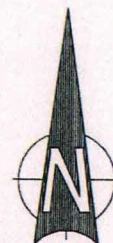

Øst	Nord	Høyde	Punkt nr
296227.543	6717628.023	24.166	G004
296226.361	6717615.407	24.143	G003
296235.629	6717627.265	24.166	G002
296234.213	6717612.155	24.137	G001

**Innmålt tilbygg i Strandvegen 1B
Alver kommune**

 **VESETH AS**
SURVEY & INSPECTION

Dato 06.01.2020	Konstr./tegnst	Godkjent	Målestokk 1:80		
Plantegning				Erstatning for:	Erstattet av:
				901	
Henvisning:		Beregning:			