


<p>Situasjonskart -</p>		<p>Dato: 04-03-2019</p>
		<p>Målestokk: 1:1 000</p>

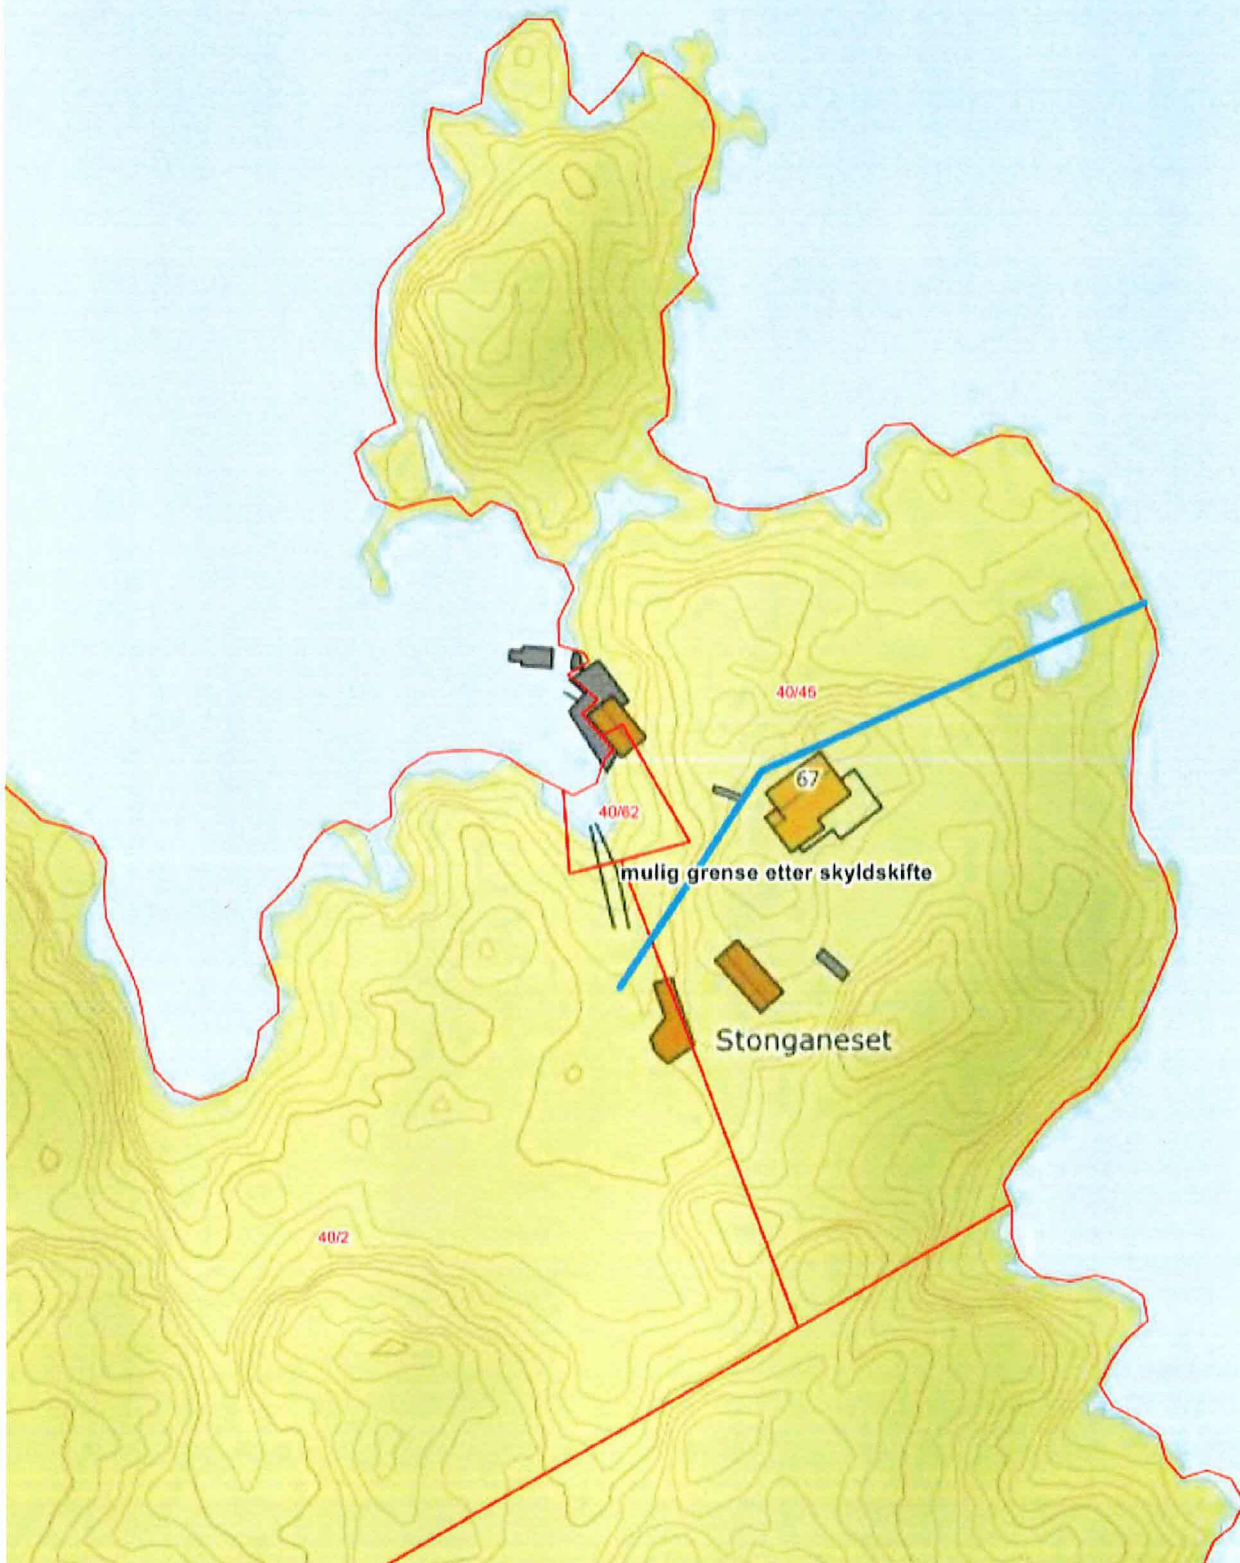


Situasjonskart -

Dato: 04-03-2019




Målestokk: 1:1 000




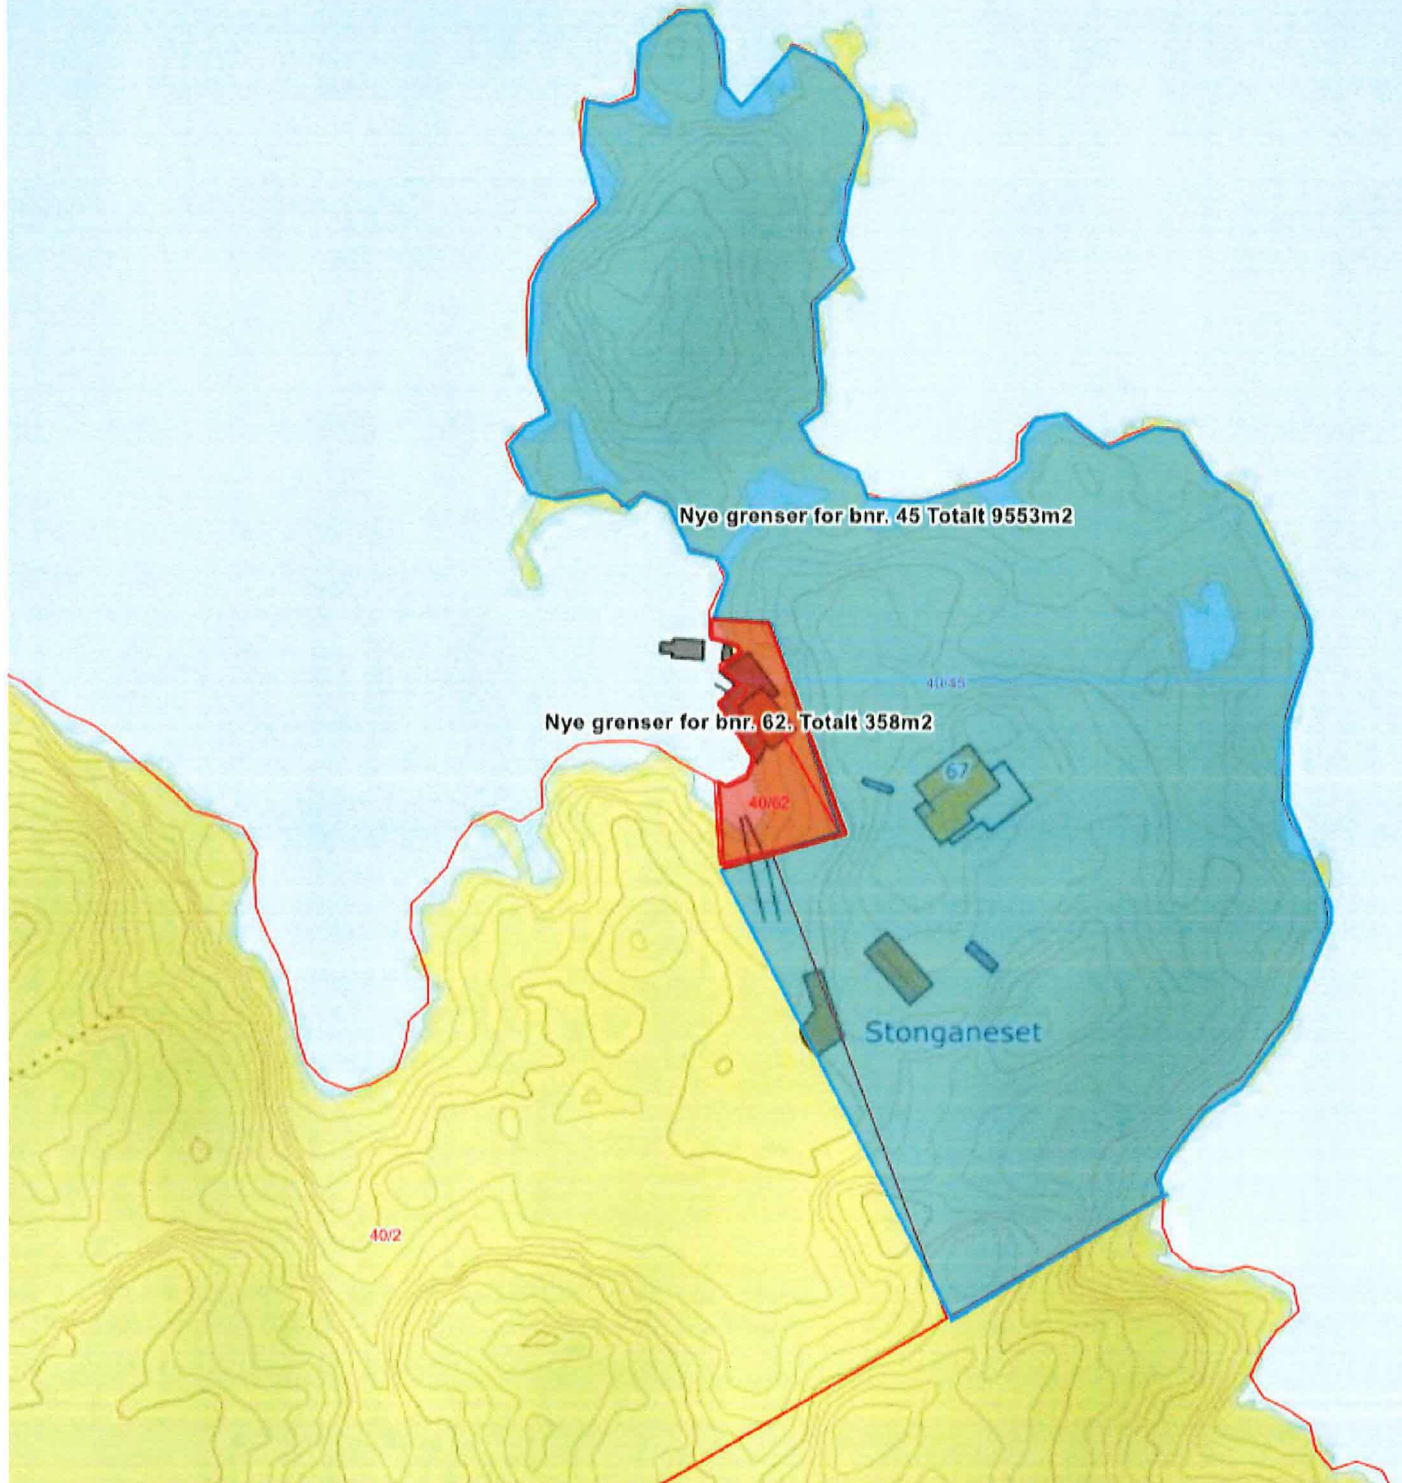

Situasjonskart -		Dato: 04-03-2019
		Målestokk: 1:1 000 ↔ 30m

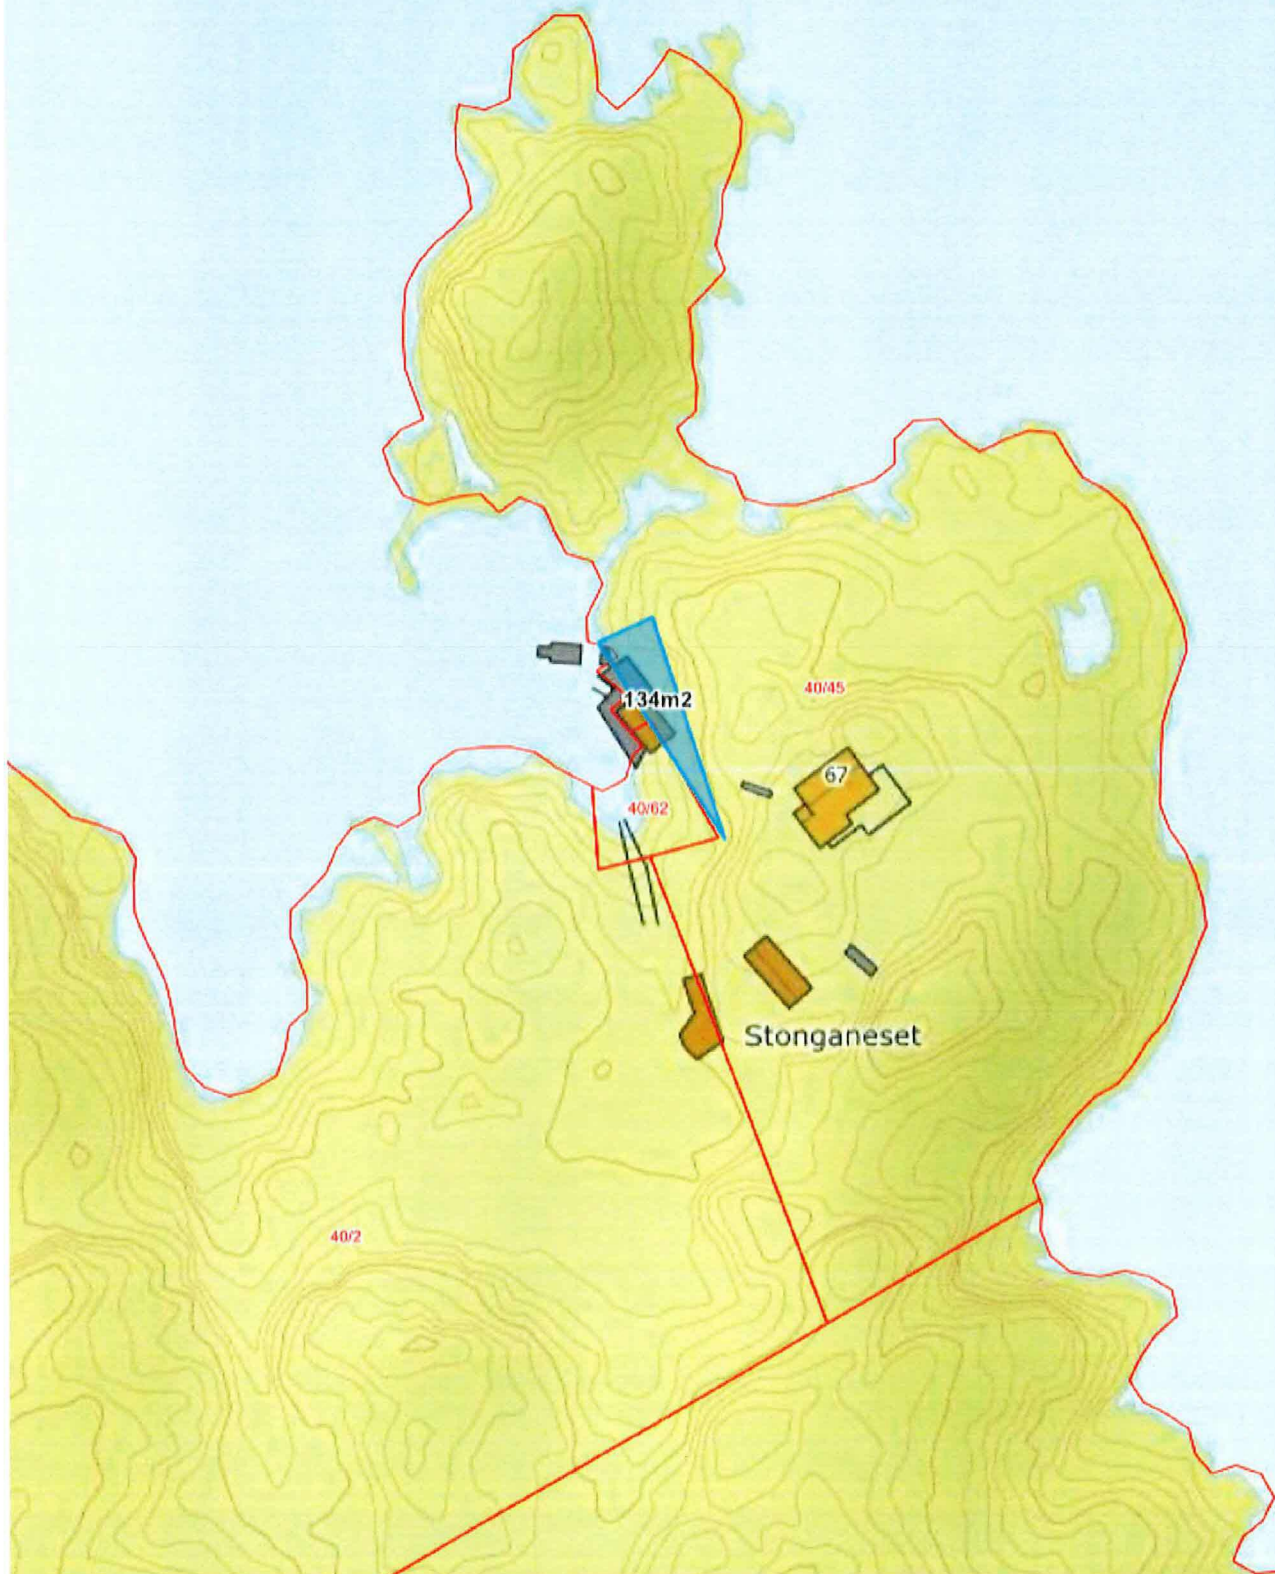

Situasjonskart -		Dato: 04-03-2019
		Målestokk: 1:1 000

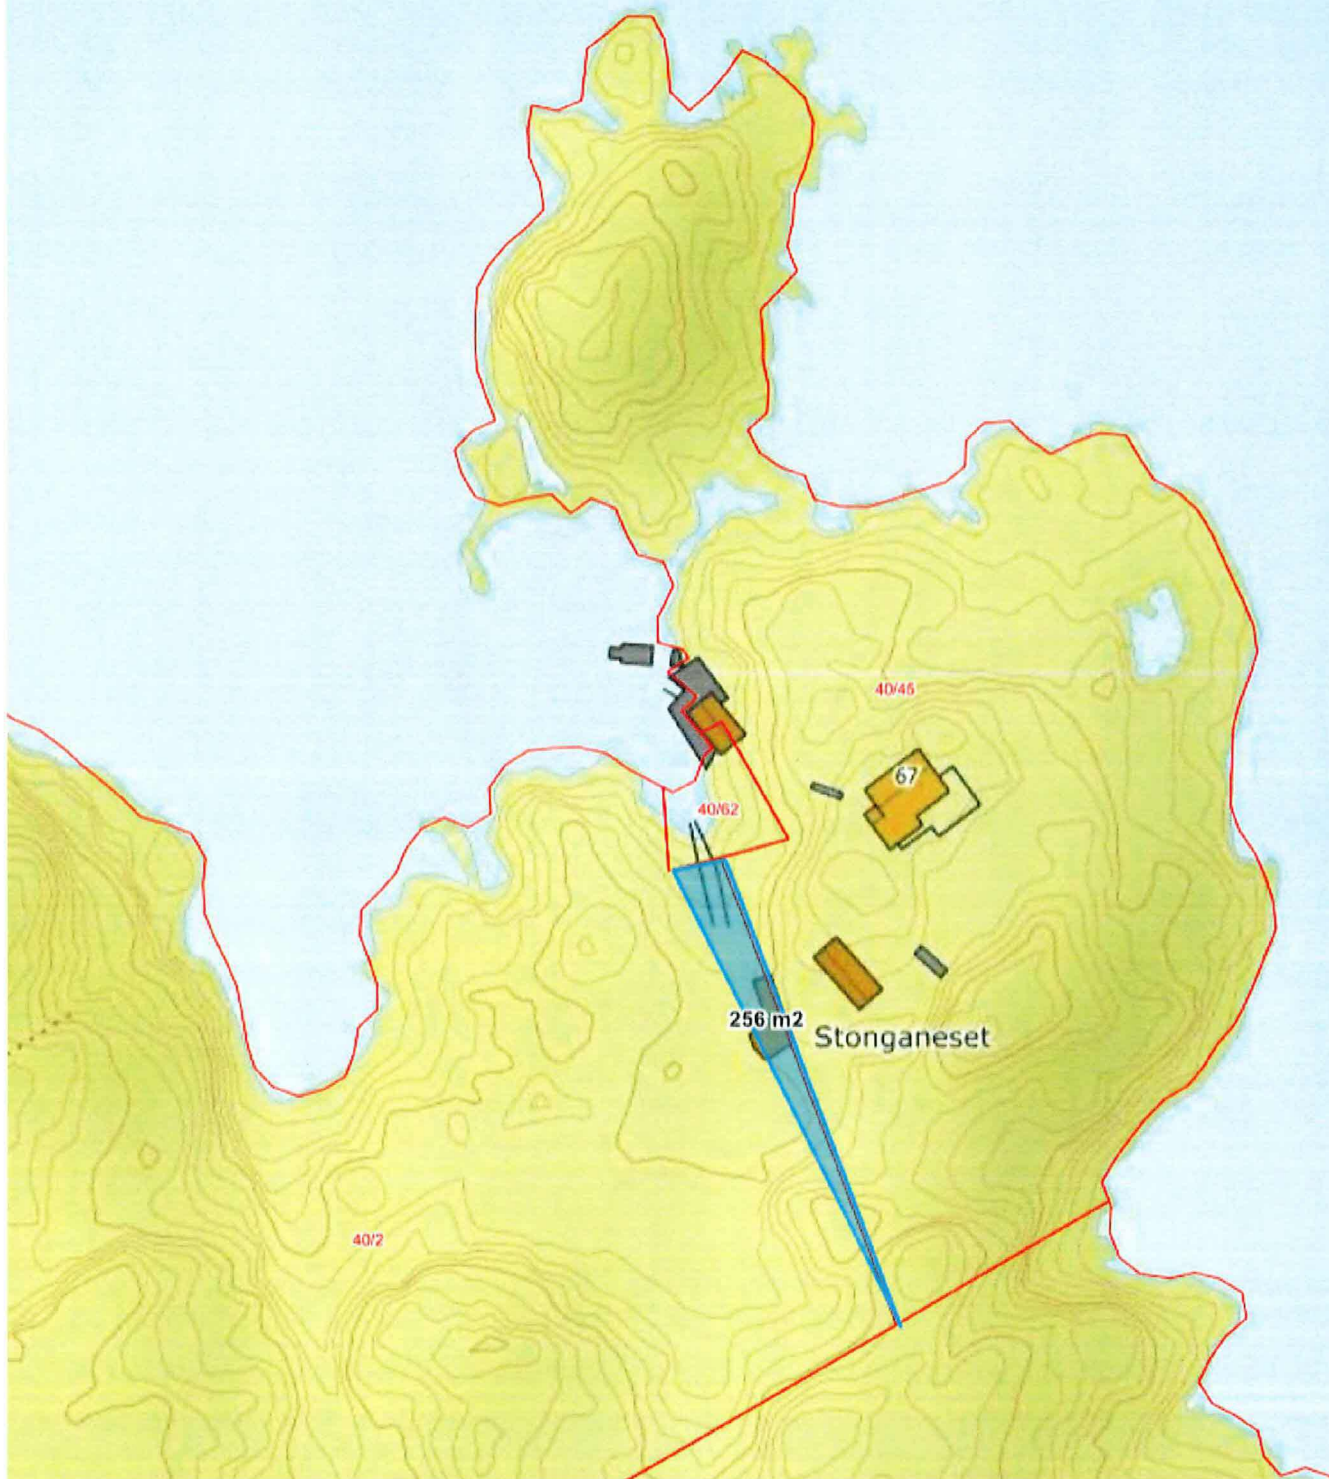

Situasjonskart -

Dato: 04-03-2019



Målestokk: 1:1 000

