




Lindås, gnr 195 bnr 171,
Data på innmålt grunnmur

06.06.2019

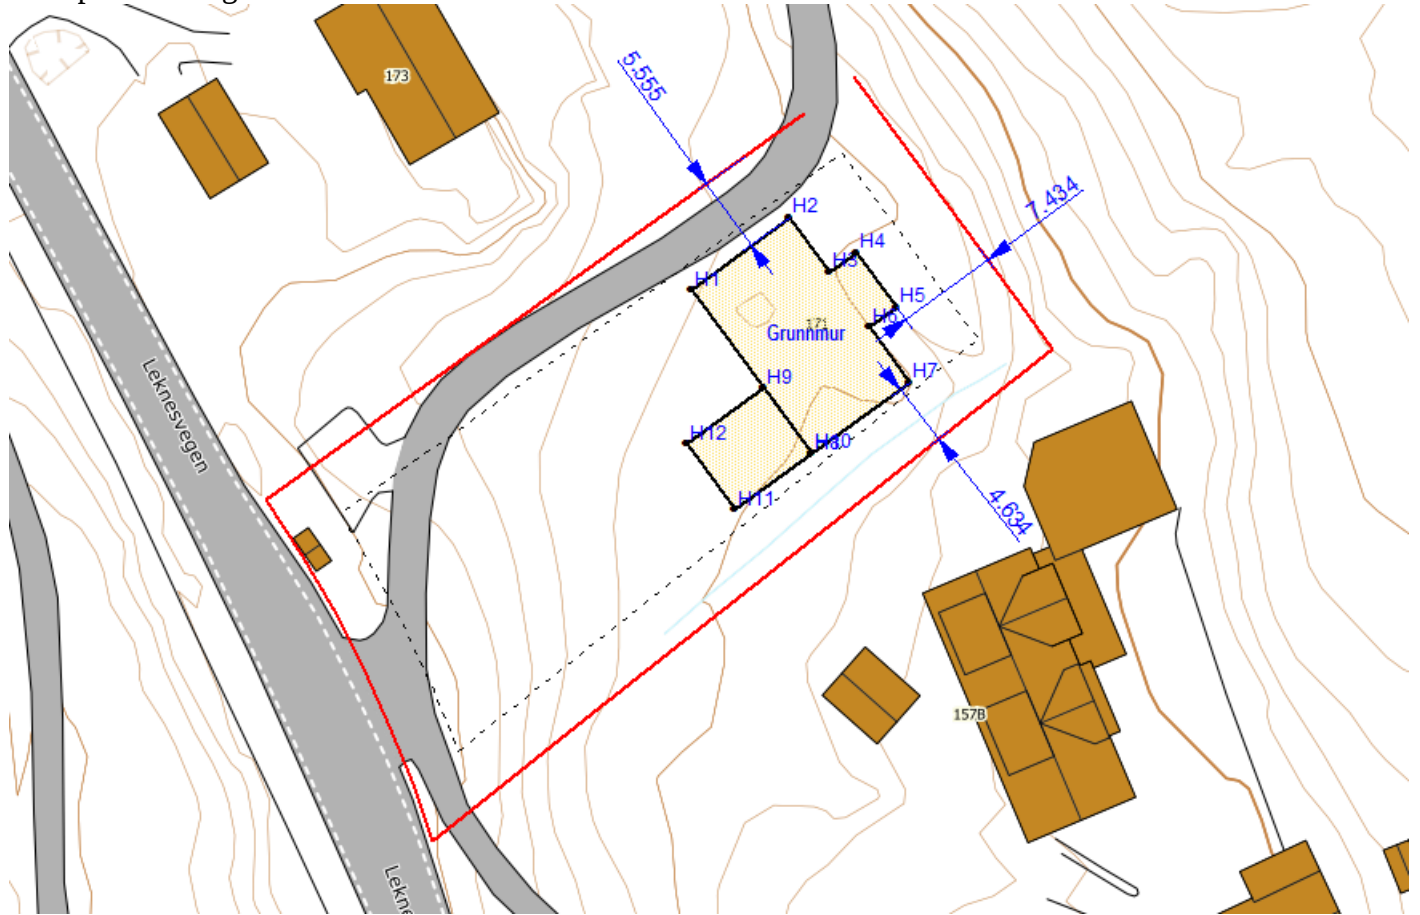

PunktID	N-koord.	Ø-koord.	Høyde
H1	6720979,68	301425,89	32,78
H2	6720984,99	301433,03	30,02
H3	6720980,99	301435,98	30,01
H4	6720982,44	301437,99	30,02
H5	6720978,41	301440,95	29,99
H6	6720976,92	301438,93	30,02
H7	6720972,90	301441,86	30,02
H8	6720967,66	301434,72	30,00
H9	6720972,50	301431,17	32,80
H10	6720967,69	301434,70	32,77
H11	6720963,55	301429,02	32,78
H12	6720968,35	301425,52	32,79