



Bod 15 m²

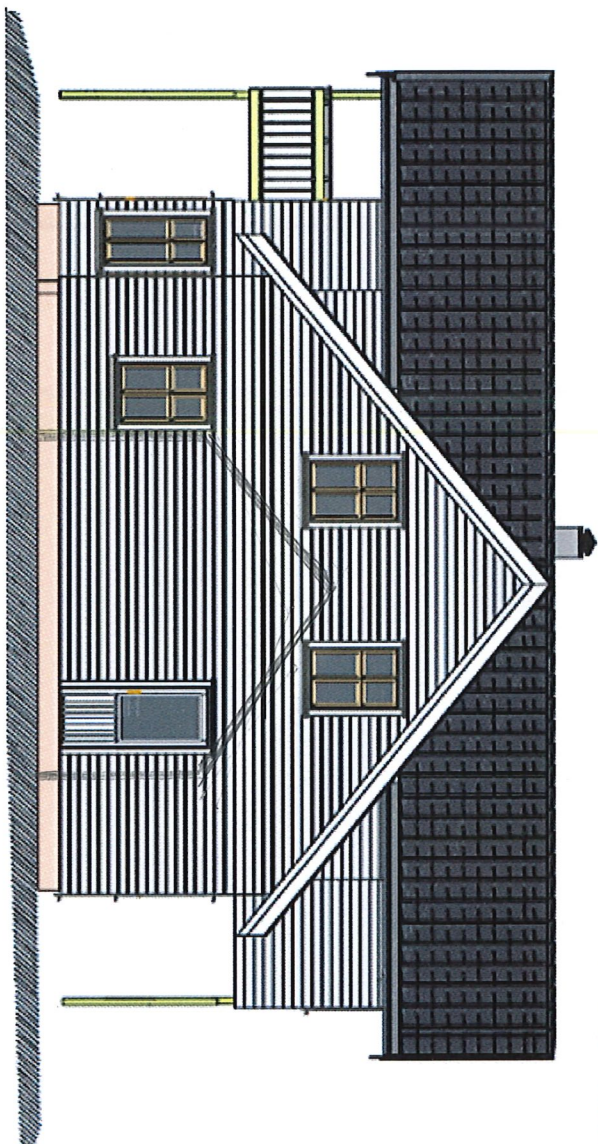


carport

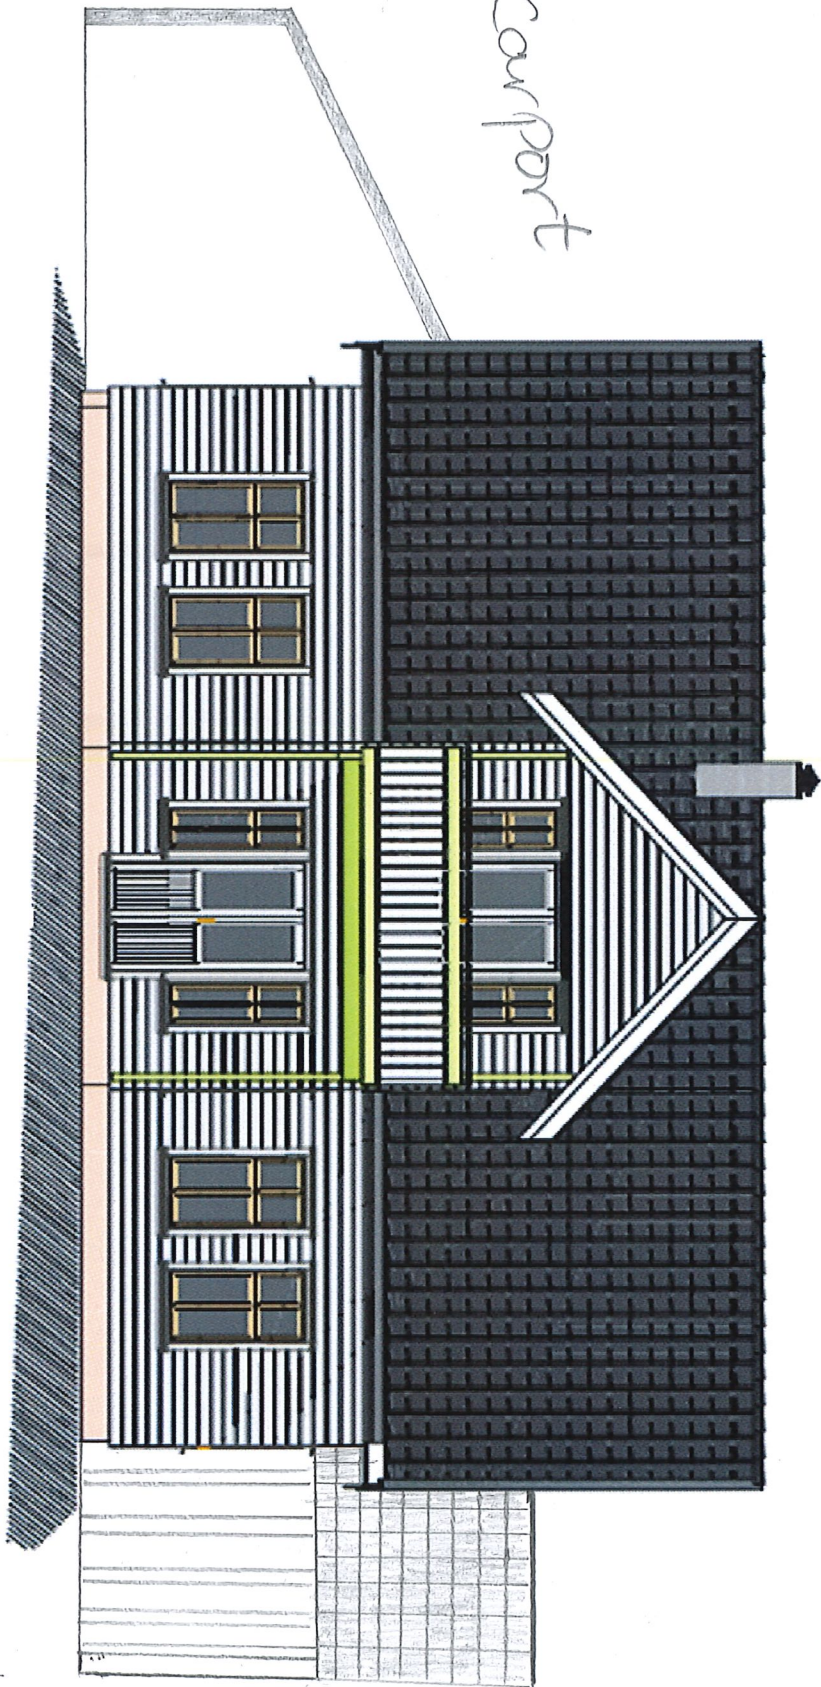

300 cm

Bod

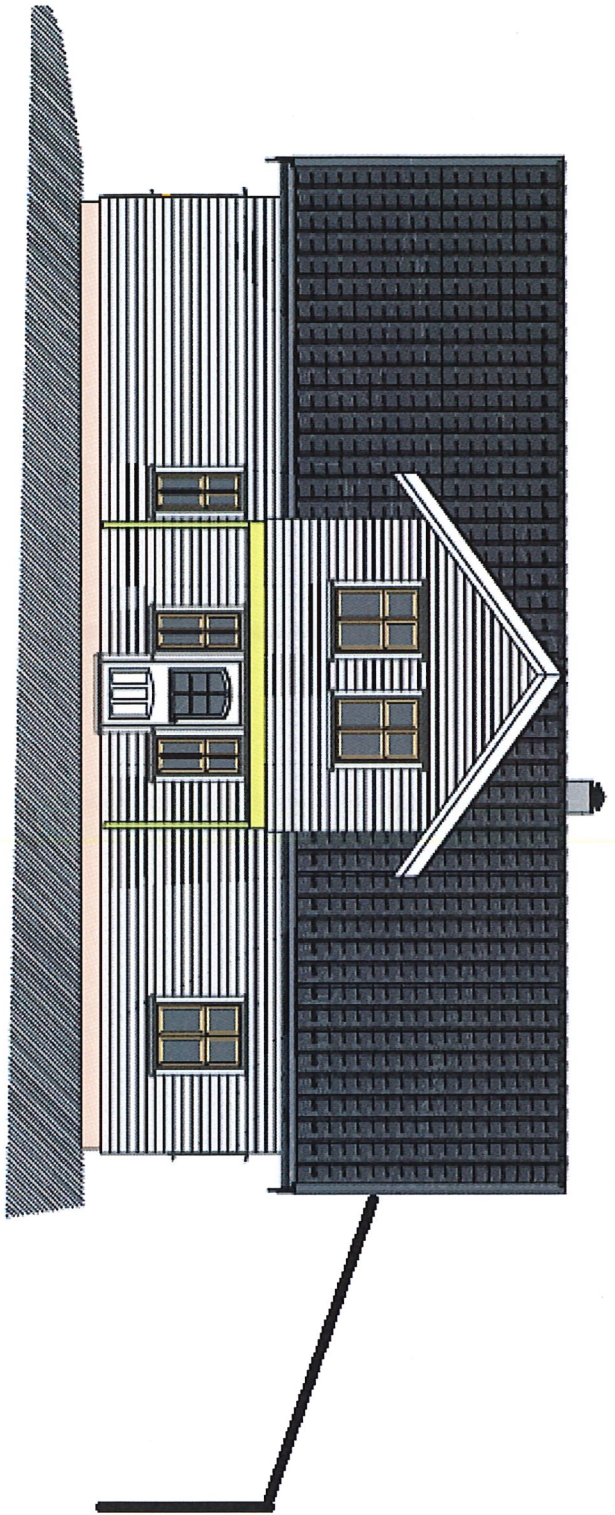

Carport 34m²

