


Tomt 787,9 m²


Hus: 127,3 m²
 Parkering: 54 m²
 Totalt: 181,3 m²

BYA 23 %
 Reg.best. 30 %

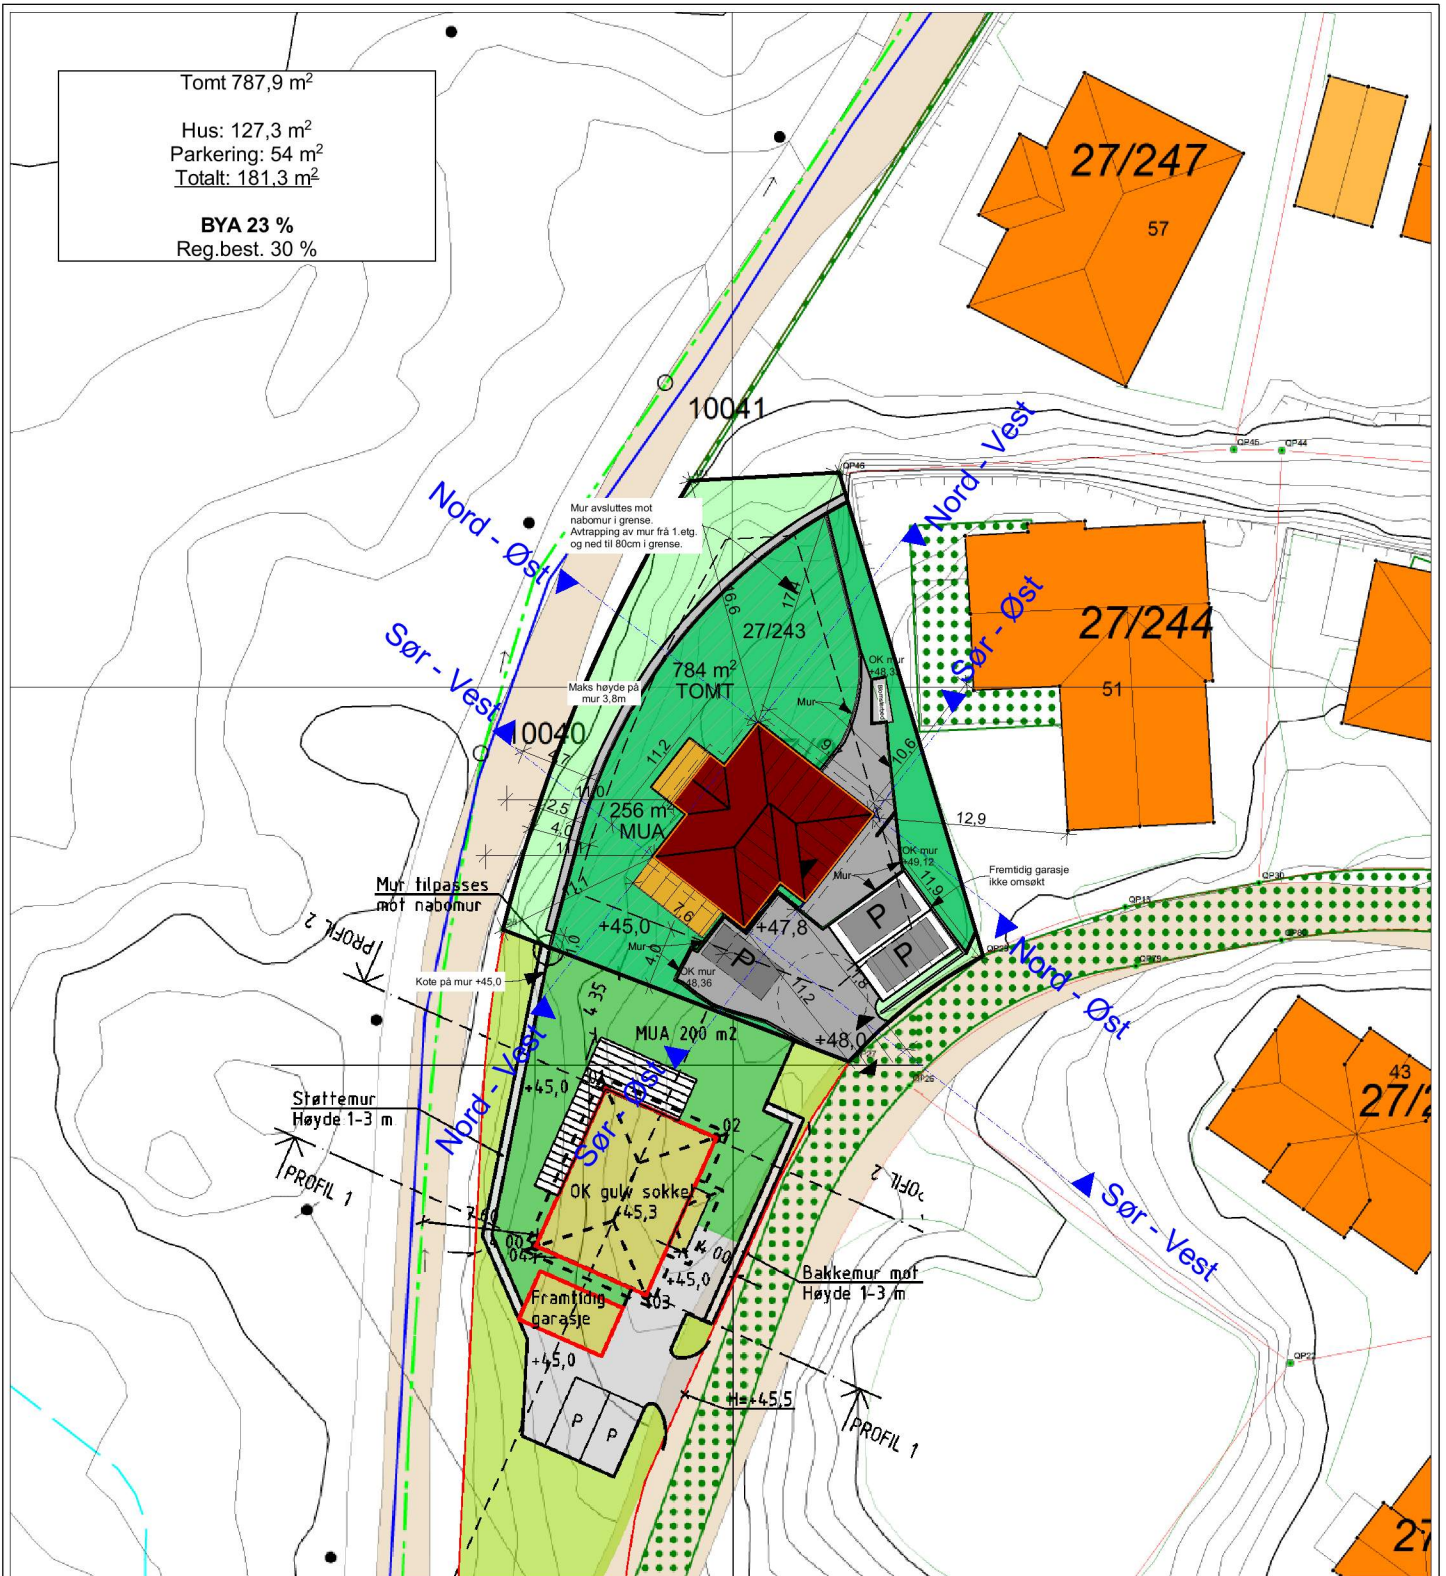

E	Murplassering på tomt etter måling med gps	KN	21.06.2019
D	Endret mur mot nabo- / langs tomtegrense	KN	12.02.2018
C	Rev. Byggemeldingstegninger	KN	20.10.2017
B	Byggemeldingstegninger	KN	27.06.2017
A	Kontraktstegninger	KN	10.05.2017

REV: BESKRIVELSE	SIGN.	REV. DATO
PROSJEKT: 1170316 Heiane 15B	MÅL: 1:500	DATO: 29.05.2017
ILTAKSHAVER: Kay Zimmermann	TEGN: KN	Gnr./Bnr: 27/243
BYGGEPLASS: Heiane 15B, 5918 Frekhaug	ARKITEKT: Meland	Kommune:
TEGN. TYPE: Situasjonsplan A4 - Stående	HUSTYPE: Situasjonsplan	

-  Uteoppholdsareal
-  Eksisterende kotelinjer
-  Nye kotelinjer



PROSJEKT 1170316	FORMAT A4	TEGN.NR.
---------------------	--------------	----------