


294517 X 6740°

X 6740°
Y 2945

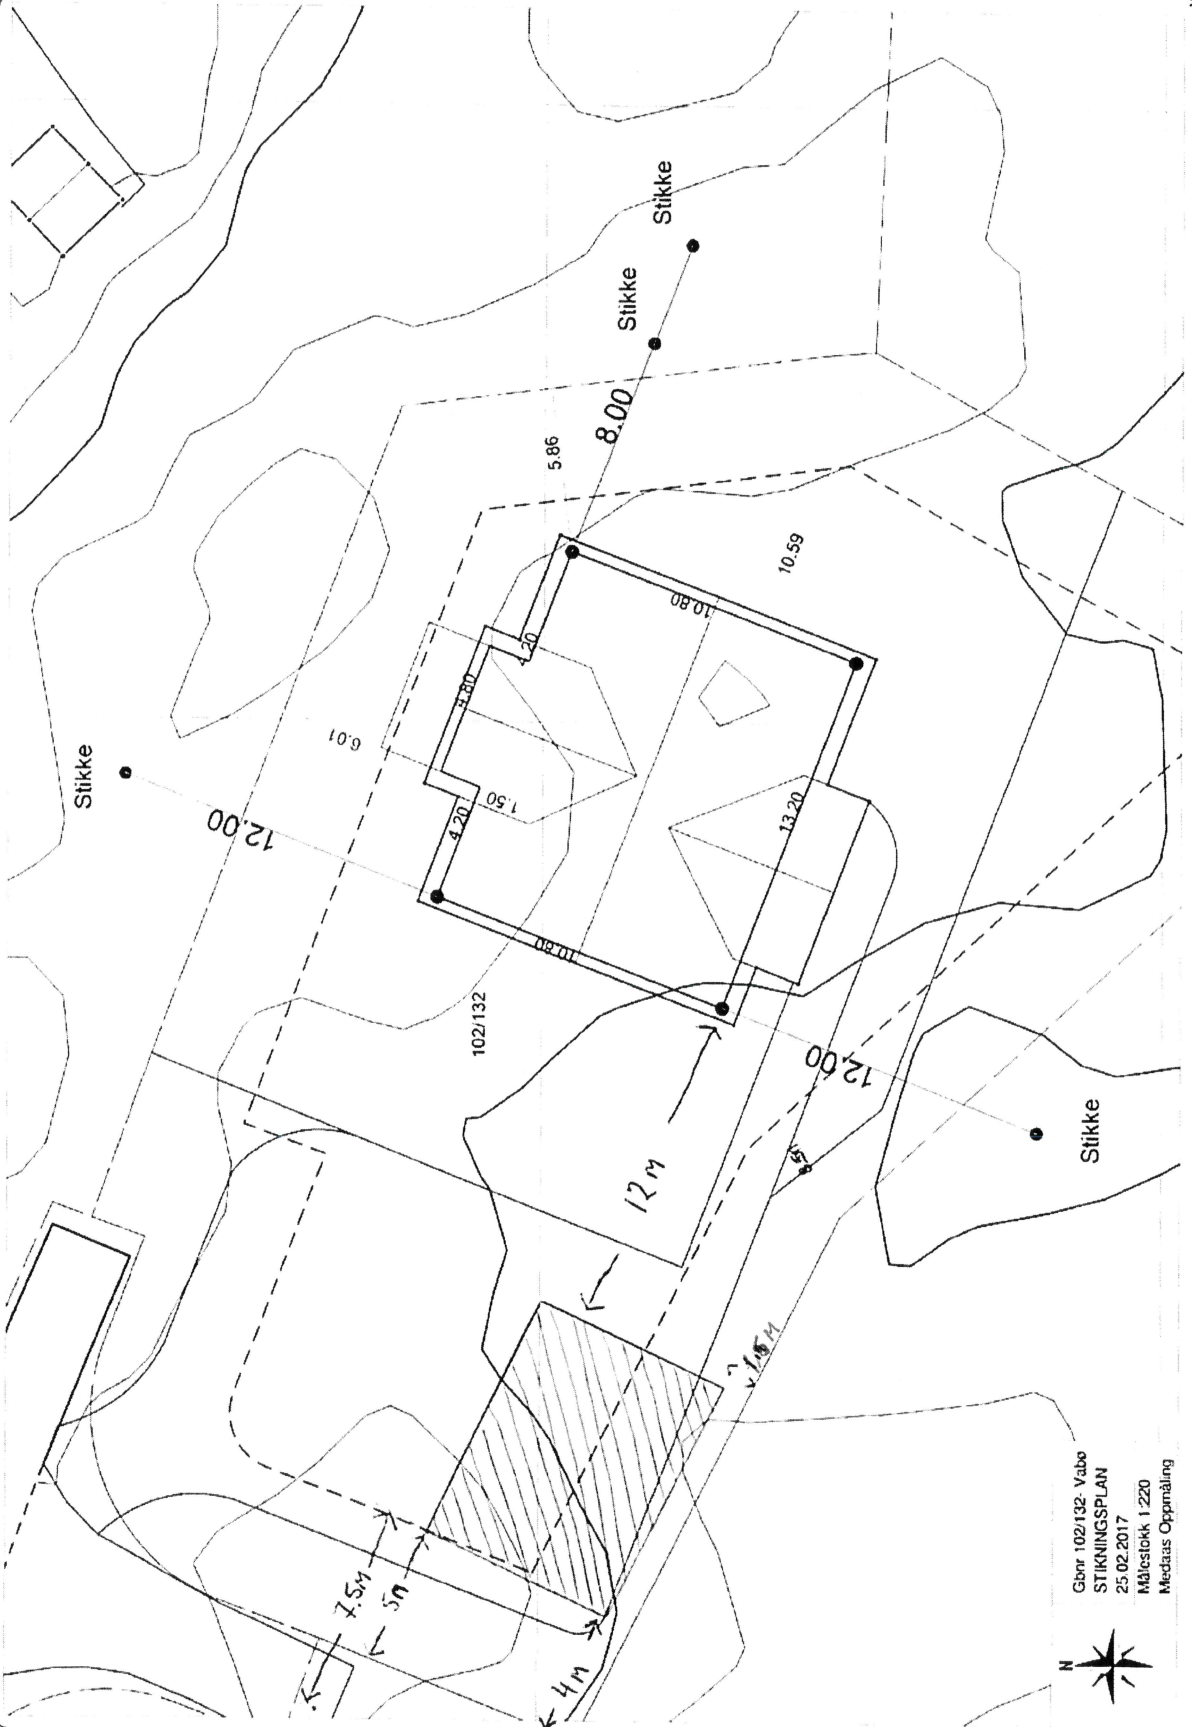

294456 740137

2944 74009

Gbnr 102/132 Våbo
STIKKINGSPLAN
25.02.2017
Målstokk 1:220
Medias Oppmåling

