




Radøy, gnr 77 bnr 89,  
Data på innmålt grunnmur

27.08.2019

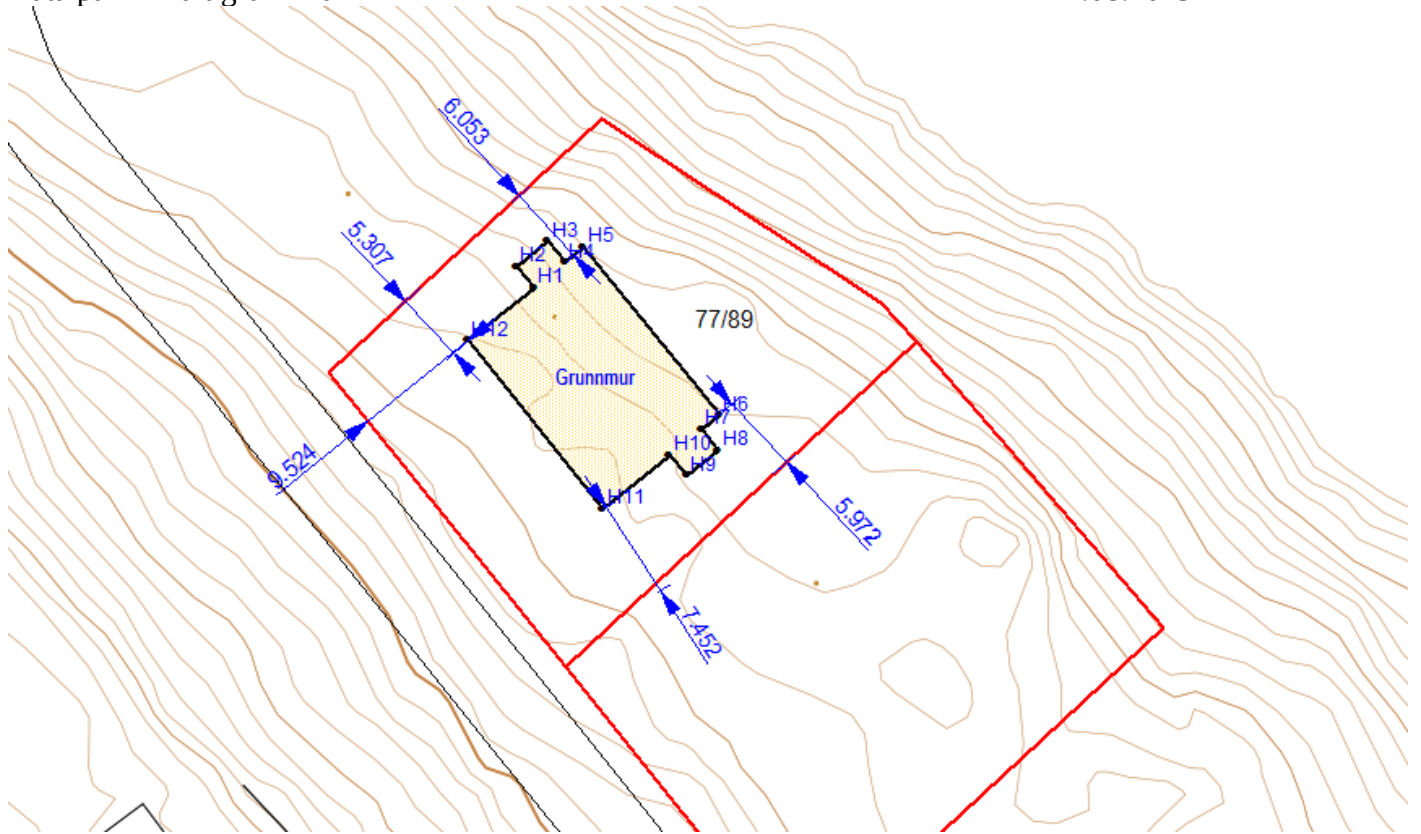

PunktID	N-koord.	Ø-koord.	Høyde
H1	6726748,29	290913,20	17,45
H2	6726749,84	290911,92	17,44
H3	6726751,73	290914,25	17,46
H4	6726750,16	290915,50	17,48
H5	6726751,29	290916,89	17,50
H6	6726738,85	290926,95	17,48
H7	6726737,78	290925,63	17,48
H8	6726736,23	290926,89	17,47
H9	6726734,33	290924,57	17,48
H10	6726735,89	290923,31	17,47
H11	6726731,89	290918,35	19,87
H12	6726744,35	290908,31	19,87