




Radøy, gnr 23 bnr 11,
Data på innmålt grunnmur

06.06.2019

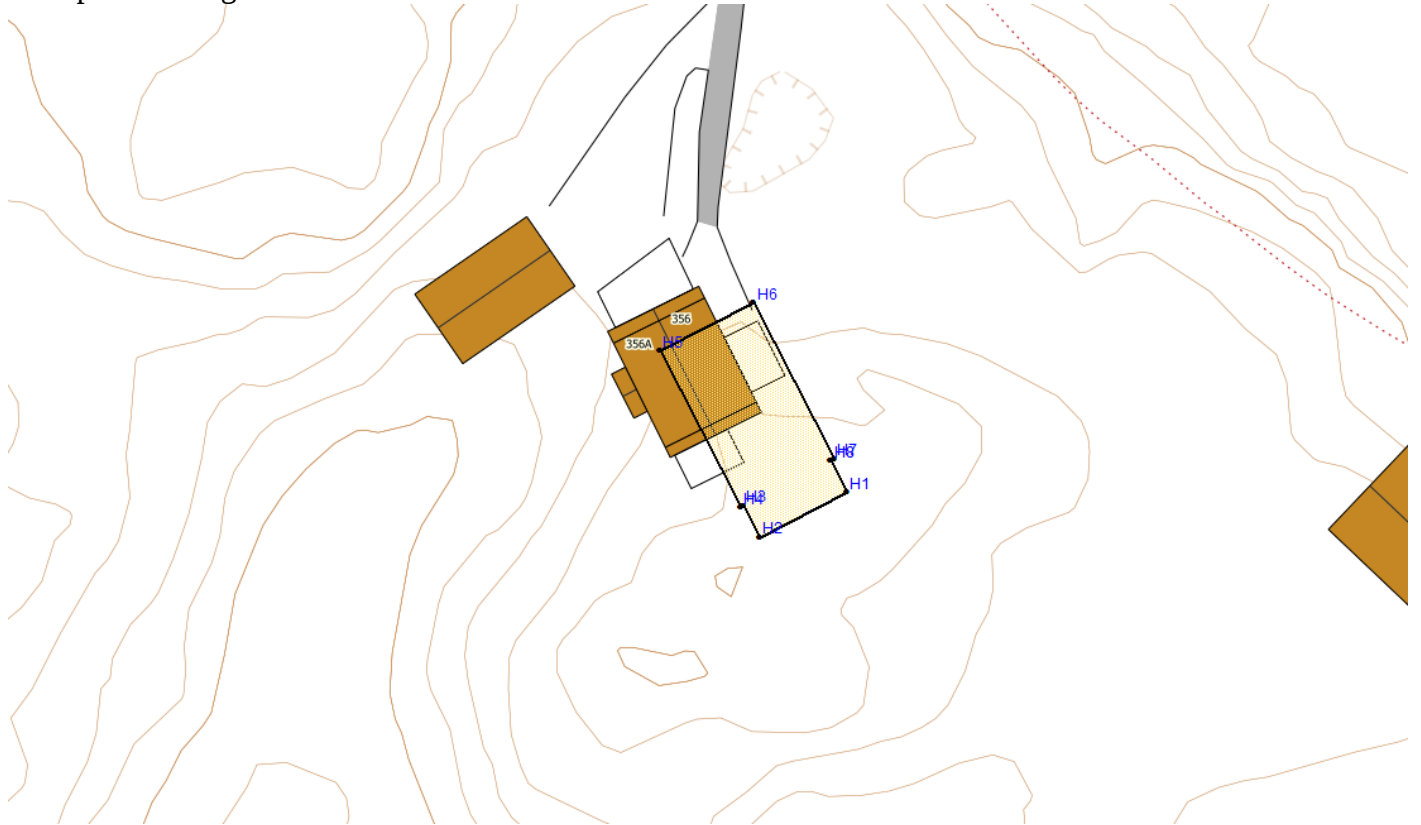

PunktID	N-koord.	Ø-koord.	Høyde
H1	6737298,56	275738,50	14,27
H2	6737294,73	275731,03	14,27
H3	6737297,38	275729,65	14,27
H4	6737297,26	275729,40	14,27
H5	6737310,59	275722,54	14,28
H6	6737314,72	275730,55	14,28
H7	6737301,38	275737,39	14,28
H8	6737301,24	275737,13	14,29