



C

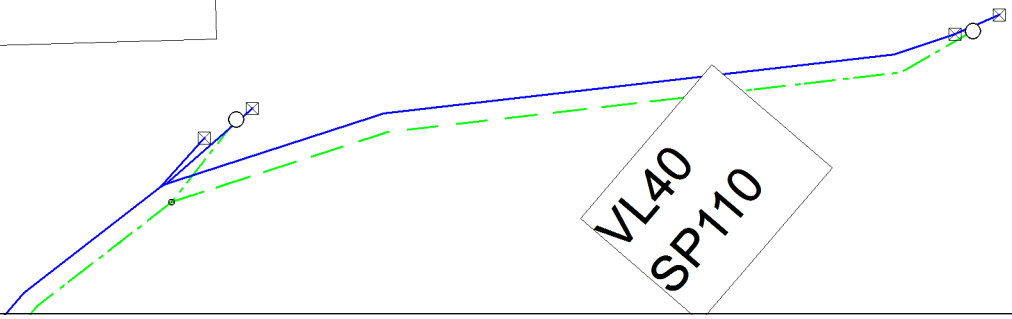

VL40
SP110



Gbnr 137/203
Innmålt VA
28.11.2019
Målestokk 1:120
Medaas Oppmåling

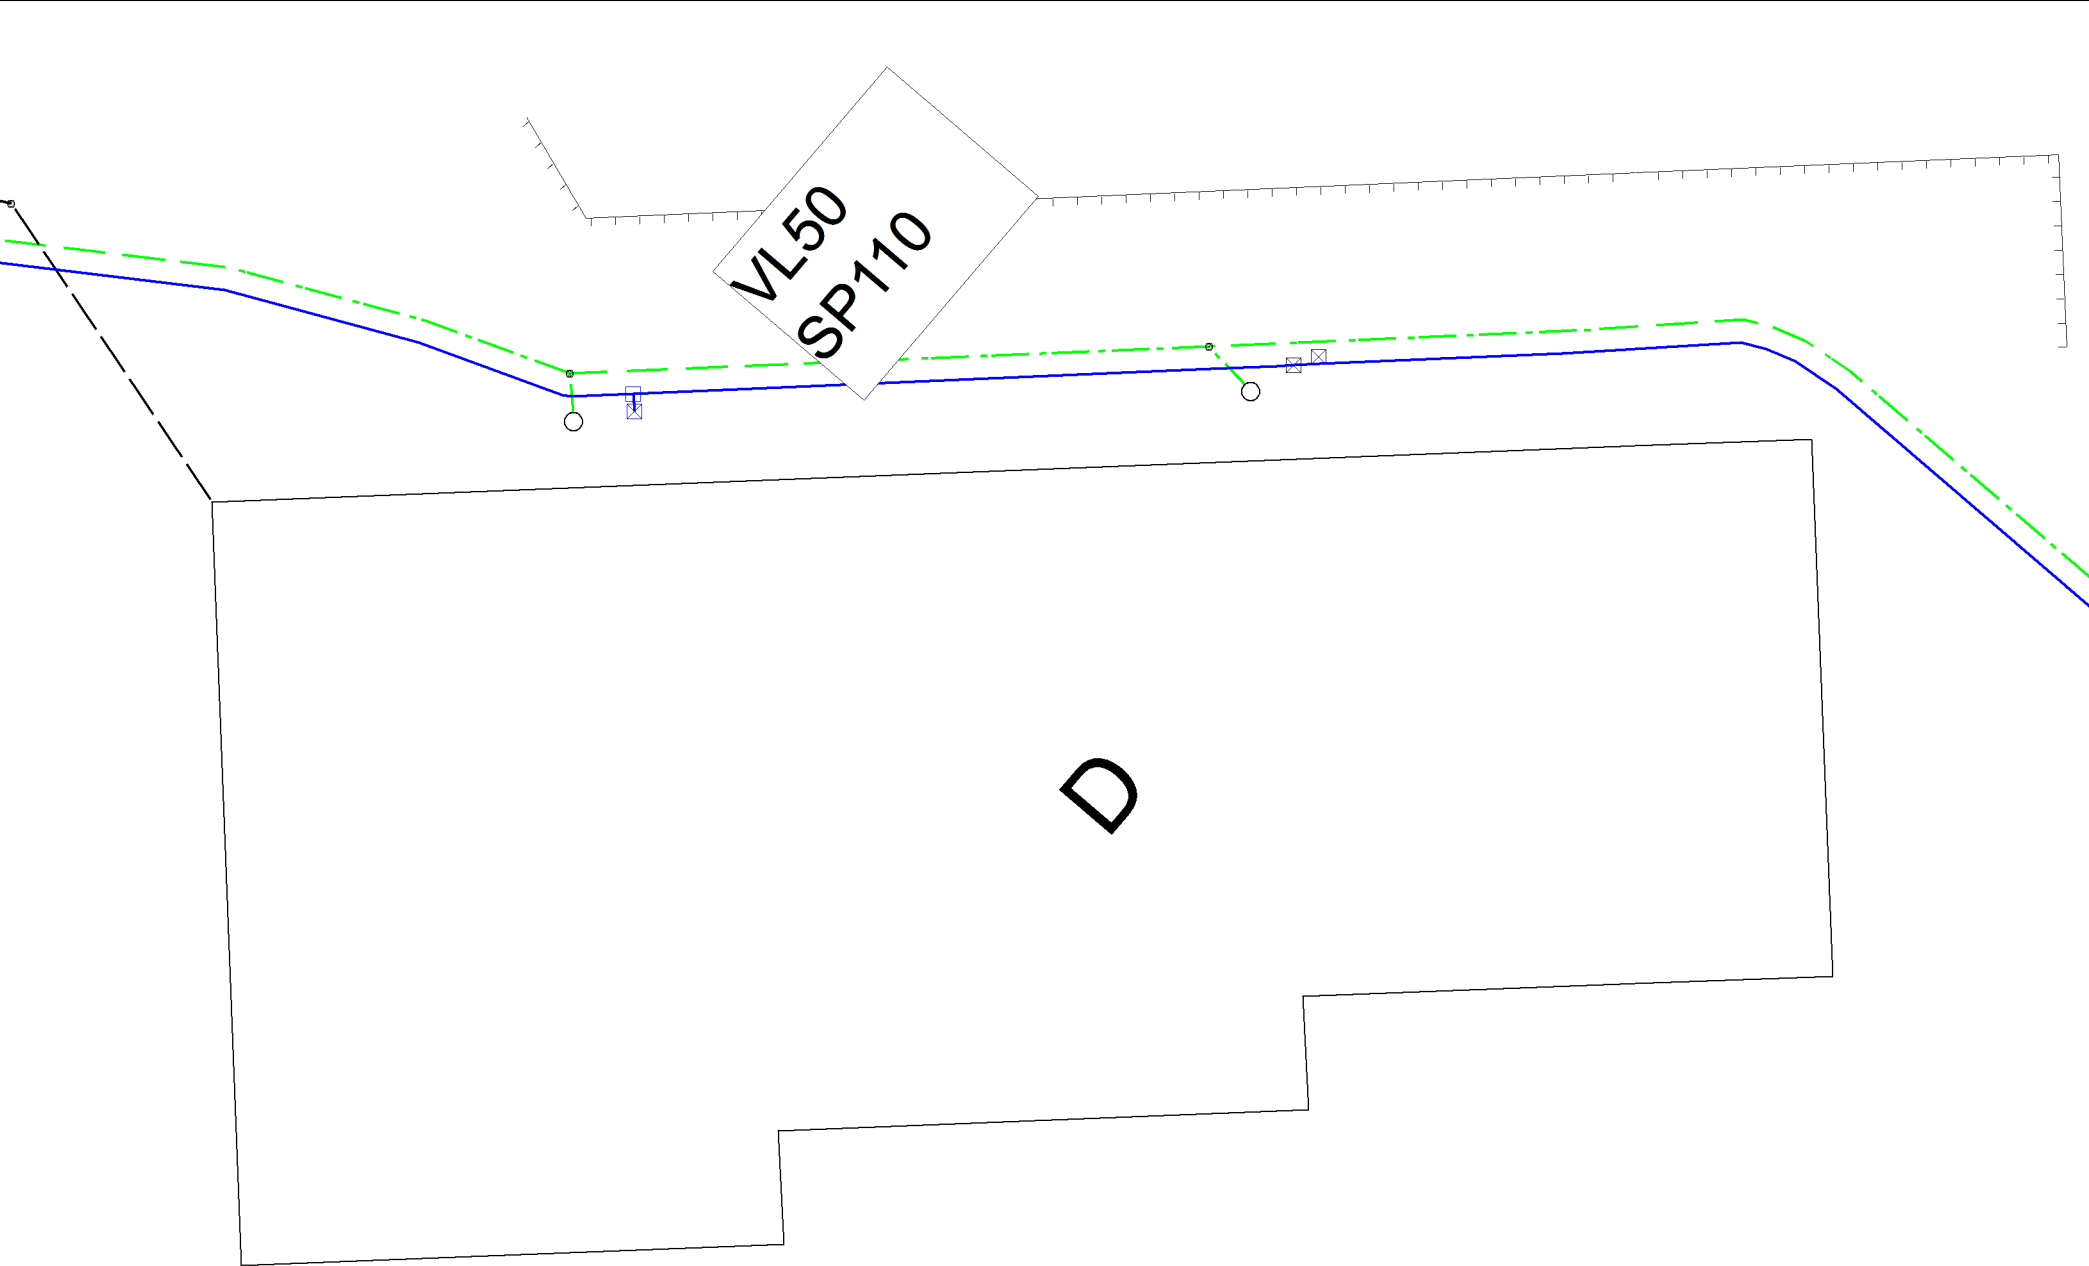

	Gbnr 137/203
	Innmålt VA
	28.11.2019
	Målestokk 1:100
Medaas Oppmåling	