


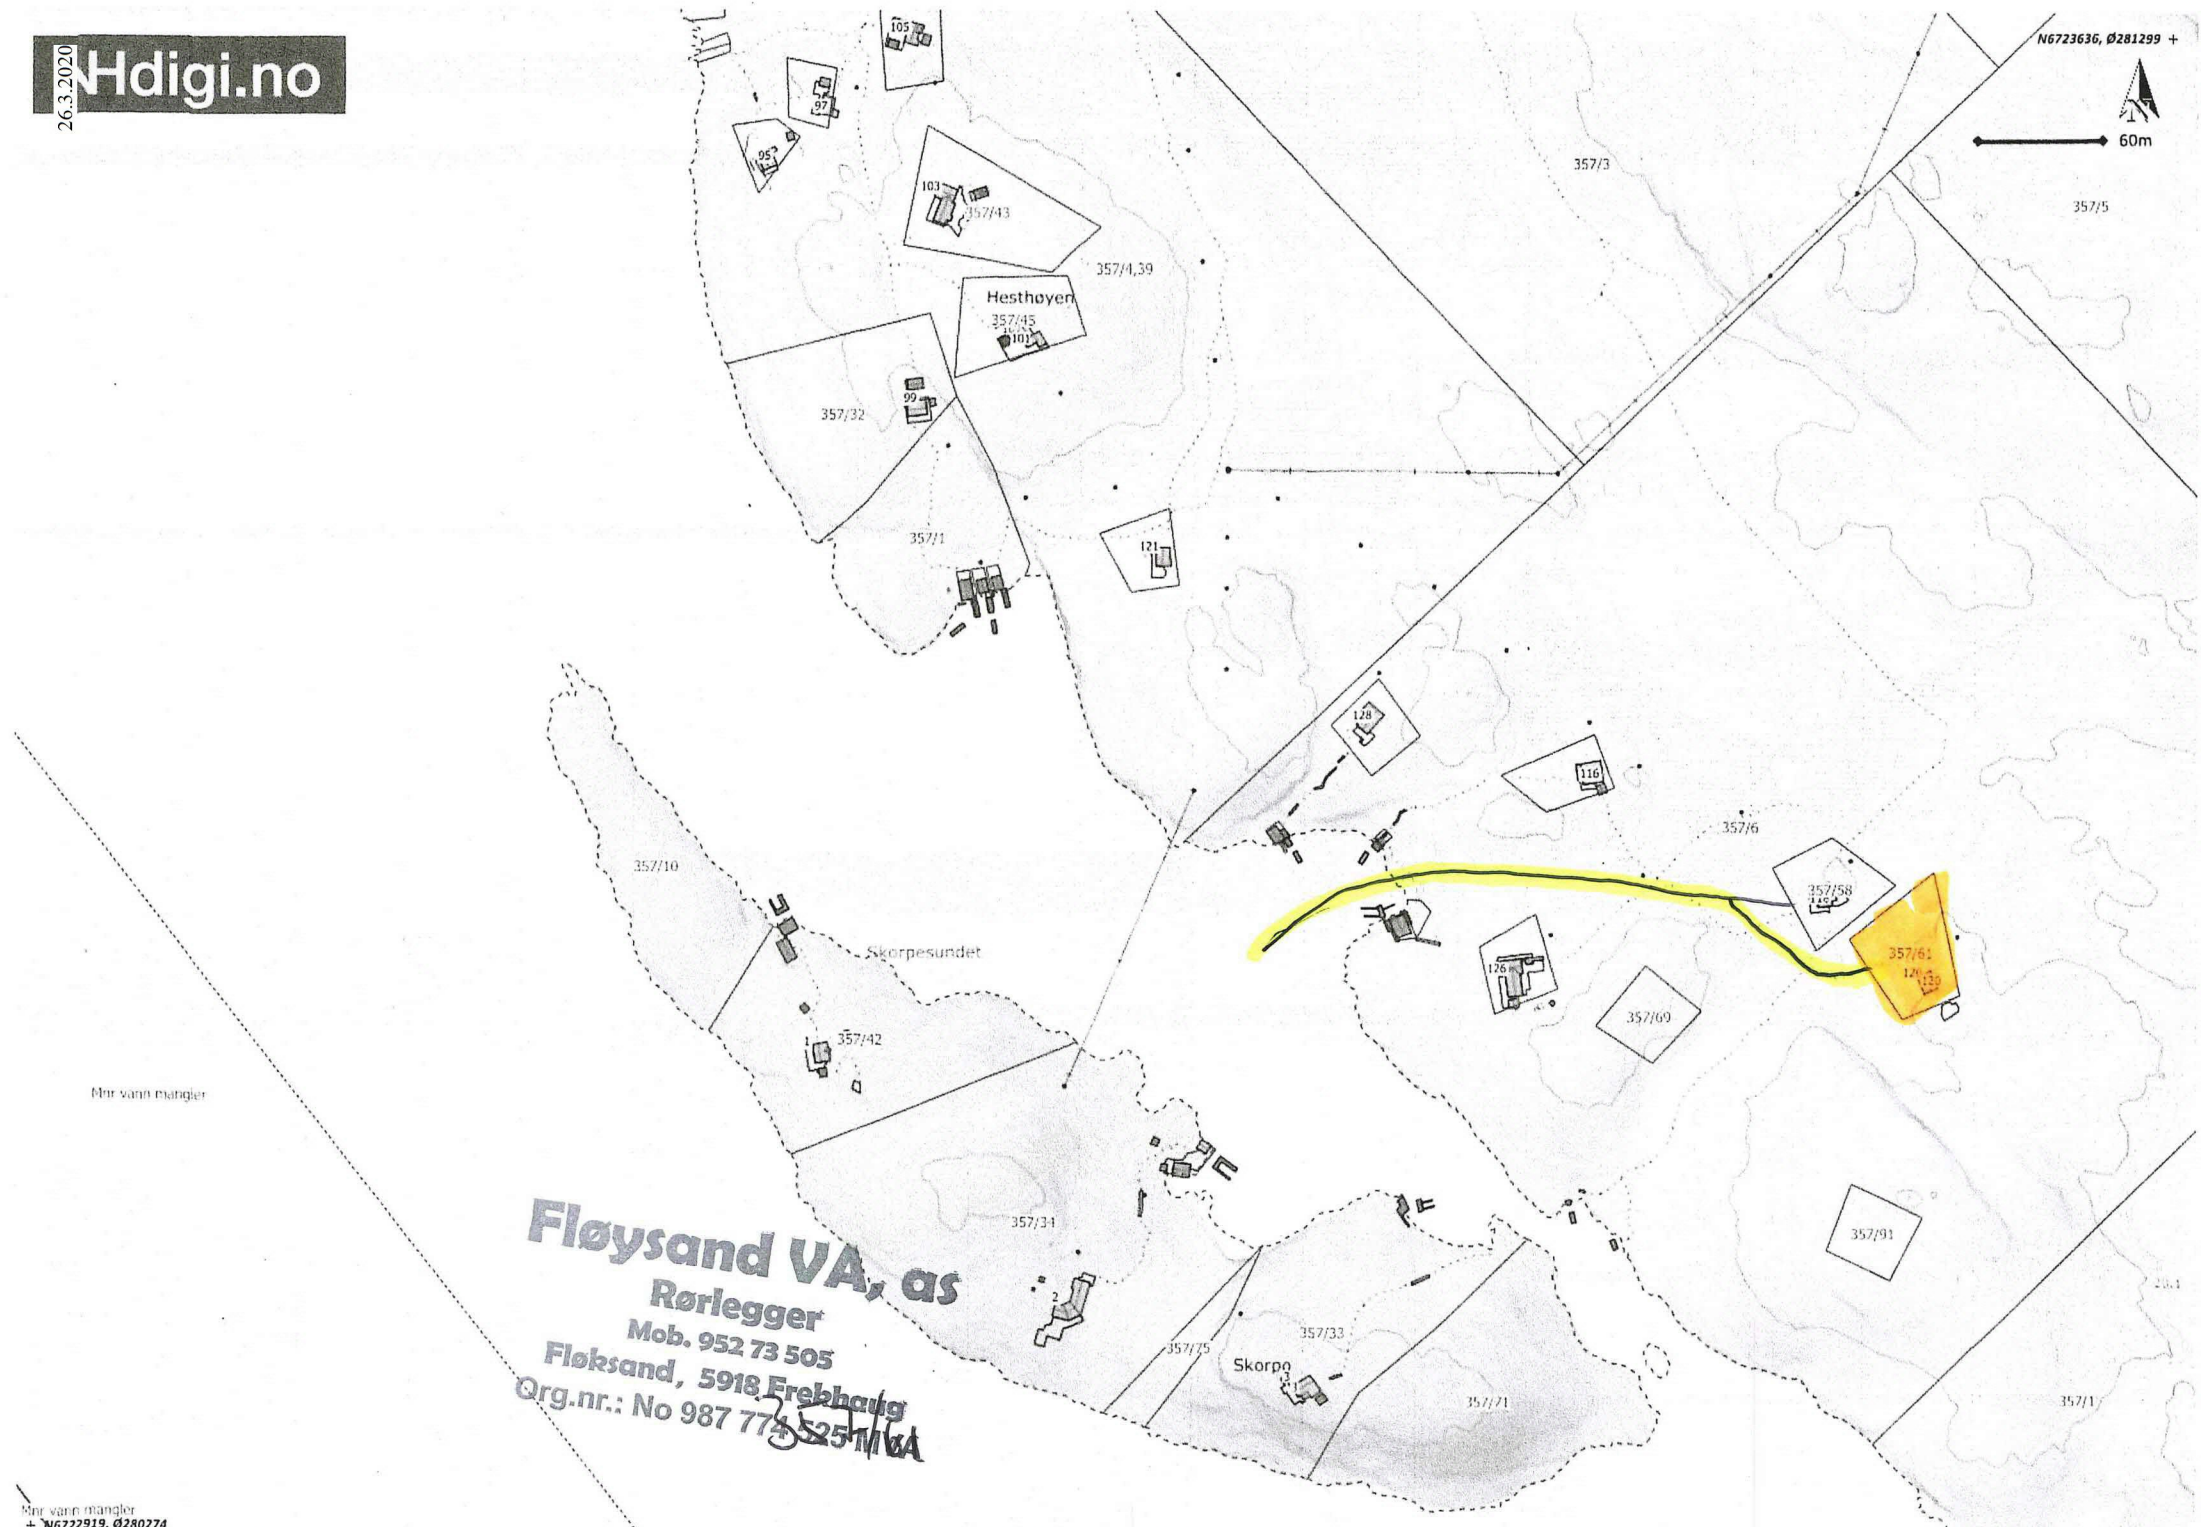

60m



Mnr vann mångler

Fløysand VA, as
Rørlegger
Mob. 952 73 505
Fløksand, 5918 Frebhaug
Org.nr.: No 987 778 525116A