



Dato 10.02.20.

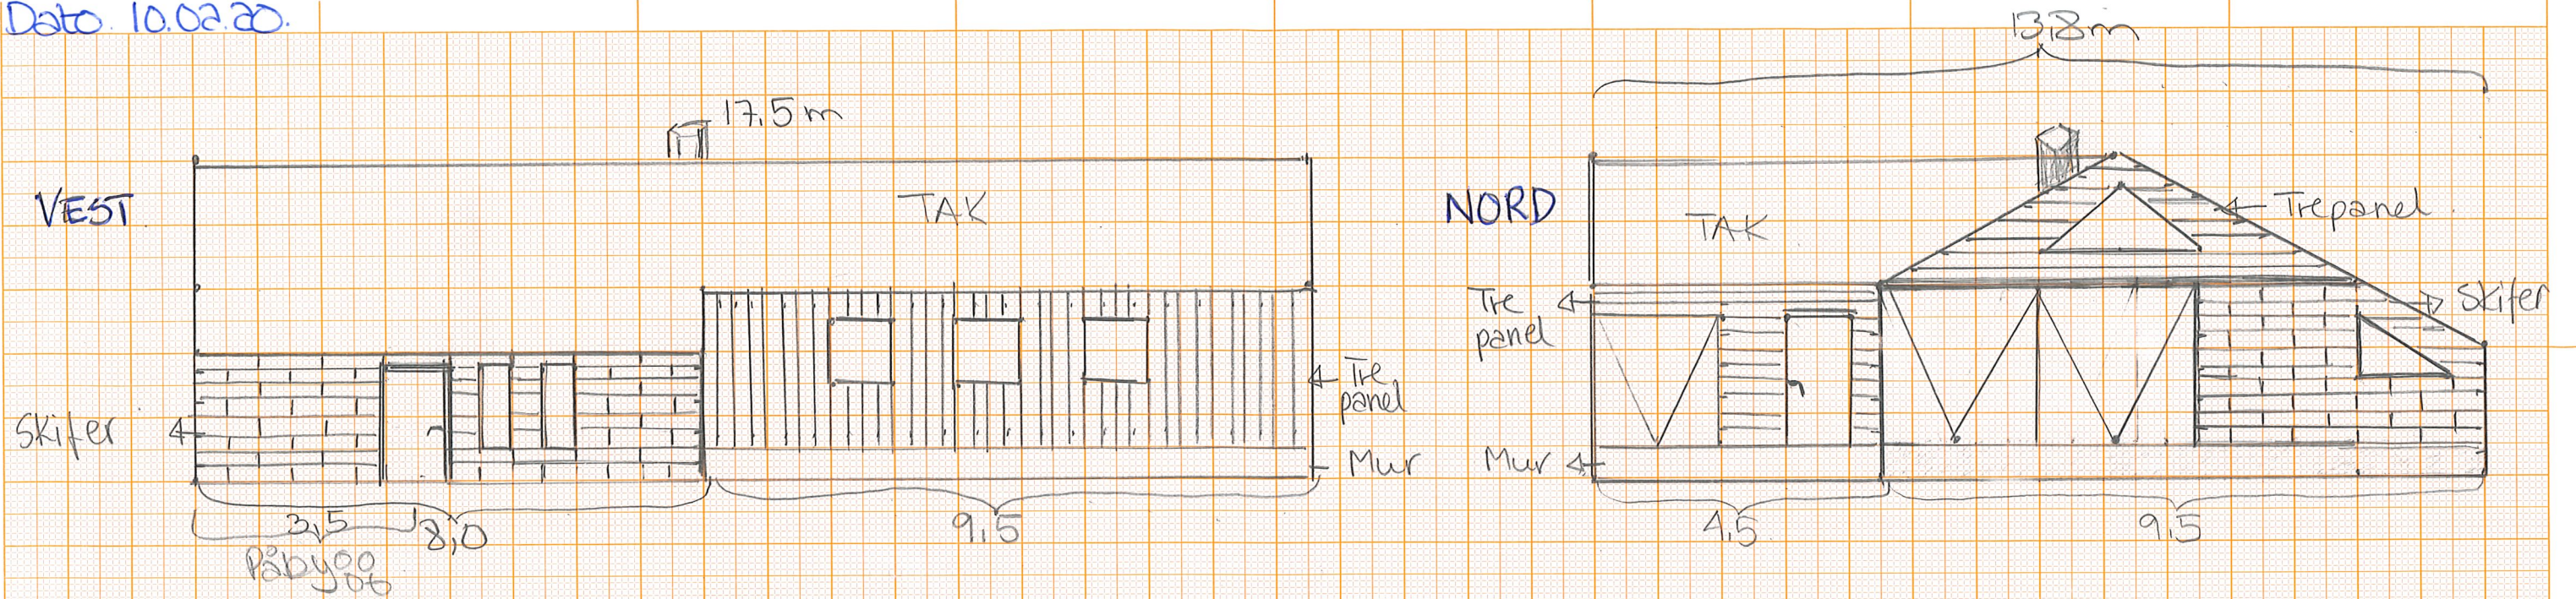

Ålver kommune, Gr. nr. 57, Br. nr 6, Kurevegen 1559.

1:100

"Ny" fasade tegninger

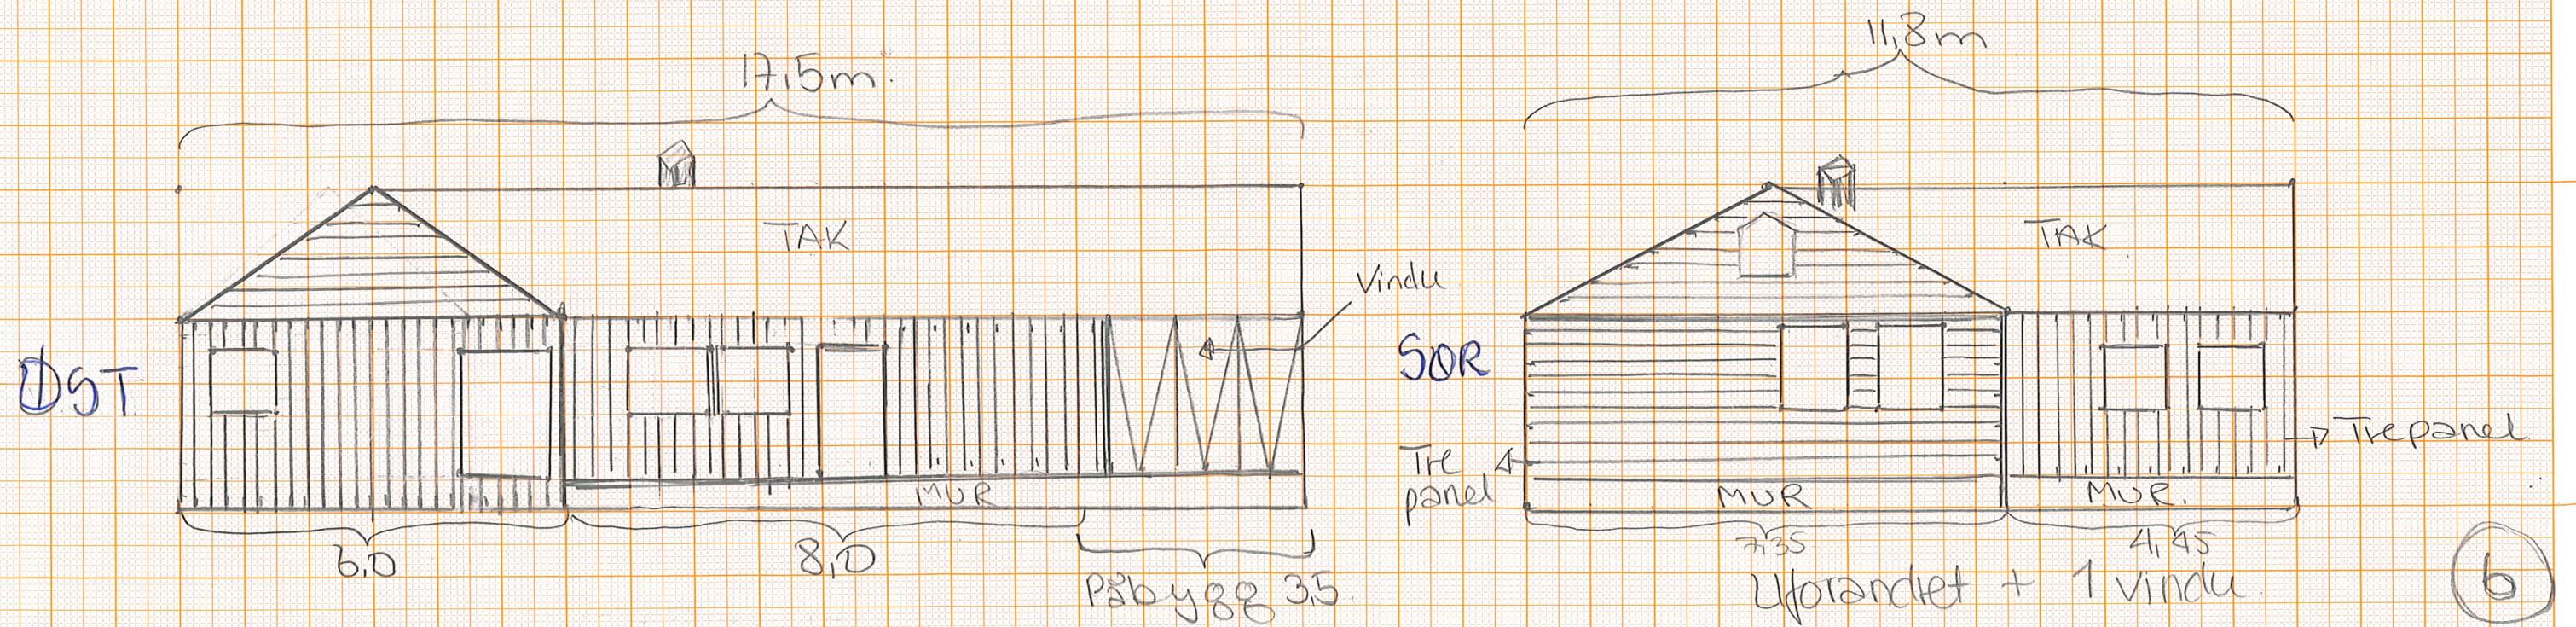

6