
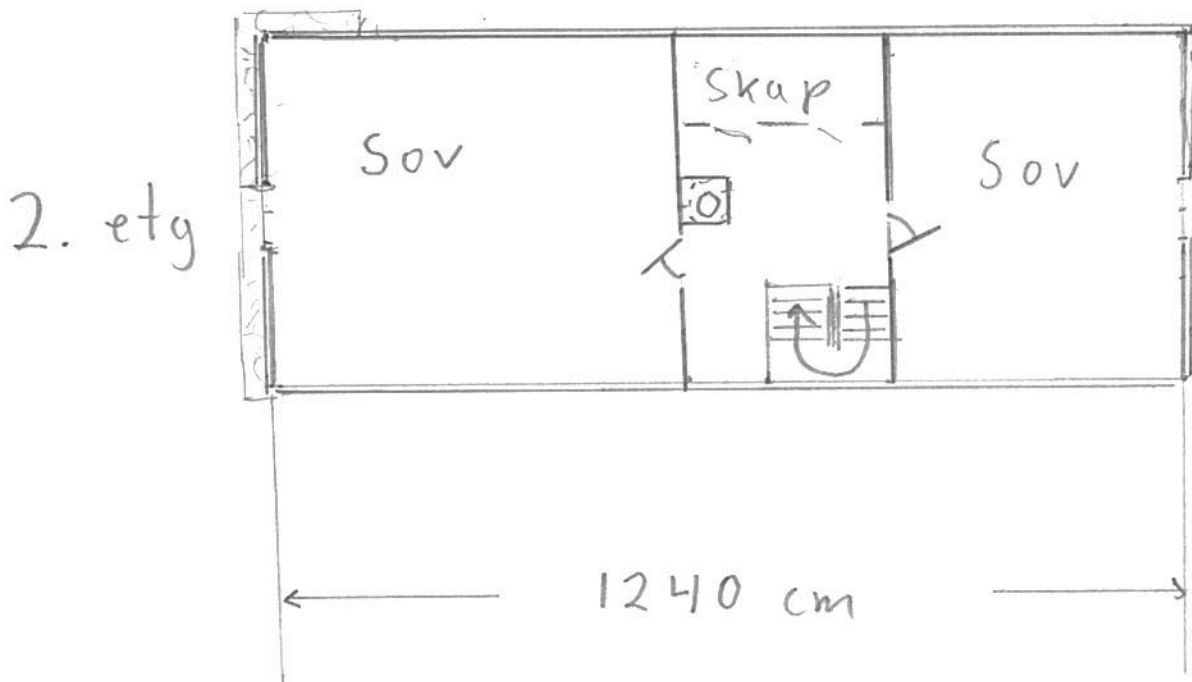


# Planløsning eksisterende våningshus

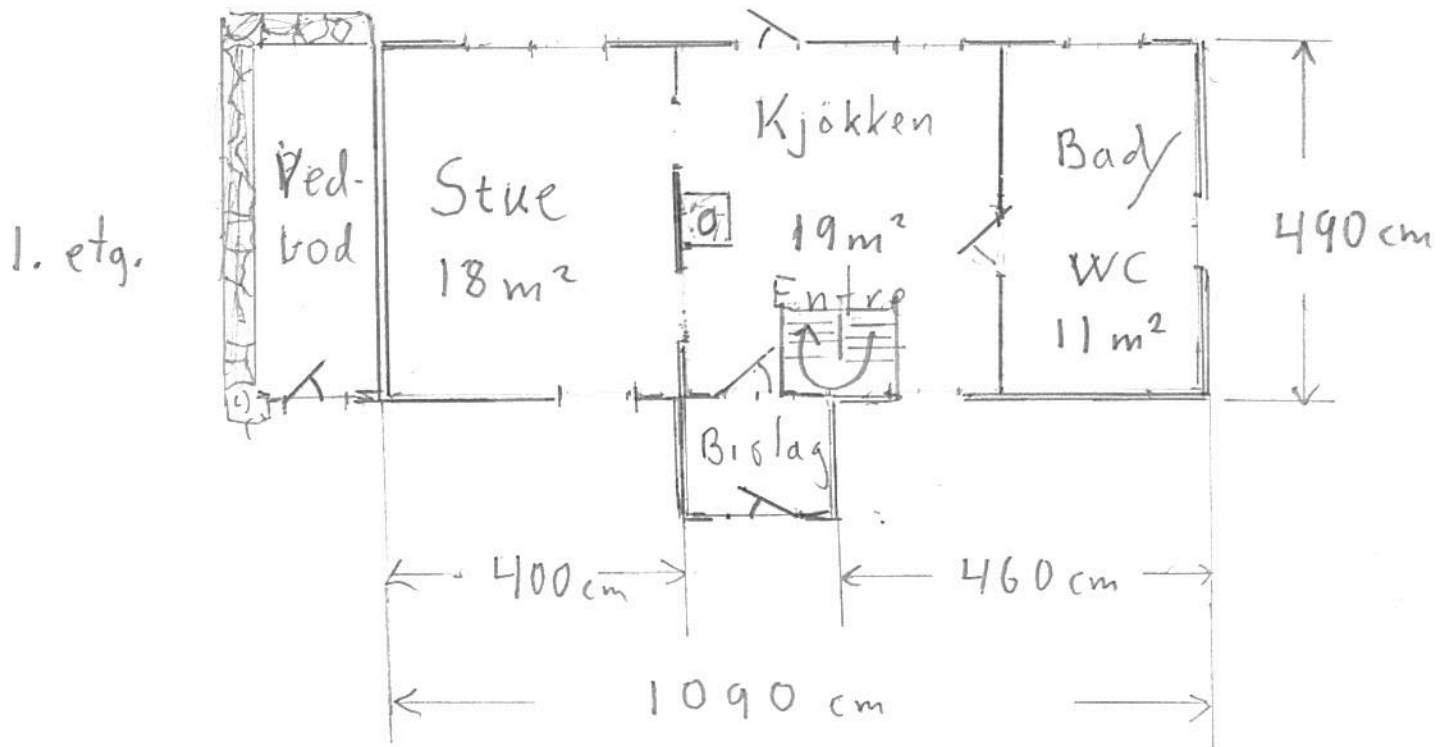

Målestokk: 1:100