



H8 YSP BOUNDING

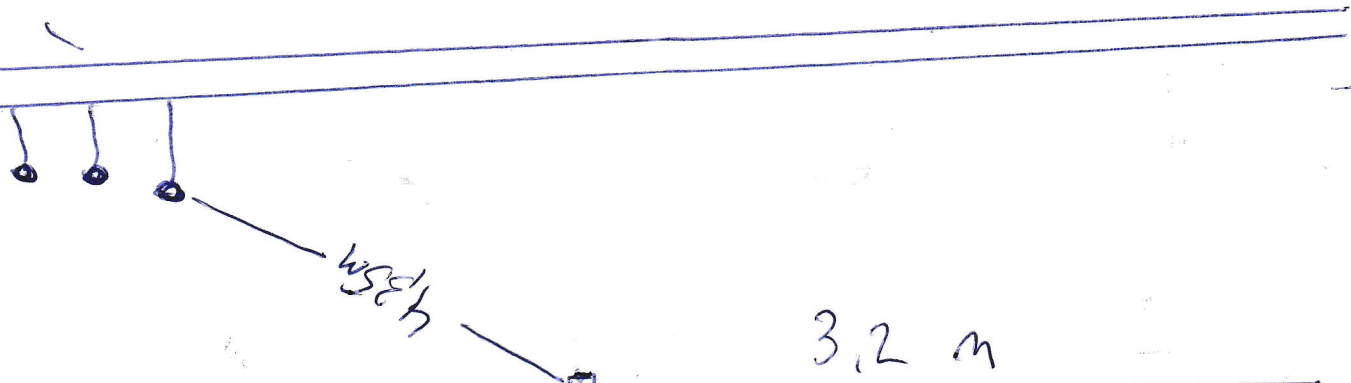


4.35m


3.2 m

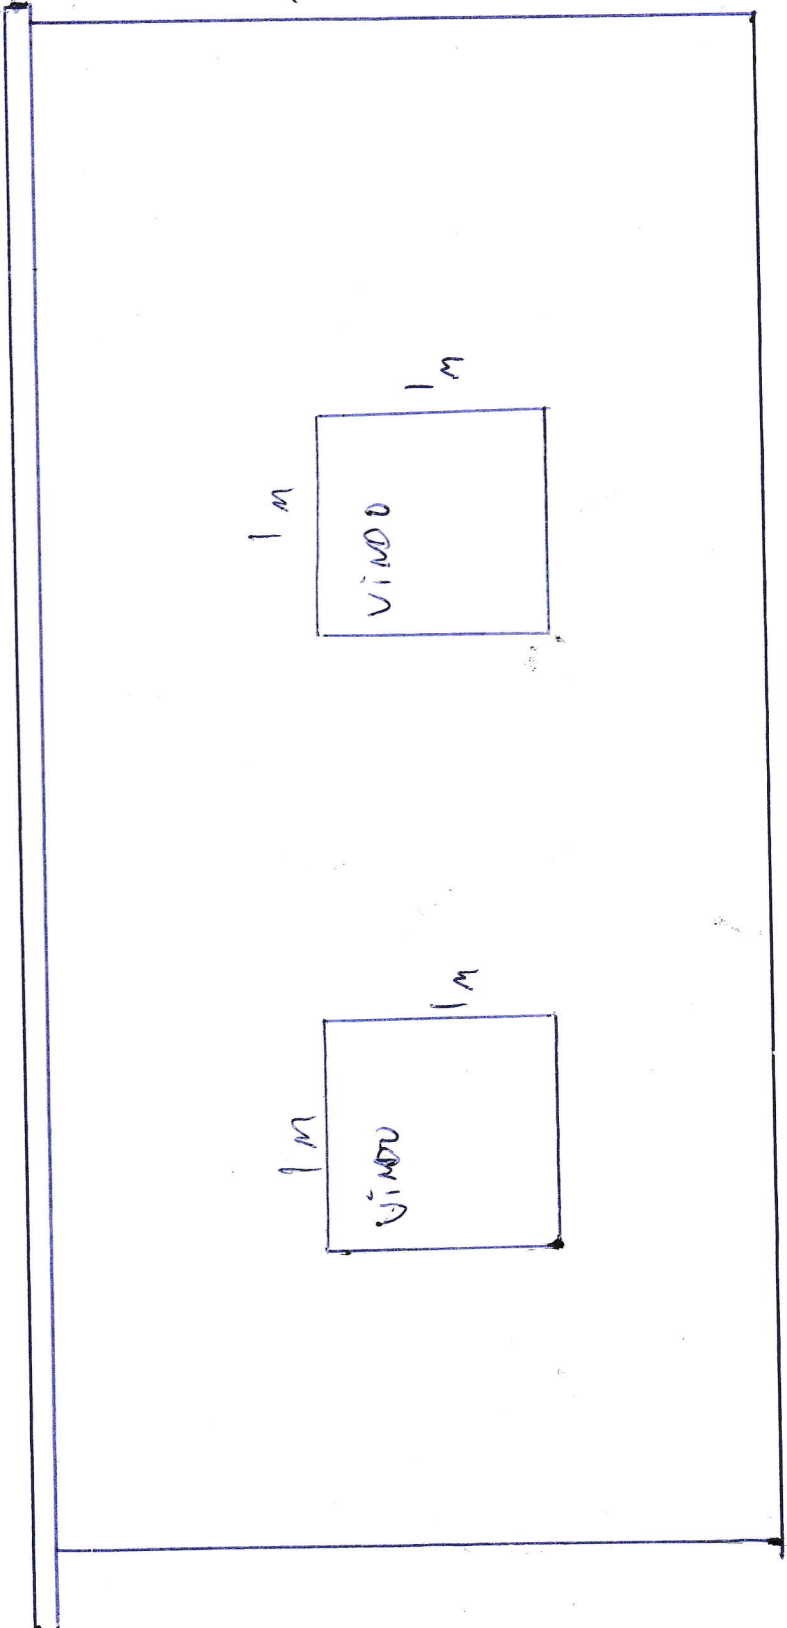

FRONT

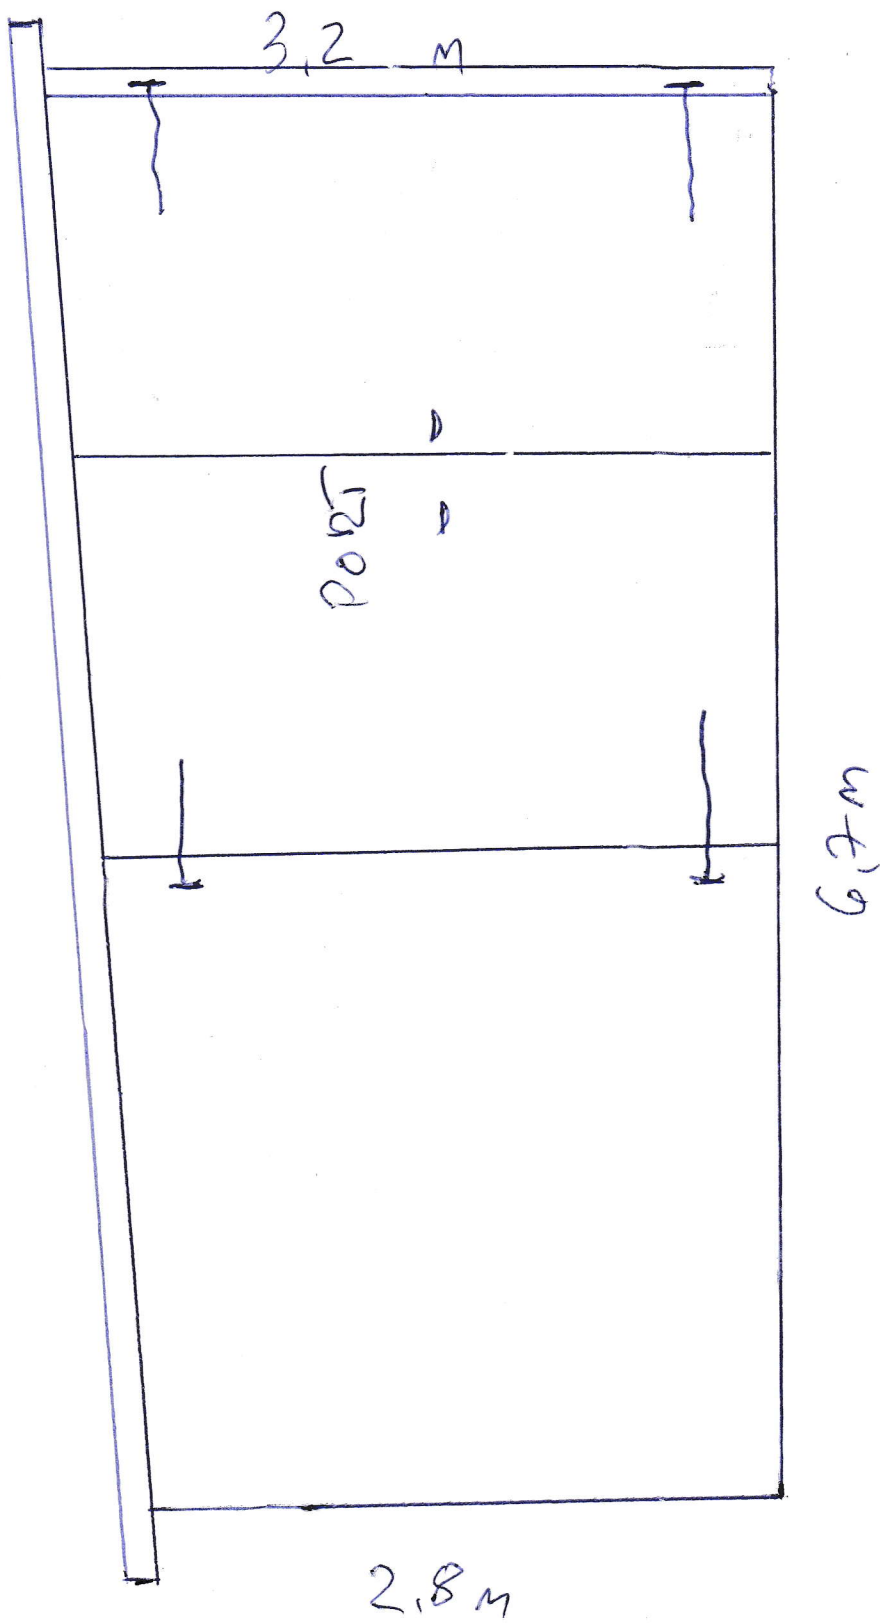

CALL

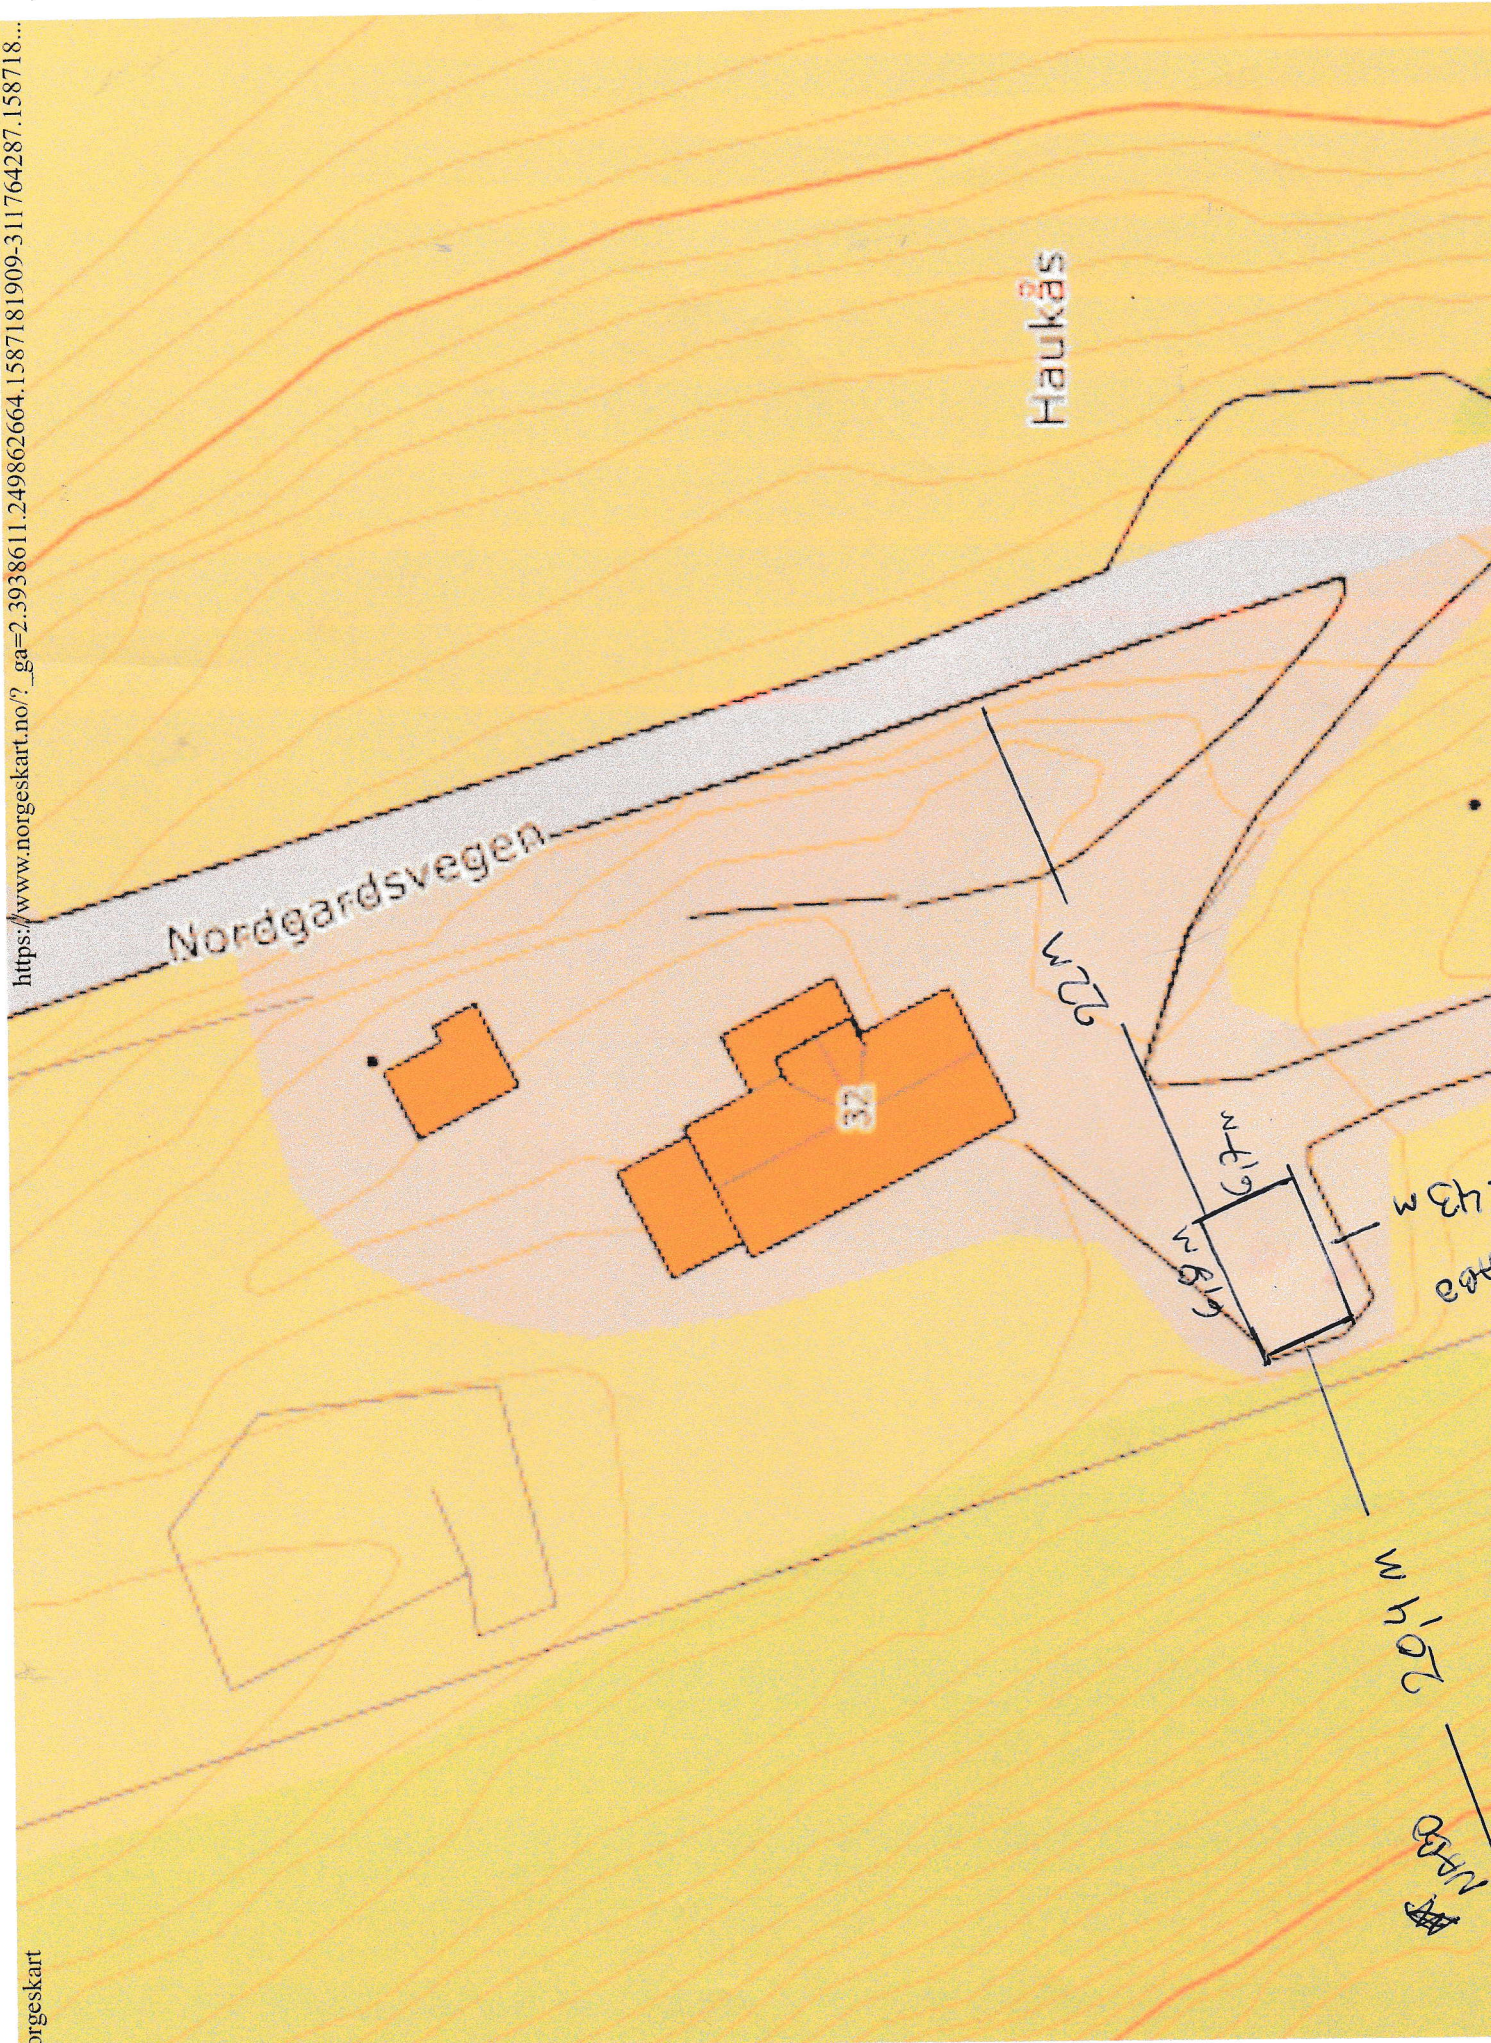

Haukås

Nordgardsvegen

32

22m

619

204m

1400

43m

eat