


21.10.2019
ANDAS KOMMUNE
TEKNISK ETAT
12.10.88 002497
ARKIV NR 202/17

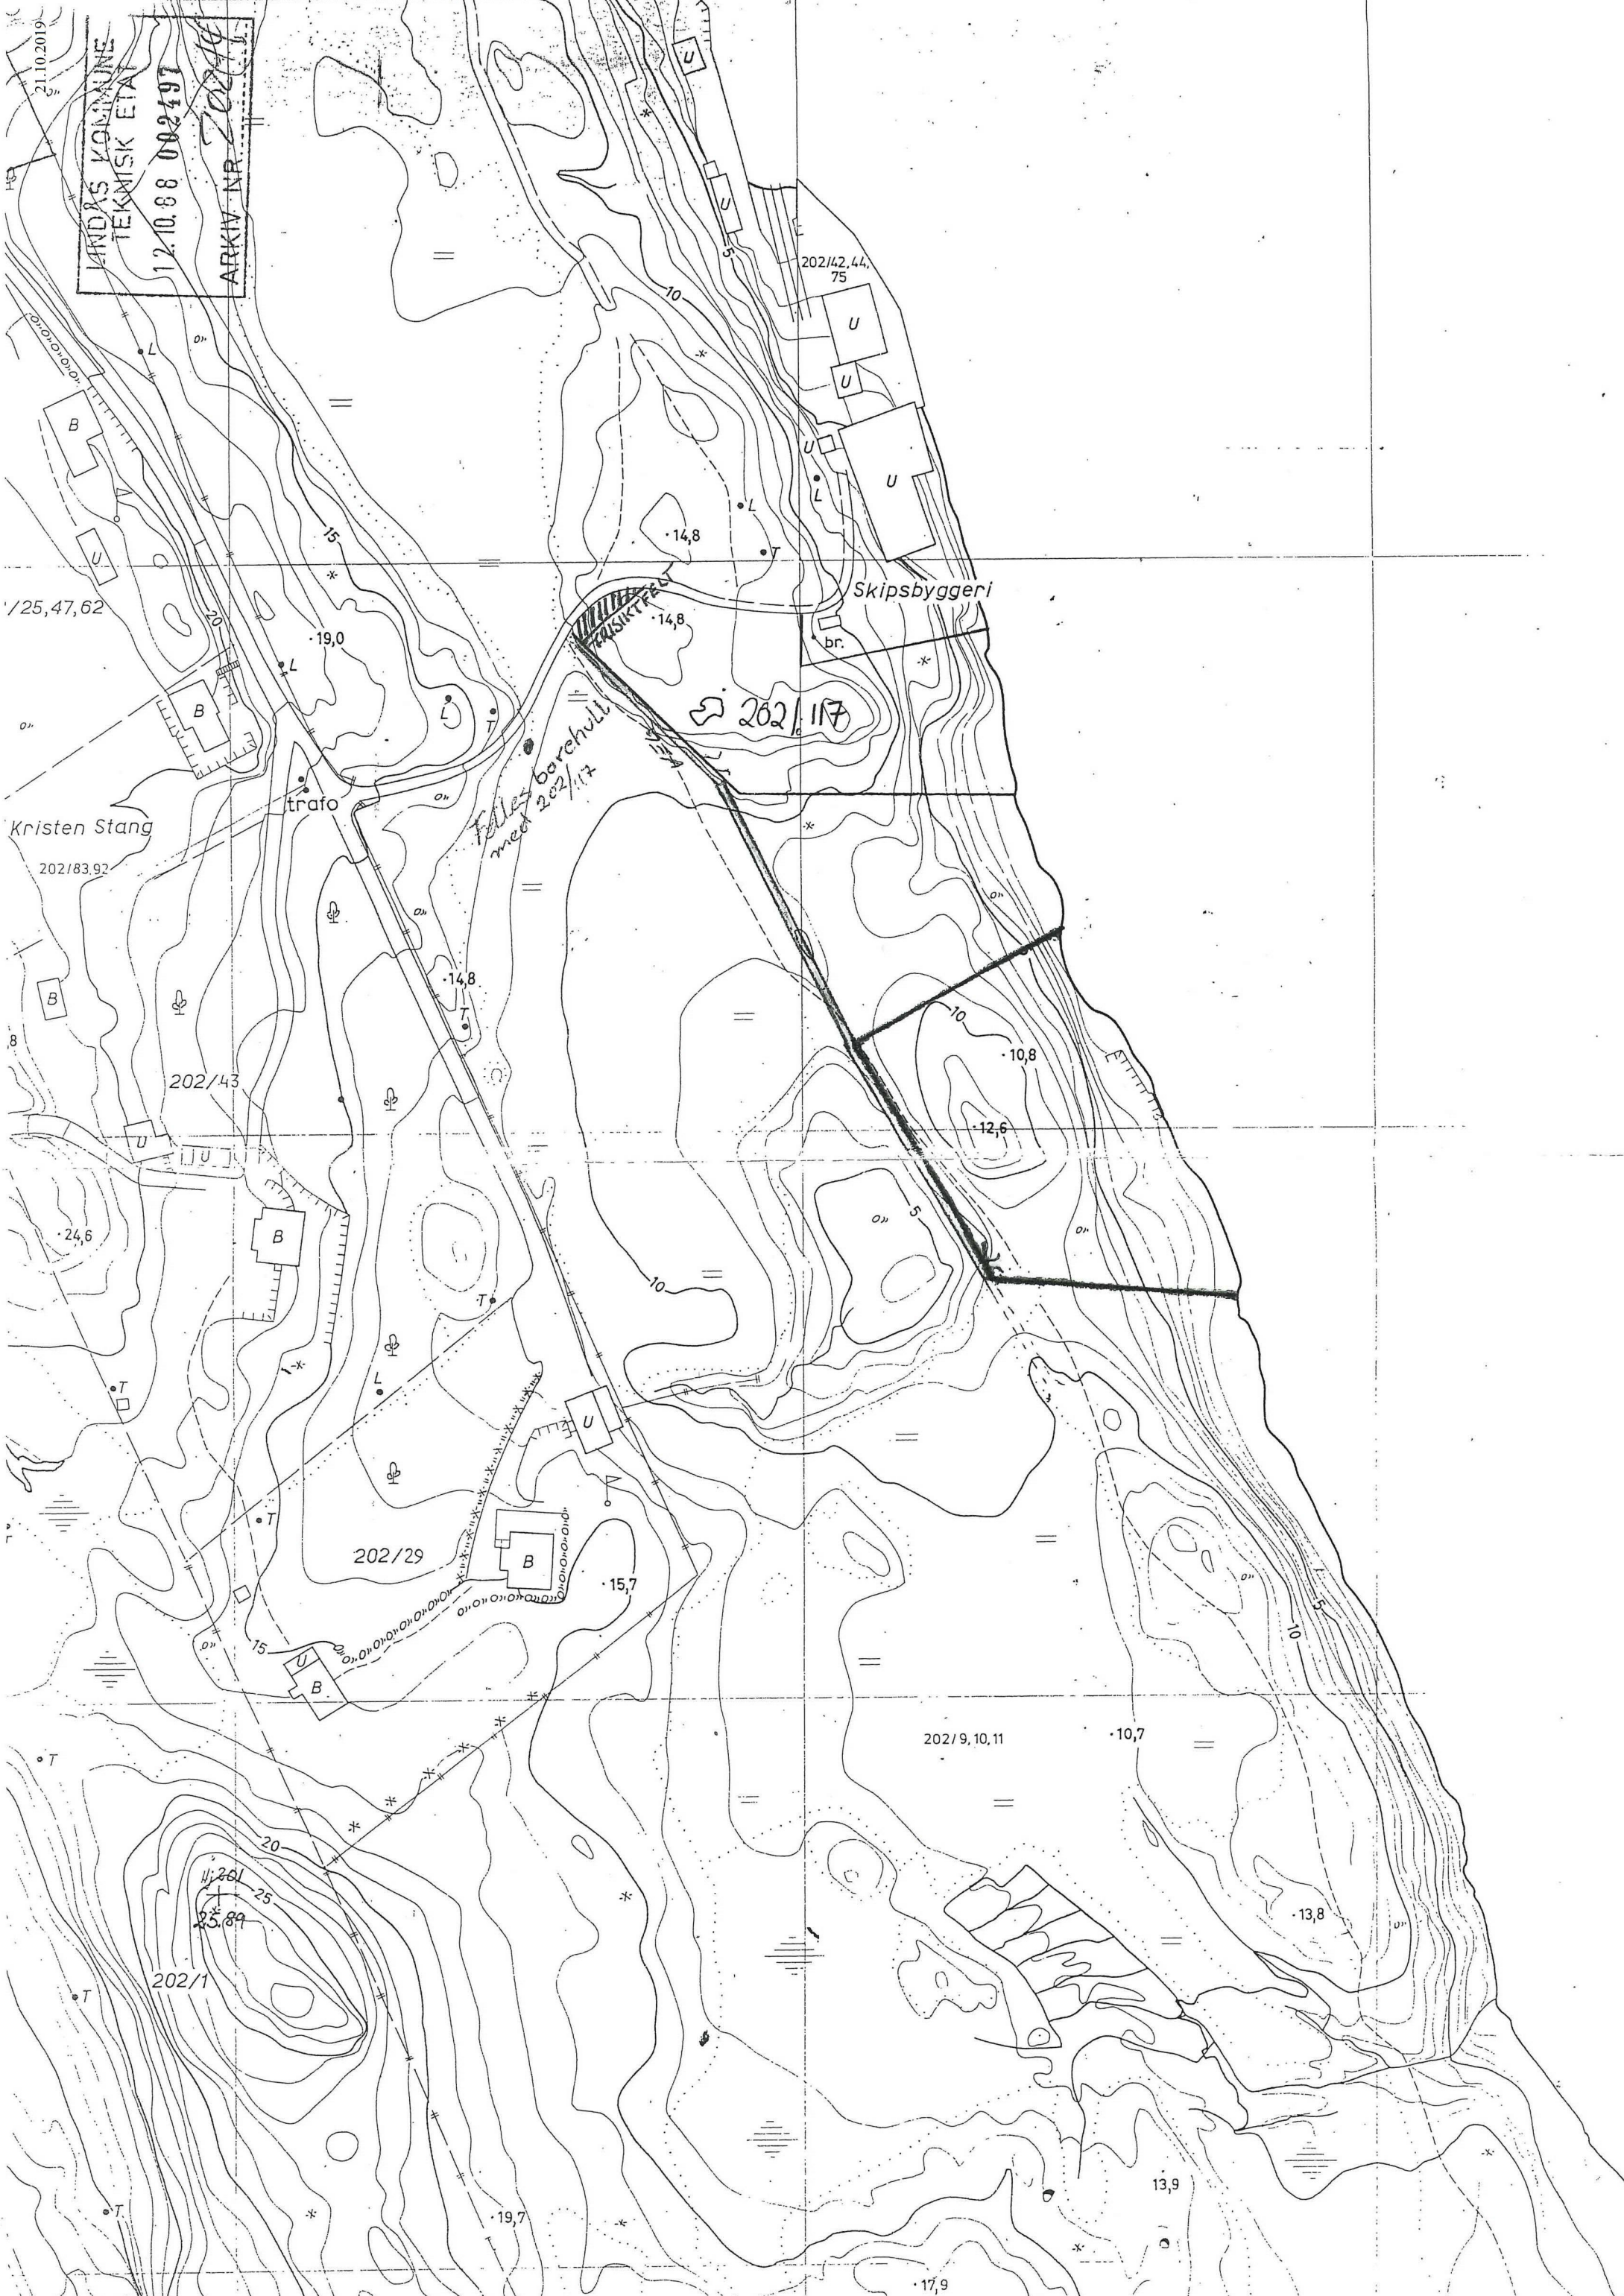

25,47,62

Kristen Stang

202/83,92

202/43

202/29

202/1

202/42,44,75

202/117

202/9,10,11

13,9

17,9