


vedlegg 4

13.5.2020

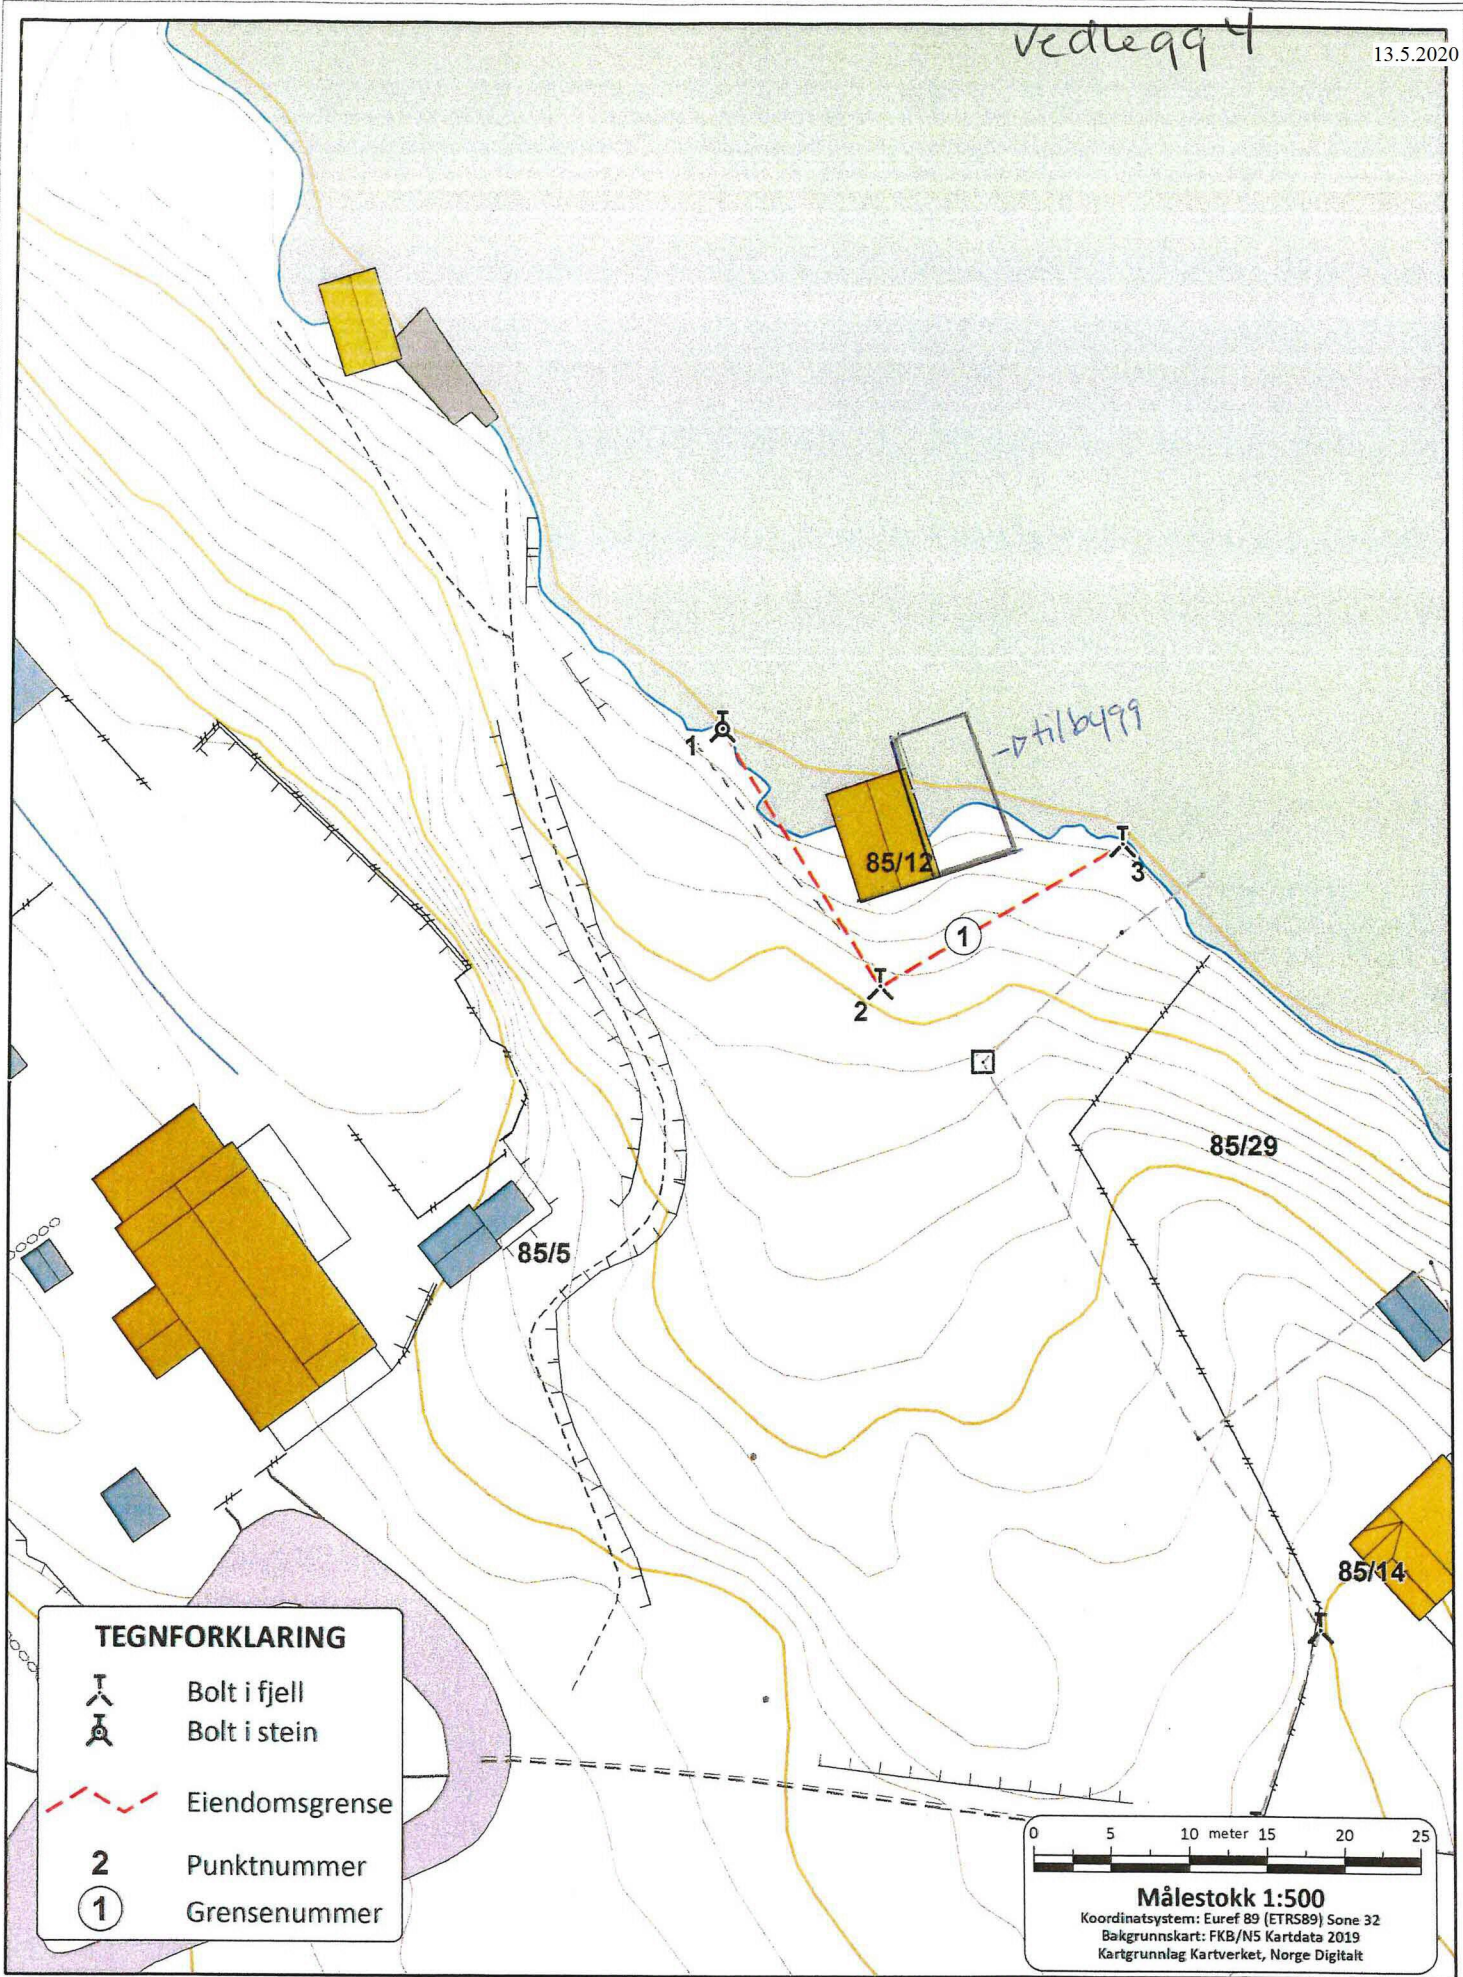

**TEGNFORKLARING**



Bolt i fjell



Bolt i stein




Eiendomsgrense

2

Punktnummer

①

Grensenummer

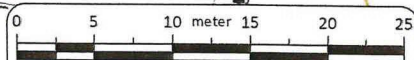

**Målestokk 1:500**

Koordinatsystem: Euref 89 (ETRS89) Sone 32  
Bakgrunnskart: FKB/N5 Kartdata 2019  
Kartgrunnlag Kartverket, Norge Digitalt

**NORD- OG MIDHORDLAND JORDSKIFTERETT**

Grensekart over

**SOLHAUG, GNR. 85**

i Lindås kommune

SAK NR. 19-092084RFA-JBER

Datert 17.12.2019

Blad 1 av 1

Berørte gnr.: 85

Teknisk utreder -

Overing. Stig Kogstad