


# KLEVDALSVEGEN:


38B

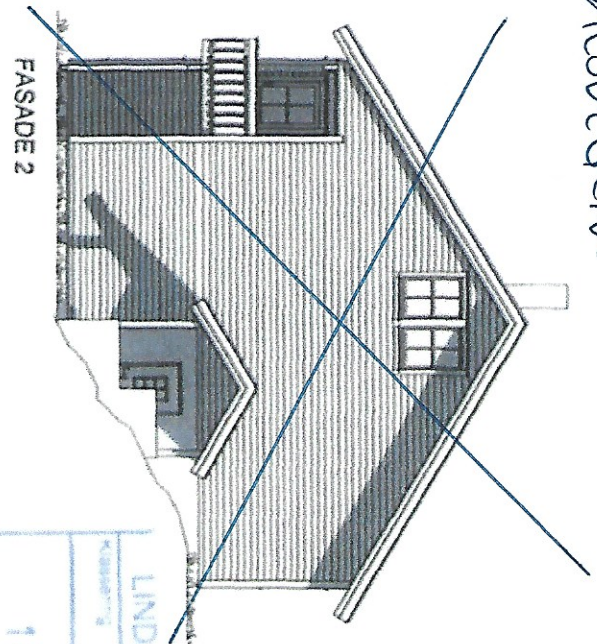

FASADE 2


LINDAS KOMMUNE  
 196/143  
 19 07 2010  
 2010/368  
 1150

38A

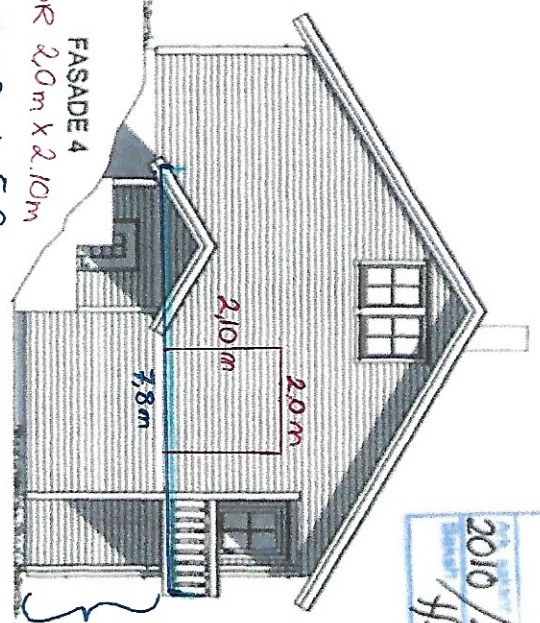


FASADE 4


- SKYVEDØR 2,0m x 2,10m
- TERRASSE 7,8m x 5,0m

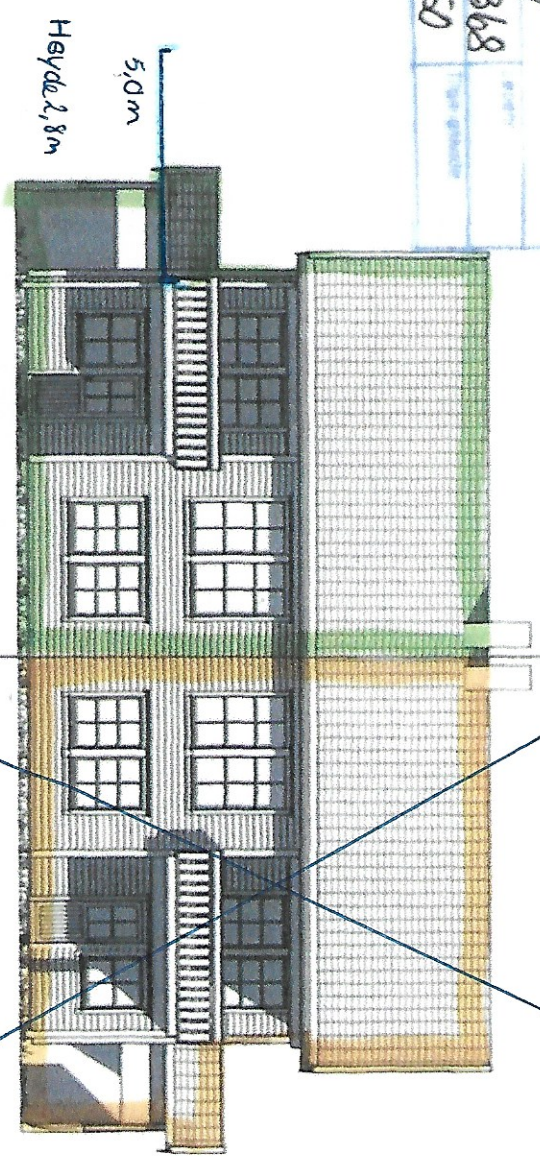

FASADE 1

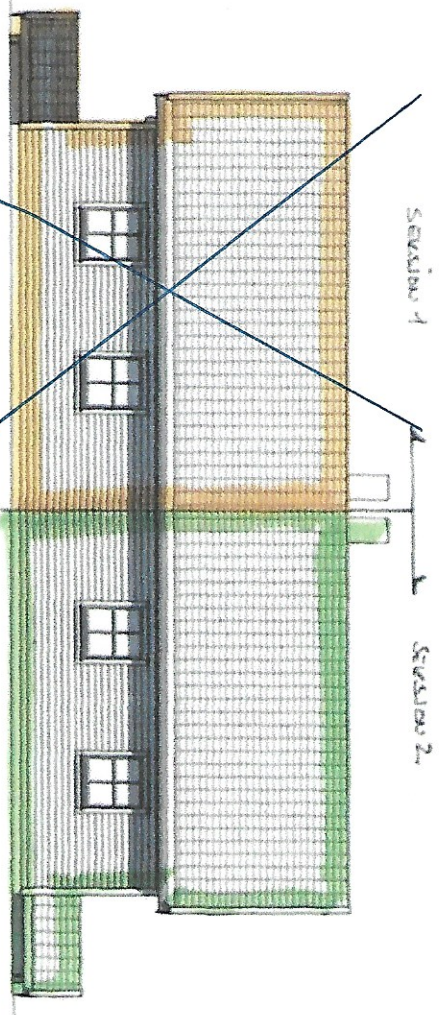

FASADE 3

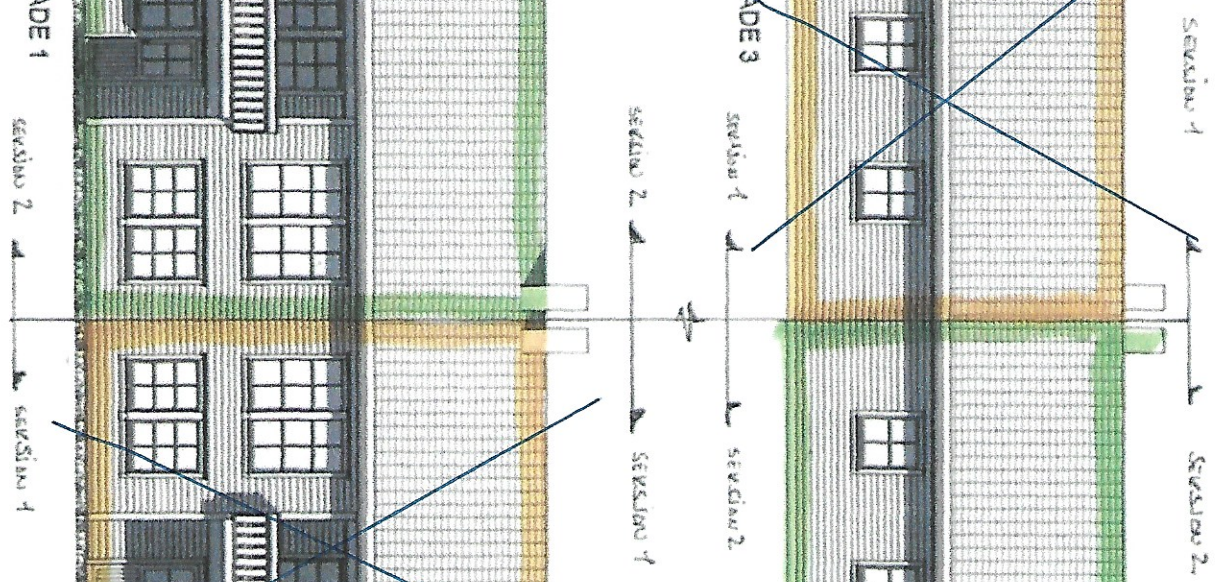

**SYSTEMHUS**

UNIKOS  
 1981/1982  
 1983/1984  
 1985/1986  
 2049/2050

BYGGER	ING. Karl Alnå Taulu AS
TEKNISSIVERT	Jochim Øvervoll
PROJEKTLANS	Hilleraug 143
BYGGER	198/193
KOMMUNE	Lindås

REV.	DATE	REVISJON	BYGGER

FRODIG 115  
 09409-4  
 09.0.