
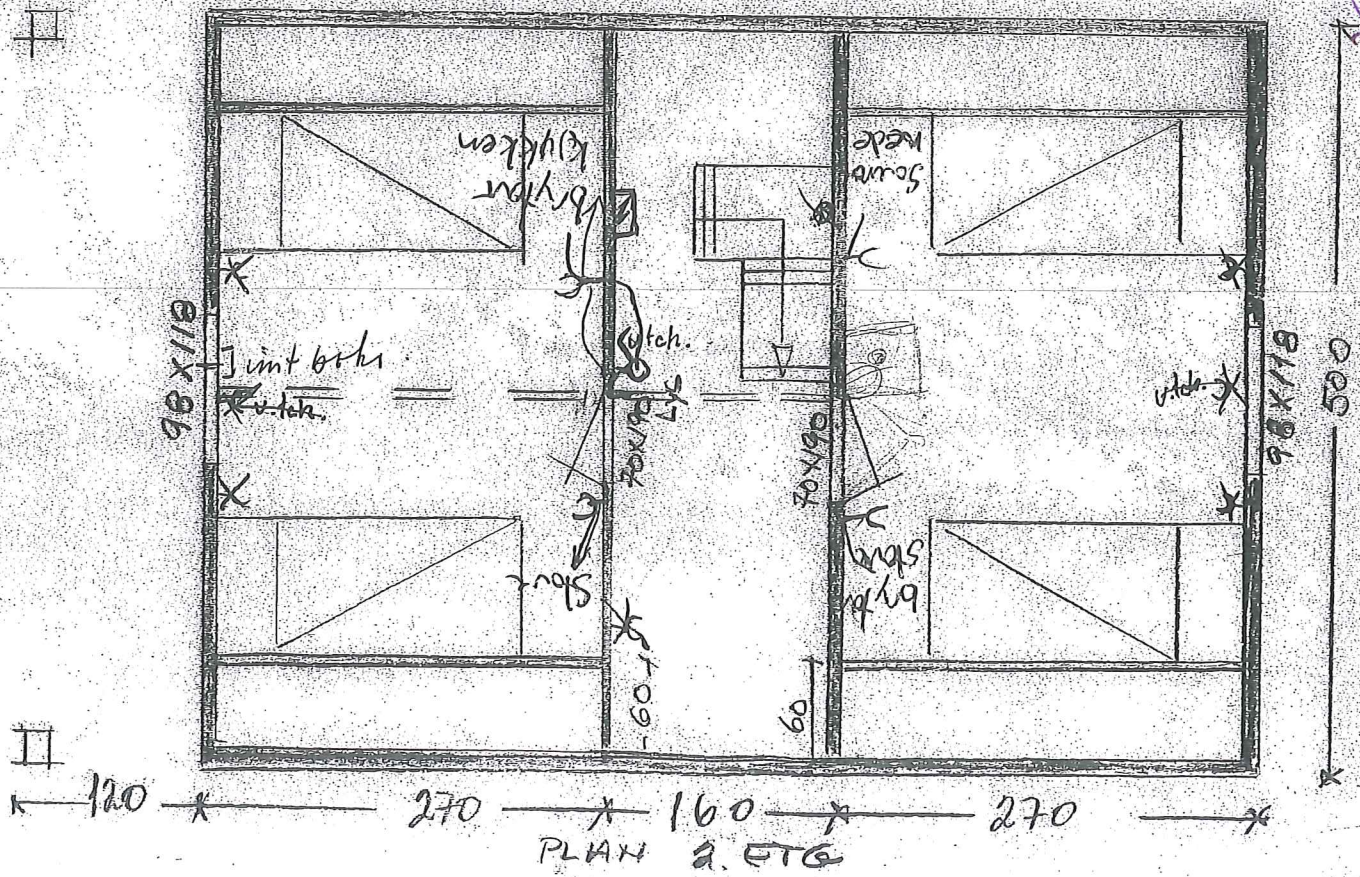
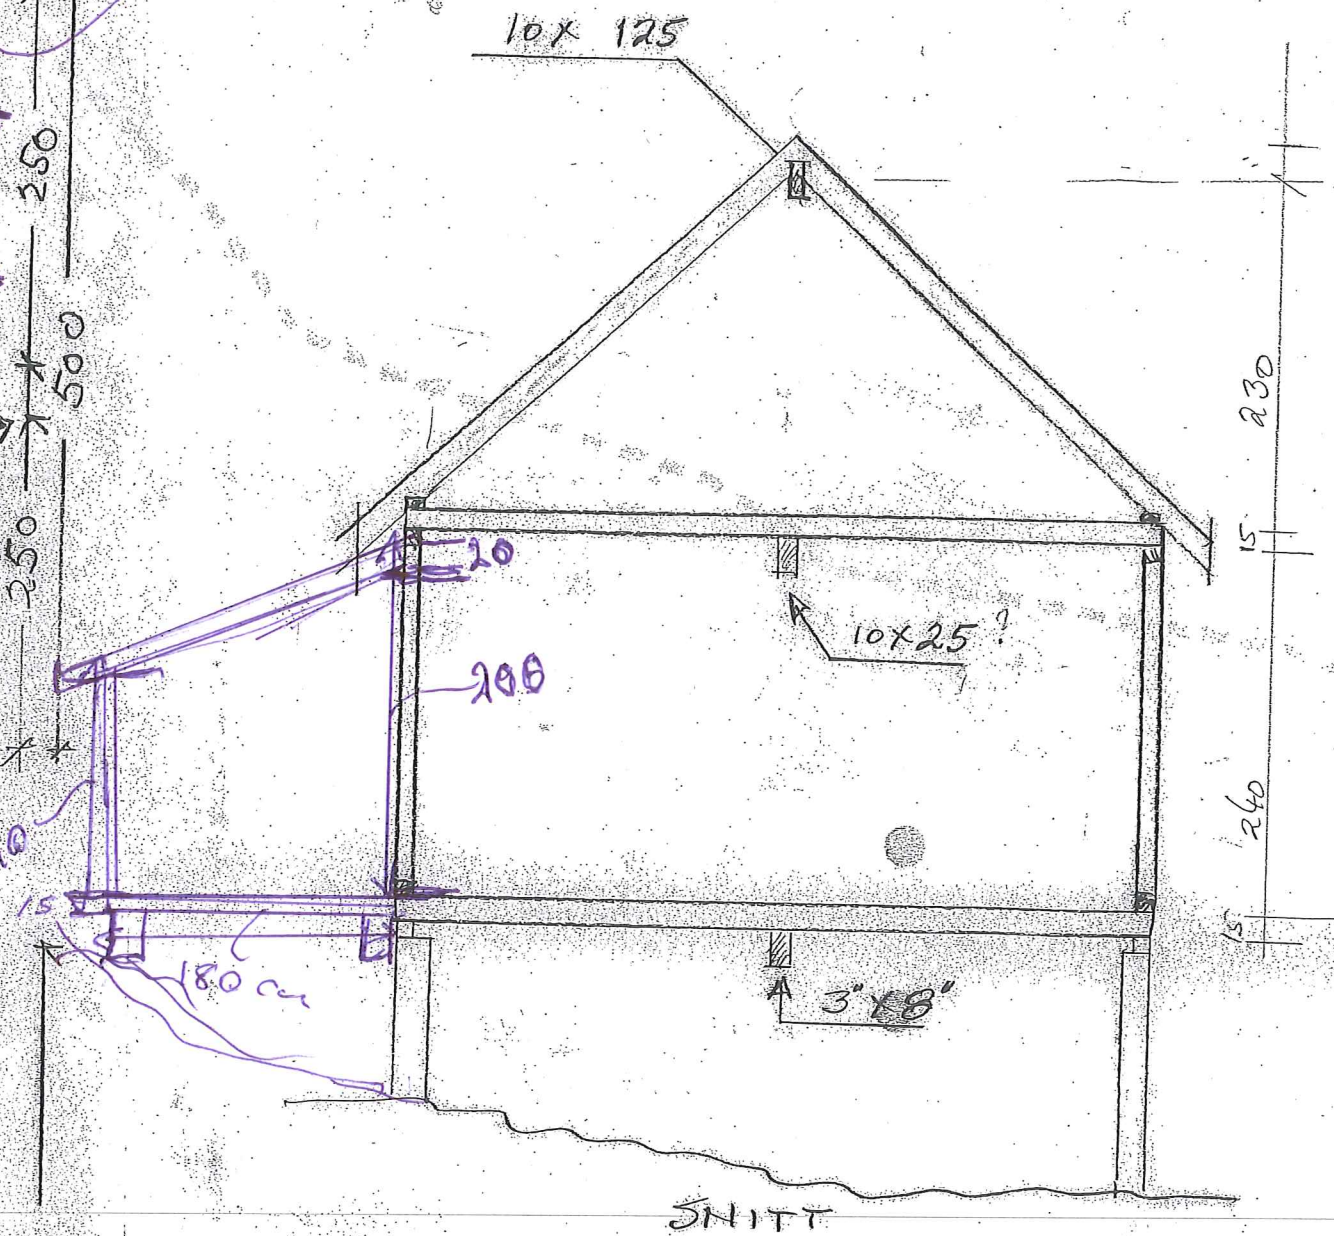


XII TILBYGG.

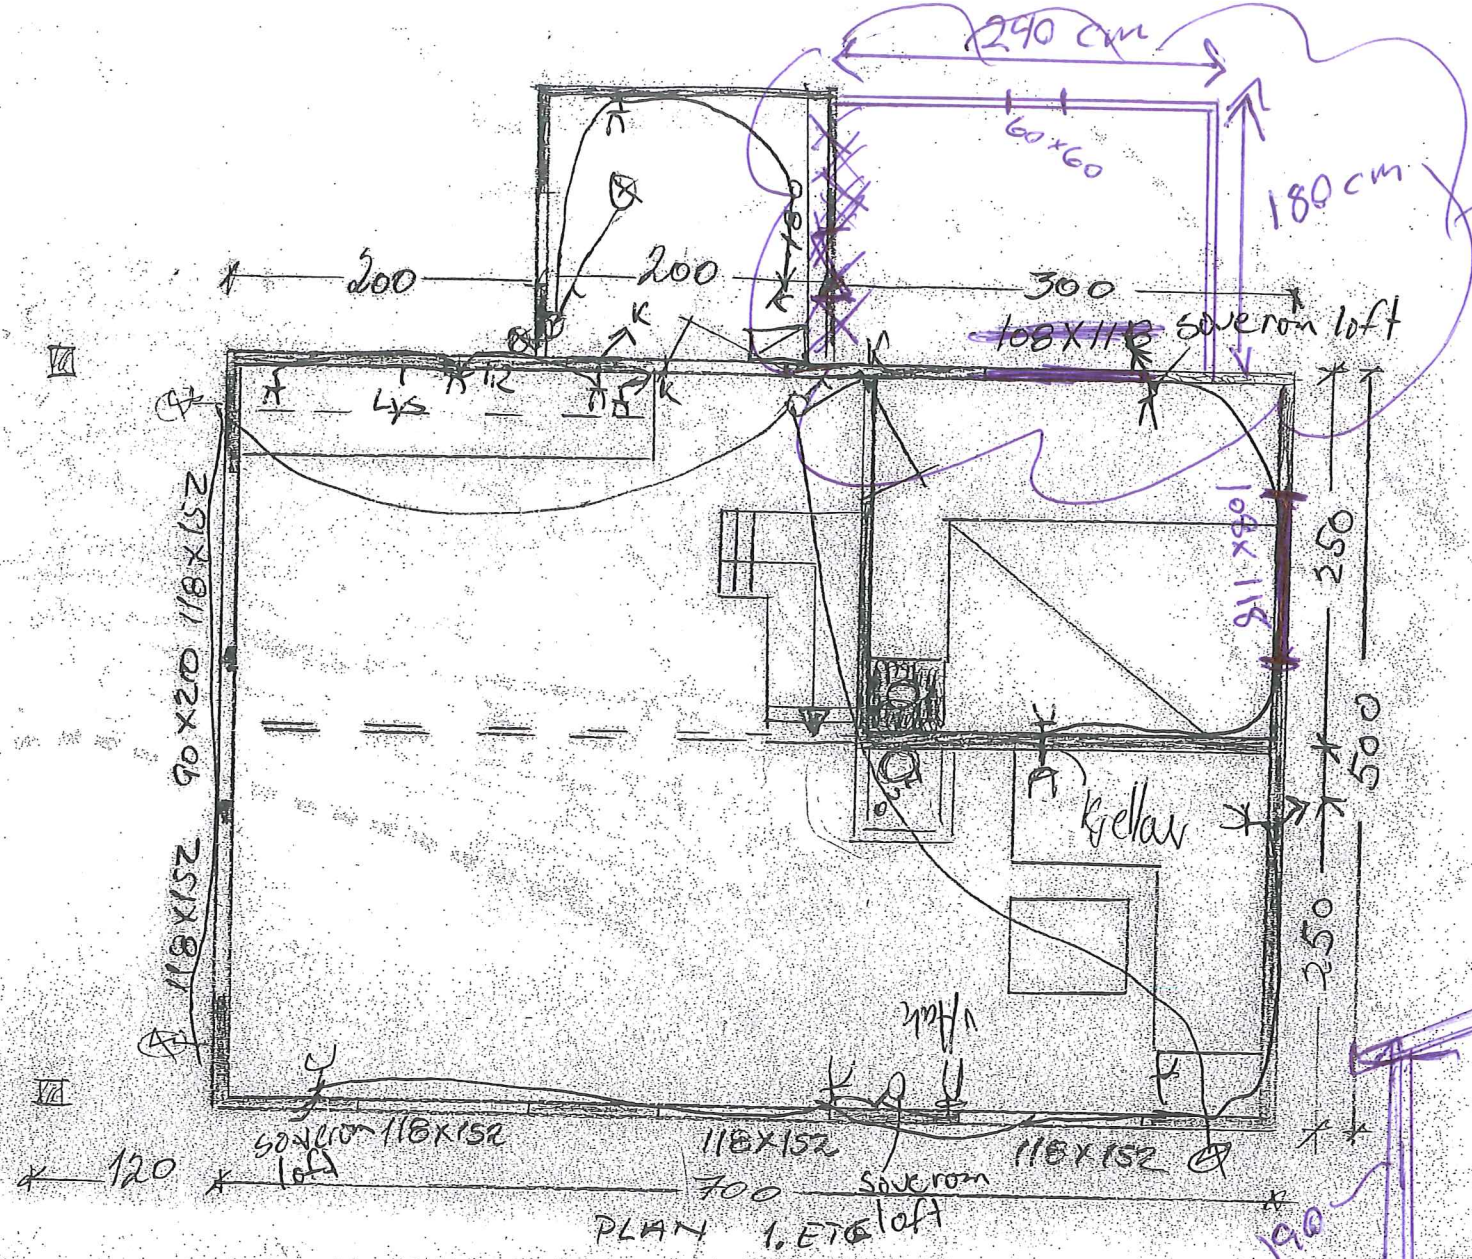

REV:	
M=1:50	
HYTTE GNR II BNR 82	
KNOT WALTHER	
TEGN.	H.M.N. 05.02.2006