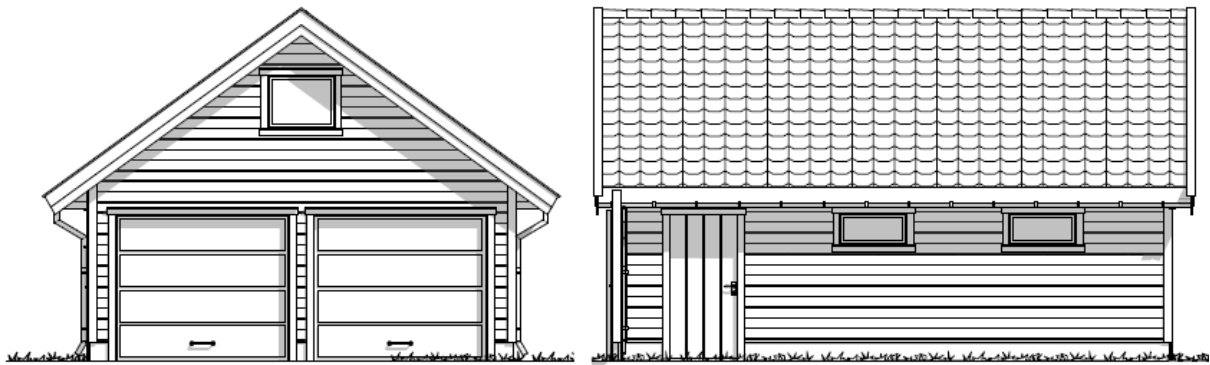

Fra: Bøe, Jan Terje Lagos <Jan.Terje.Lagos.Boe@akersolutions.com>
Sendt: mandag 15. juni 2020 14:10
Til: Postmottak Alver; Postmottak Alver
Emne: Søknad for dispensasjon mot Byggegrense fra kommunal vei.
Vedlegg: Document.pdf

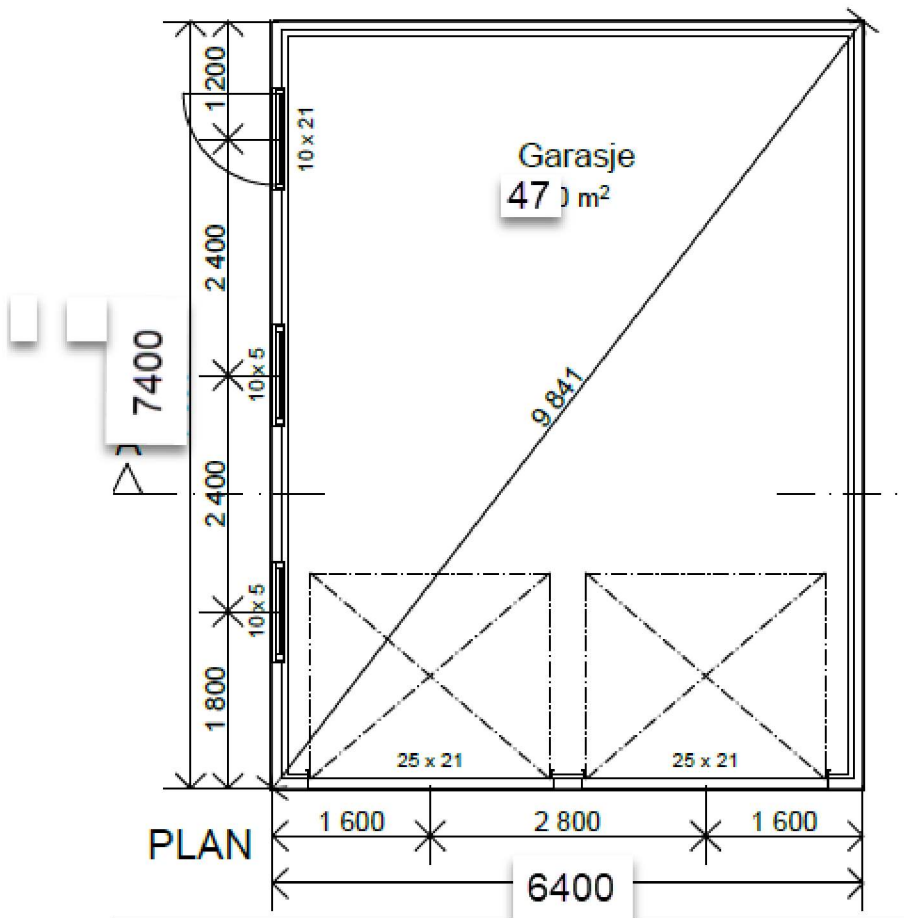
Søknad om dispensasjon mot byggegrense som er 15 m fra midt kommunal vei.

Søknad er vedlagt.

Garasjen legges på linje mot de eksisterende garasjer som er satt opp.

4 meter fra kommunal vei og ca 6 meter fra midt kommunal vei.







Jan Terje Lagos Bøe

HSE, Quality & Risk | JS- Mongstad

Aker Solutions

Mob: +47 926 90 210

Jan.terje.lagos.boe@akersolutions.com | www.akersolutions.com

Aker Solutions AS

Visiting address: Sandslimarka 55, Postal address: P. O. Box 1 Sandsli, NO-5861 Bergen, Norway

Registered in Norway, registration no. 929 877 950 VAT



LIFE-SAVING RULES



This e-mail and any attachment are confidential and may be privileged or otherwise protected from disclosure. It is solely intended for the person(s) named above. If you are not the intended recipient, any reading, use, disclosure, copying or distribution of all or parts of this e-mail or associated attachments is strictly prohibited. If you are not an intended recipient, please notify the sender immediately by replying to this message or by telephone and delete this e-mail and any attachments permanently from your system.