



PLAN

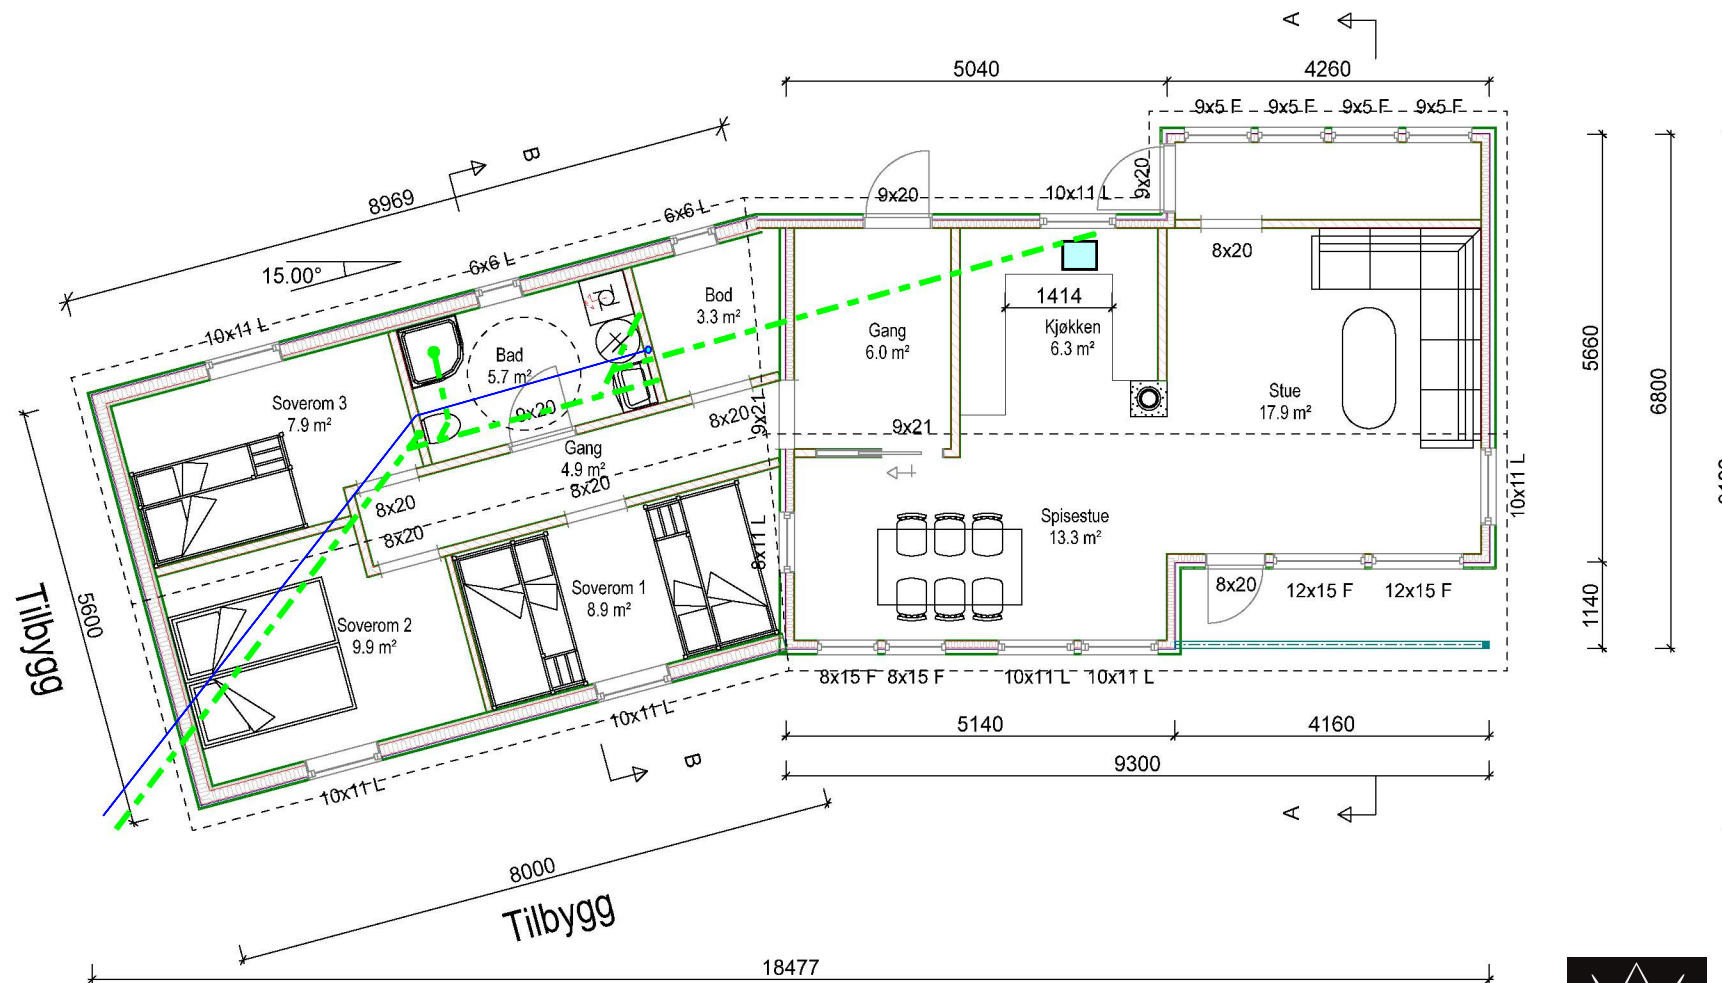


17.02.2020 Einar Stusdal

SNITT A - A

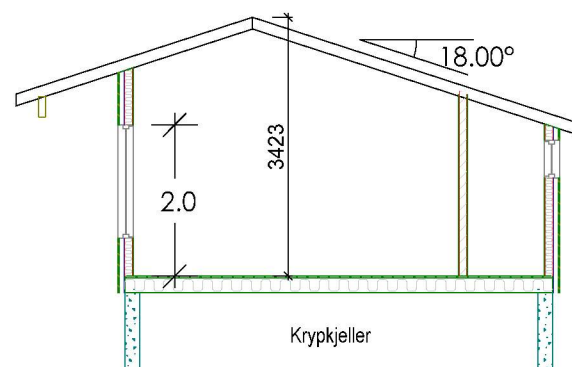

SNITT B - B

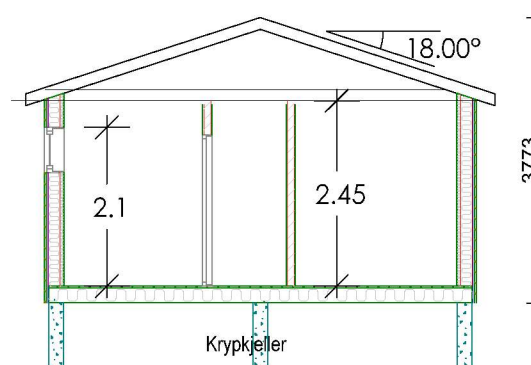

Areal:

BYA Eksisterende hytte: 57,5 m²

BRA Eksisterende hytte: 49,2 m²

BYA Tilbygg hytte : 49 m²

BRA Tilbygg hytte : 43,7 m²

Sum BYA : 106,5 m²

Sum BRA : 92,9 m²

Tilbygg Hytte



Tiltakshaver: **Steinar Korneliussen**

Byggeplass: **Skjelangervegen 930**

Kommune: **Alver**

Gnr: 354 Bnr: 37,49 Mål: 1 : 100 / A3

Plan og snitt



Dato: 03.02.2020

Tegn: RF

Prosjekt nr.:

Tegn.nr.: 501

Hytte Korneliussen