


303085
722048

303293
X 67220

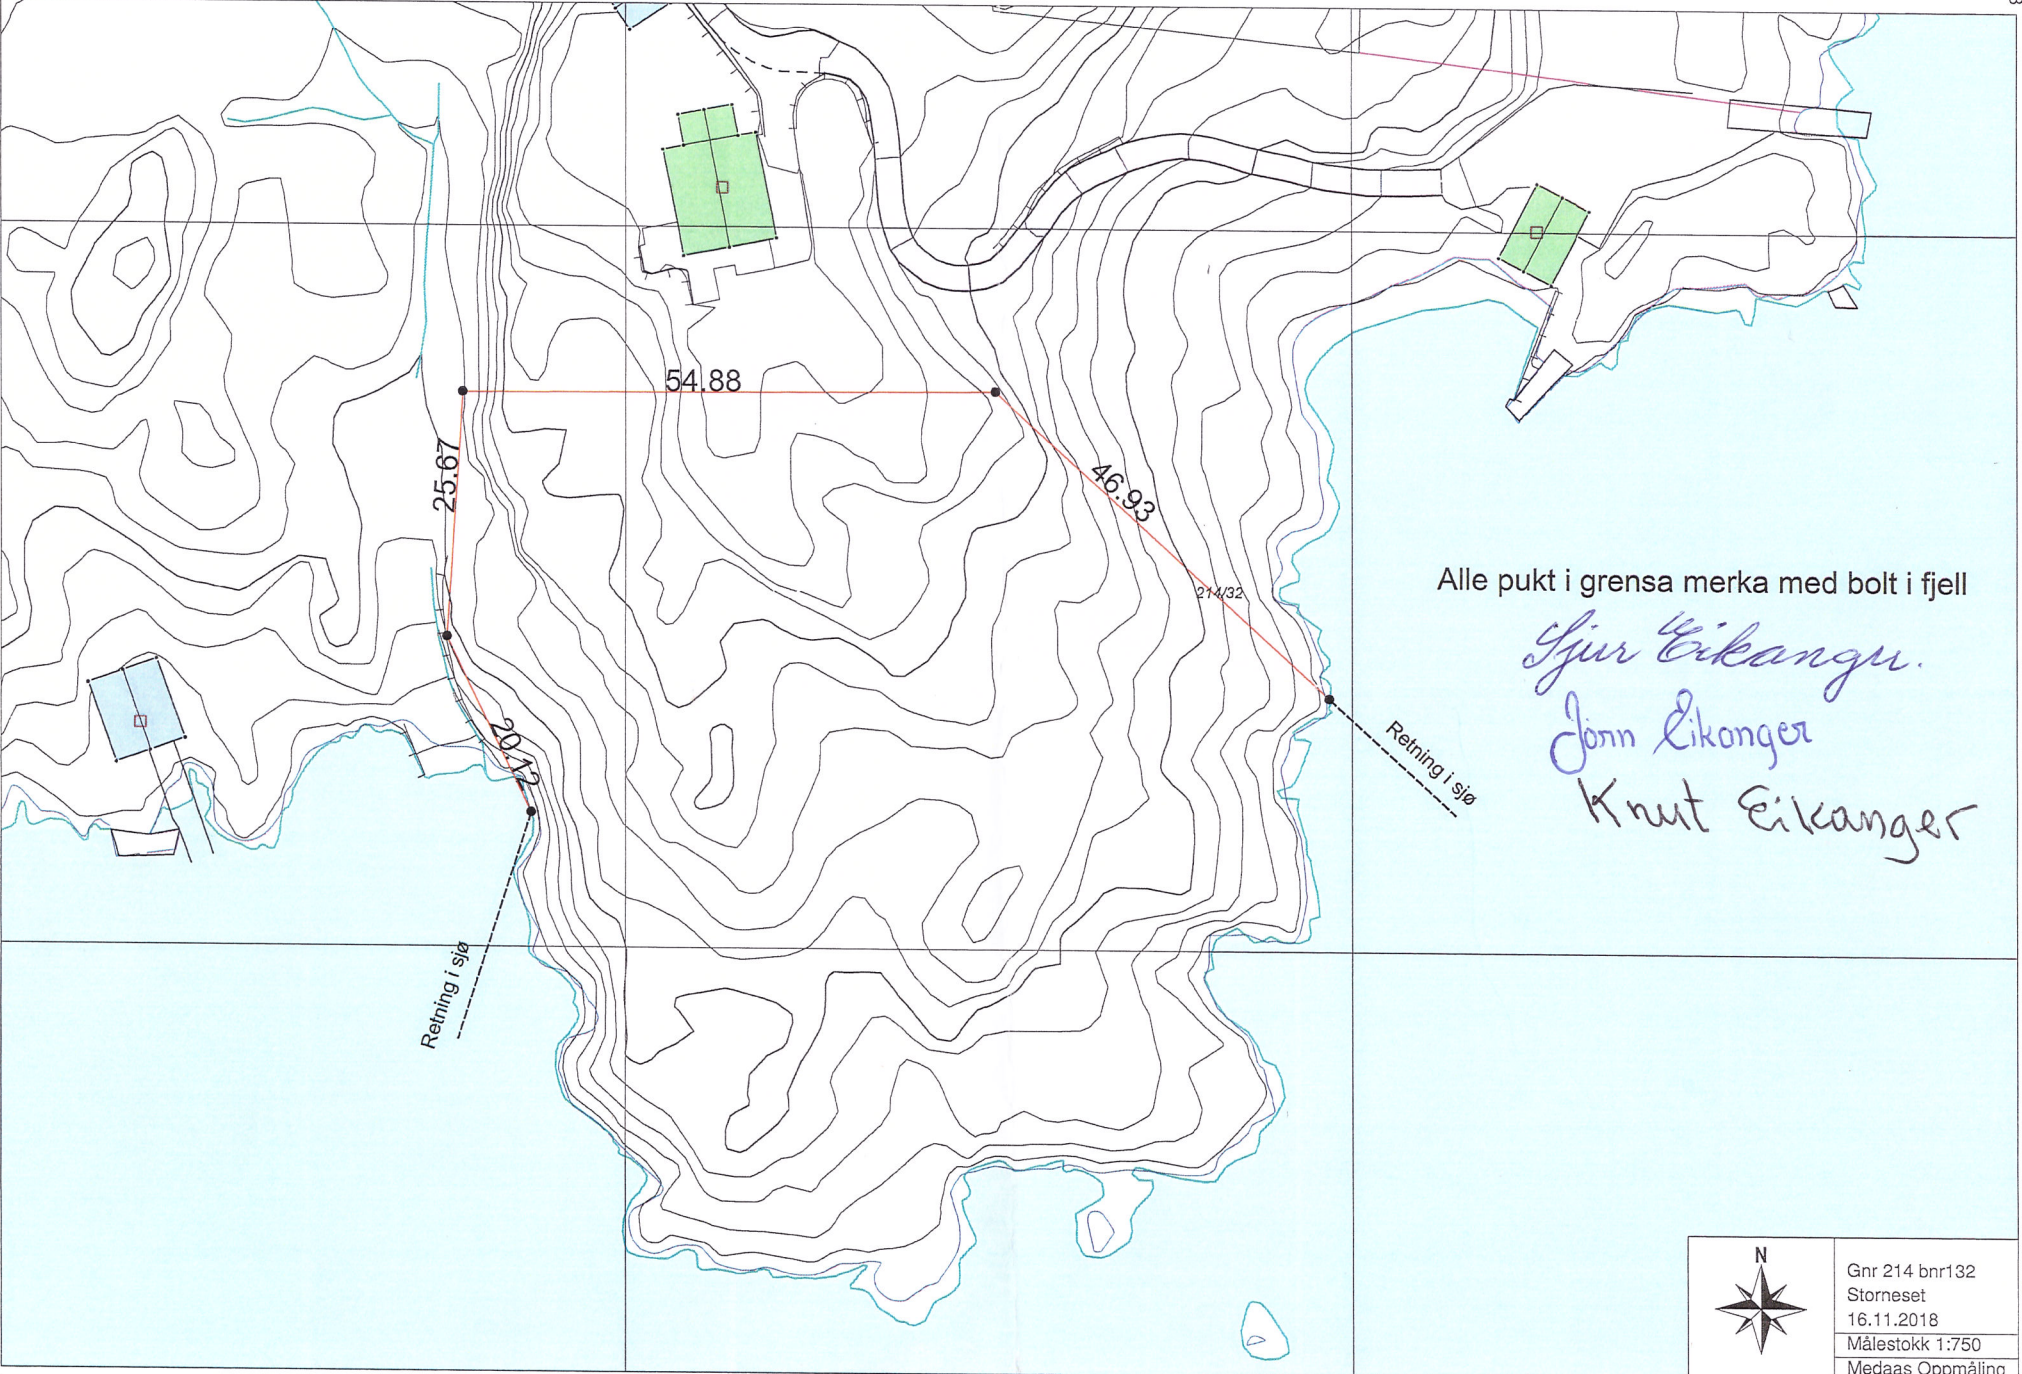

Alle punkt i grensa merka med bolt i fjell

*Sjur Eikanger.
Jonh Eikanger
Knut Eikanger*



Gnr 214 bnr132
Storneset
16.11.2018
Målestokk 1:750
Medaas Oppmåling

721906
30308

30329
X 67210