




E-1
(schnitt)

VEST
1:100

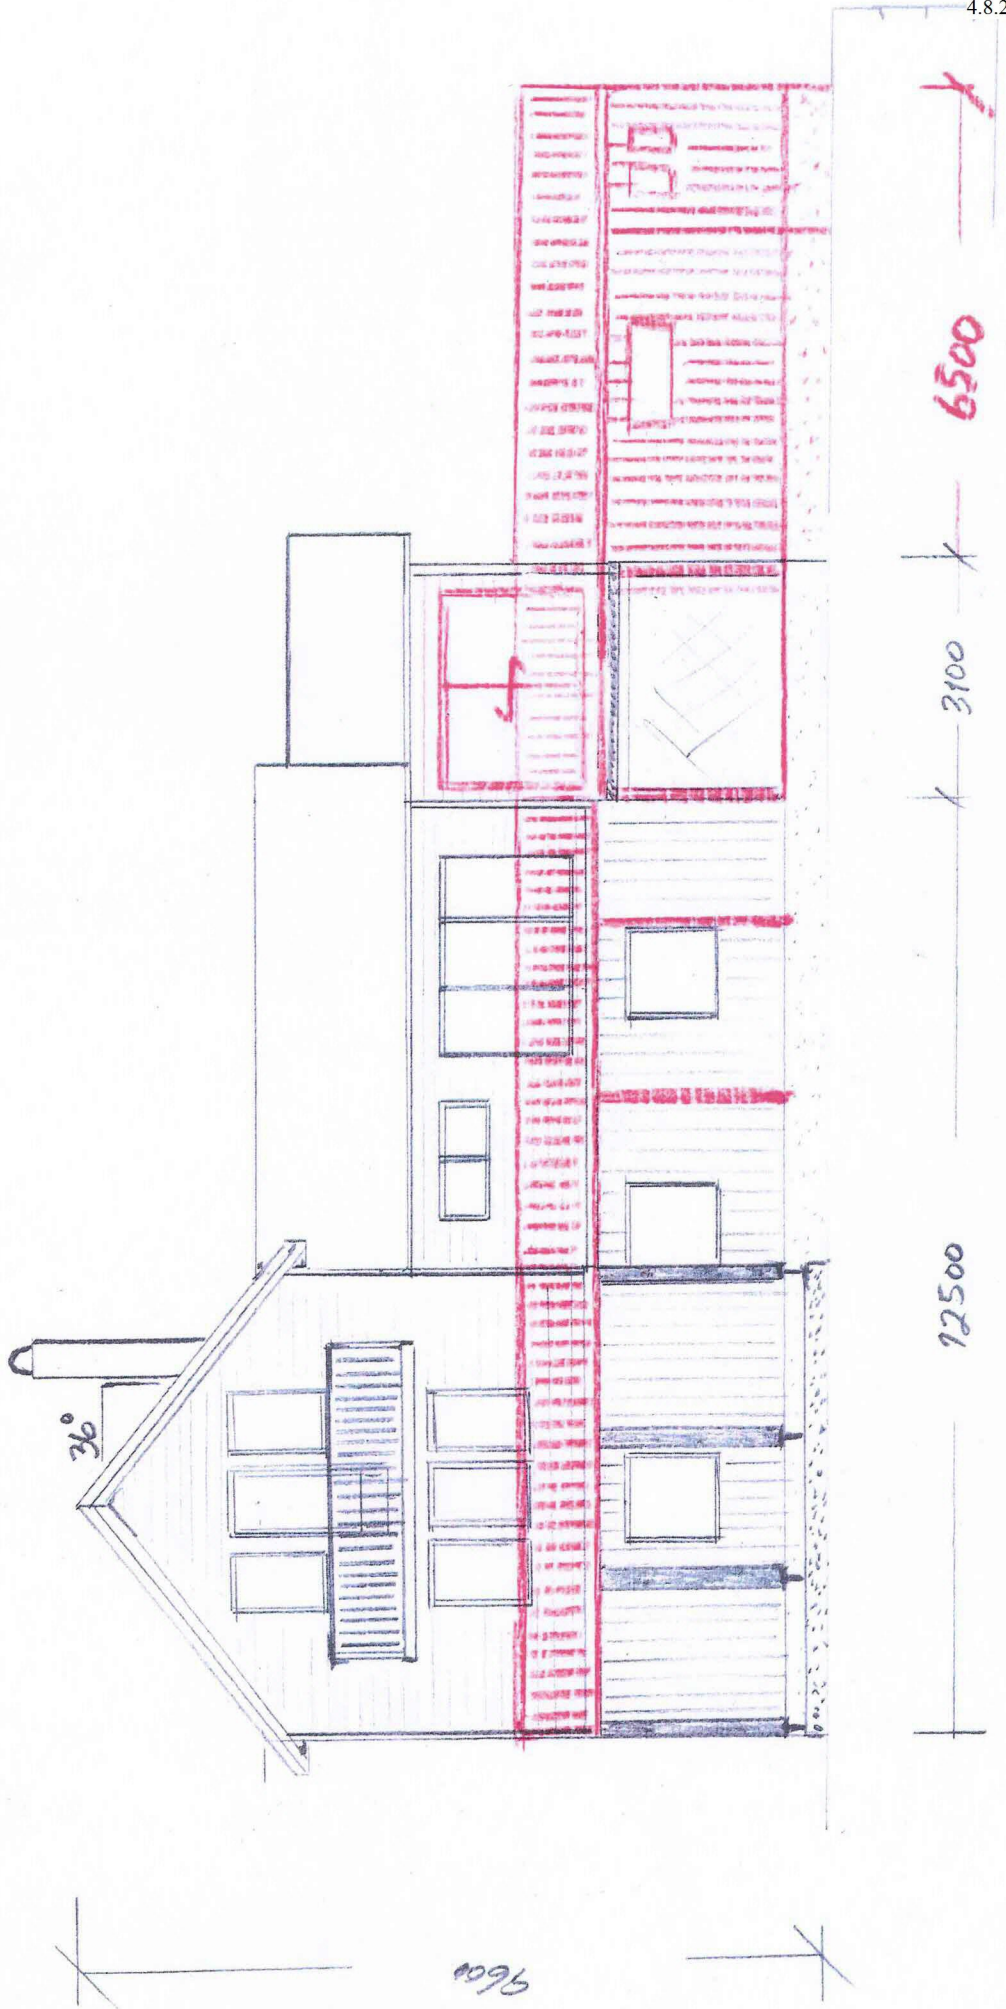

E-2 (snitt) ØST
1:100

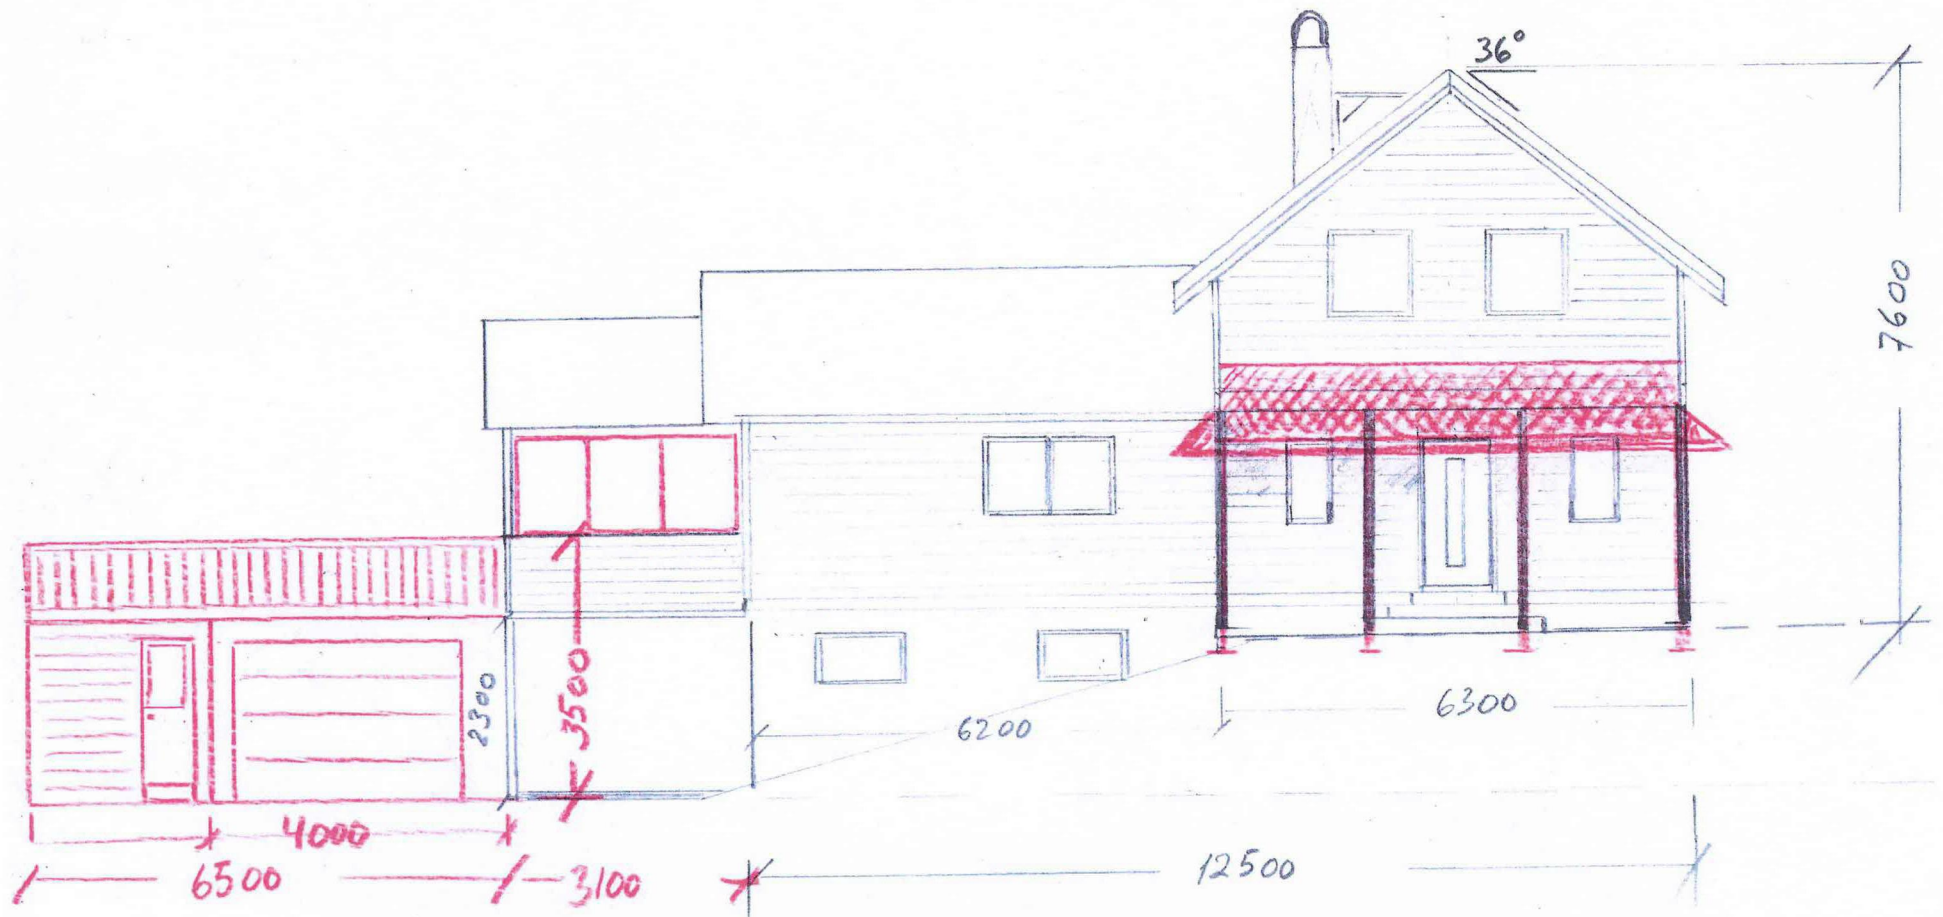

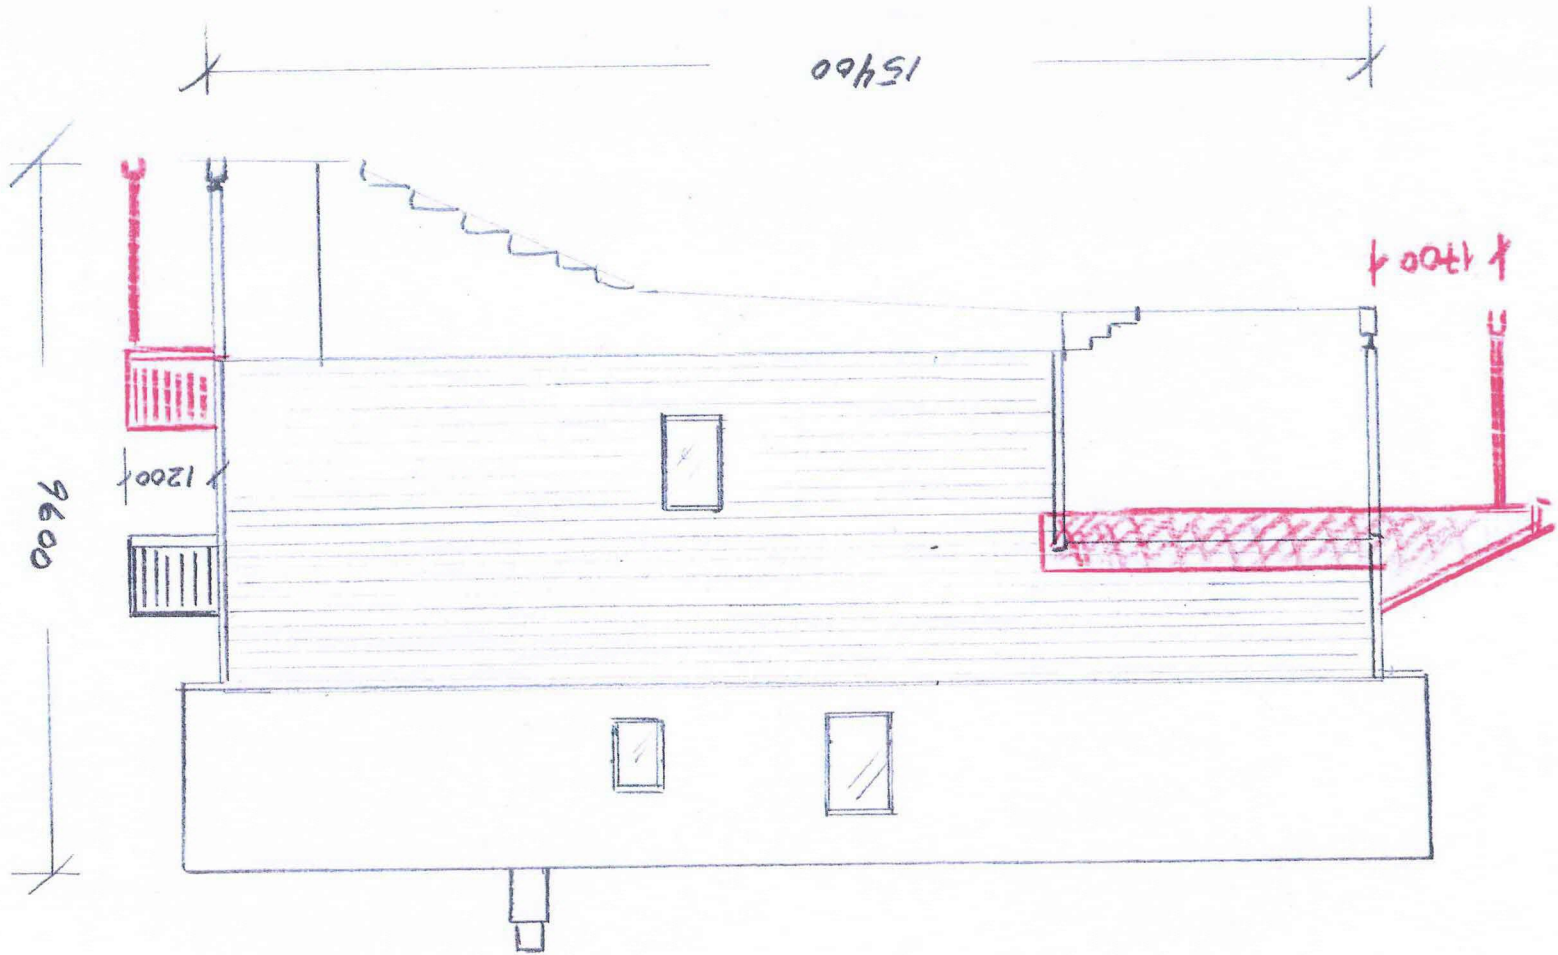

15400


9600

1200

1700

NORD
1:100

E-3
(sw.H.)

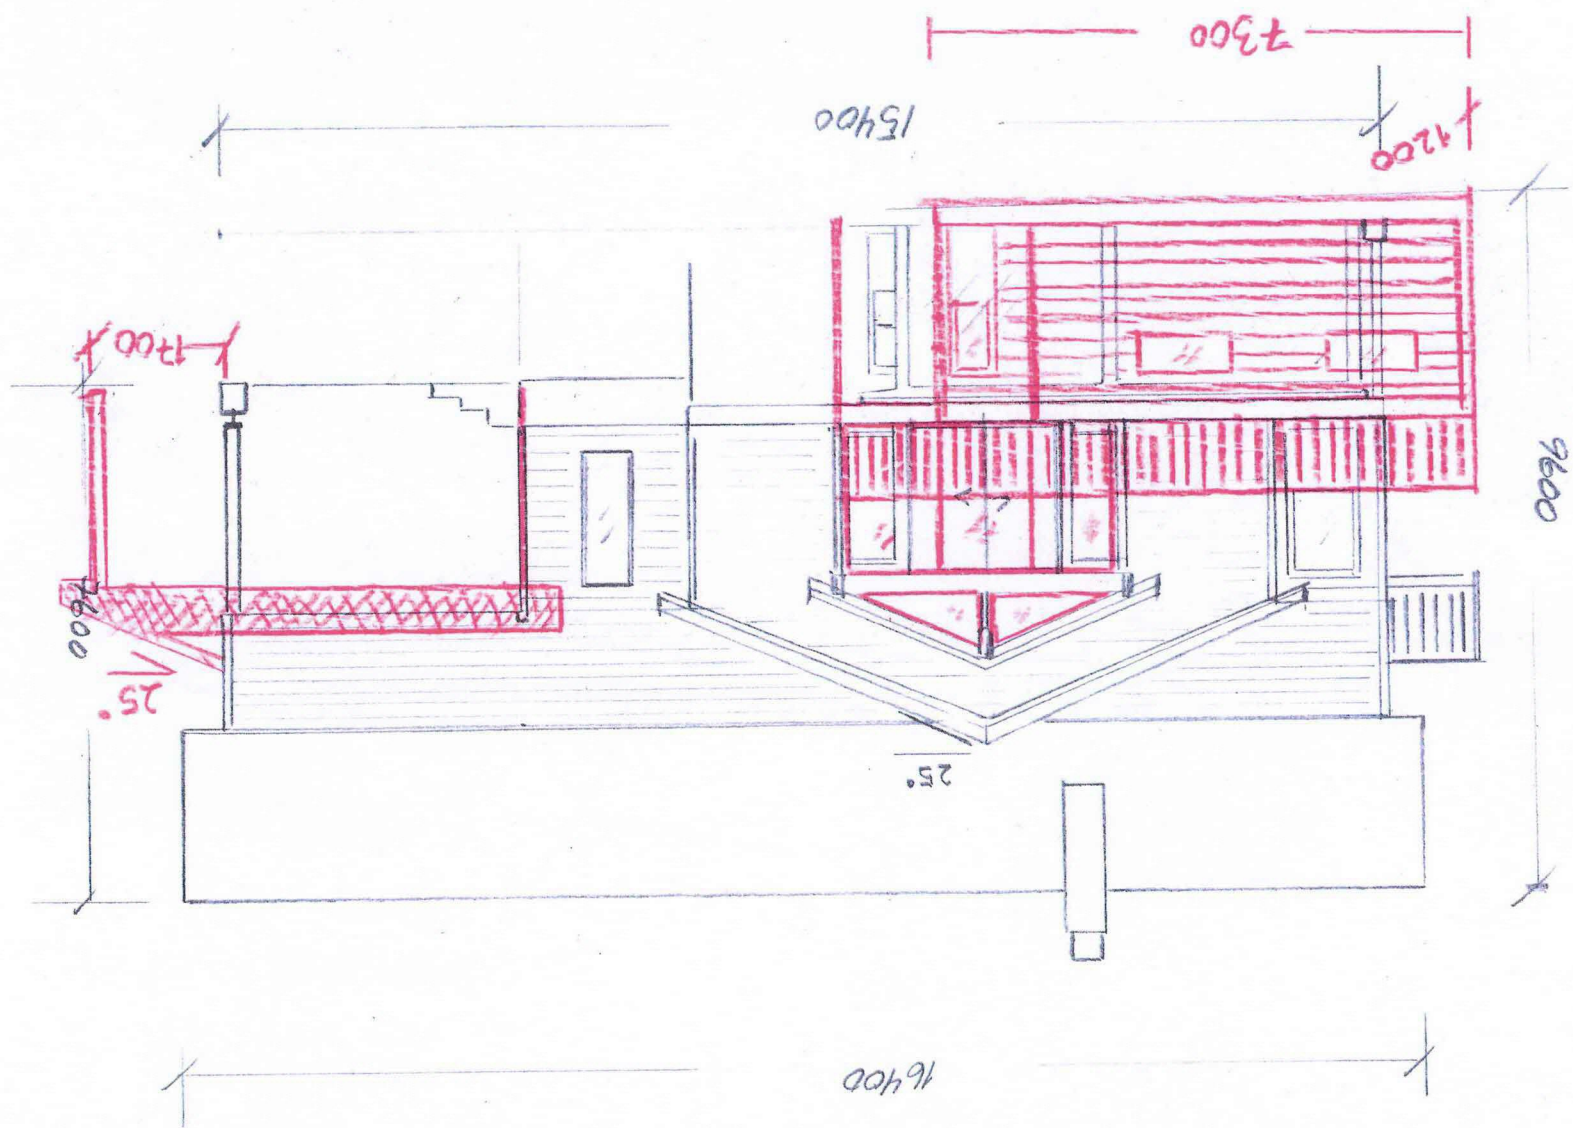

1:100
S&R

E-4
(SWH)