



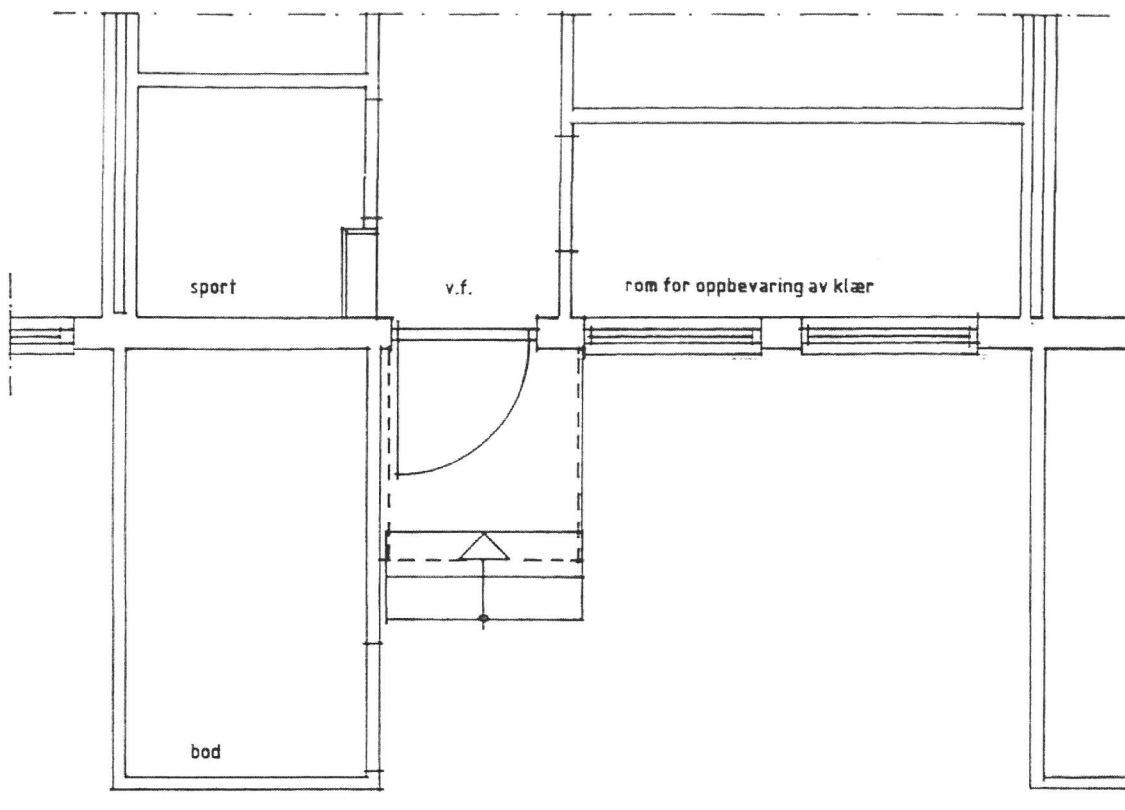

Eksist. plan

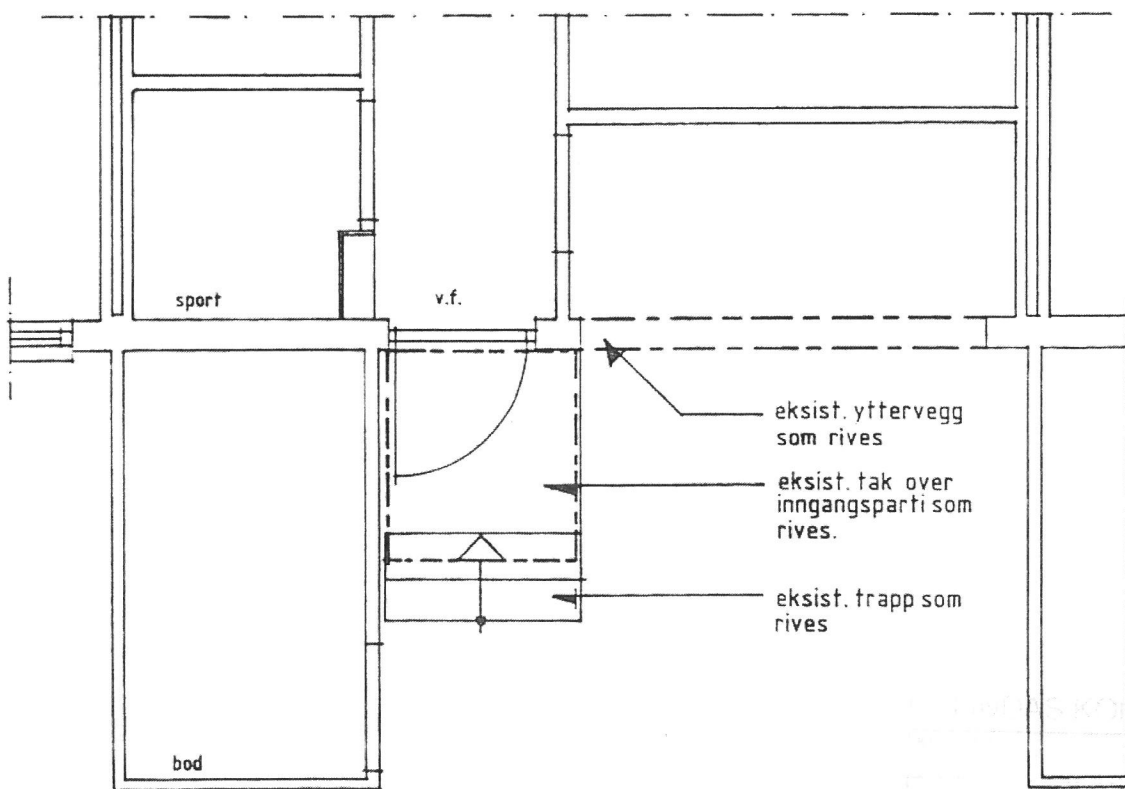

Riveplan

188/281
14.02.2013
Ark. saksnr. 2013/295
Saksh. Tilgangskode

LYNGMARKA
BORETTSLAG
forslag til tilbygg
på inngangsside

planutsnitt eksist.
plan
riveplan
m=1:50

dato
23.06.97
alternativ
1


Fredensborgvn 24G
N-0177 Oslo

SVEIN JACOBSEN
SV AK BDA

LIT 47-2236-1750
fax 47-2236-1753