


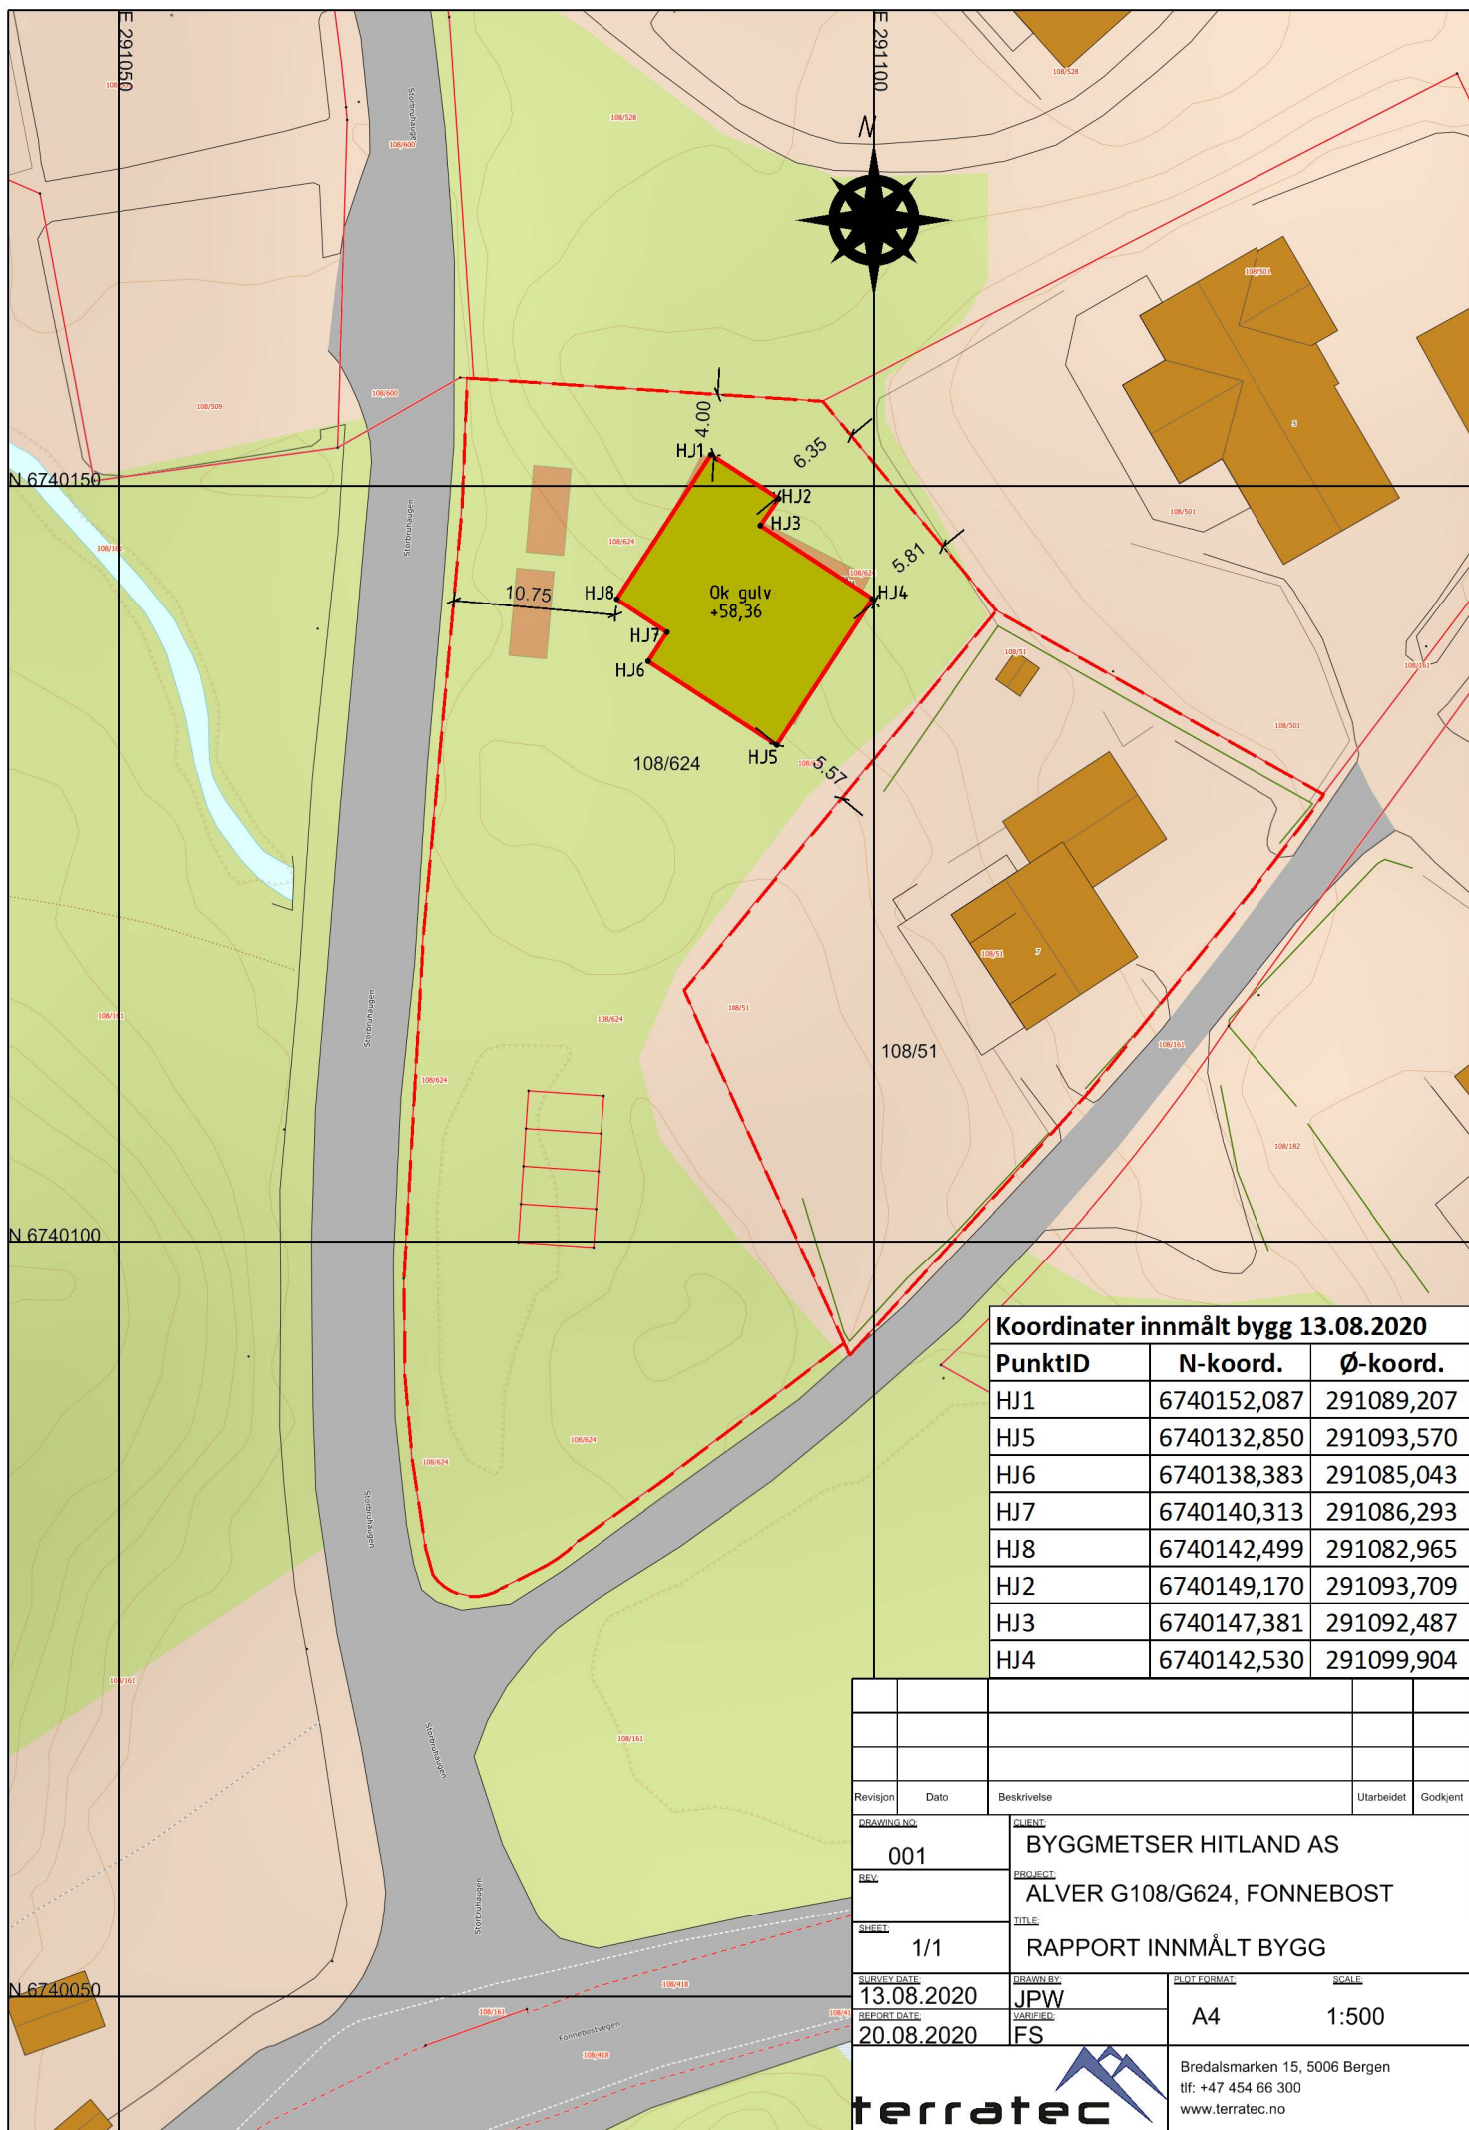

Koordinater innmålt bygg 13.08.2020

PunktID	N-koord.	Ø-koord.
HJ1	6740152,087	291089,207
HJ5	6740132,850	291093,570
HJ6	6740138,383	291085,043
HJ7	6740140,313	291086,293
HJ8	6740142,499	291082,965
HJ2	6740149,170	291093,709
HJ3	6740147,381	291092,487
HJ4	6740142,530	291099,904

Revisjon	Dato	Beskrivelse	Utarbeidet	Godkjent
DRAWING NO.	001	CLIENT	BYGGMETSER HITLAND AS	
REV.		PROJECT	ALVER G108/G624, FONNEBOST	
SHEET	1/1	TITLE	RAPPORT INNMÅLT BYGG	
SURVEY DATE	13.08.2020	DRAWN BY	JPW	PLOT FORMAT
REPORT DATE	20.08.2020	VARIFIED	FS	SCALE
				A4 1:500



Bredalsmarken 15, 5006 Bergen
tlf: +47 454 66 300
www.terratec.no