


8/7-20
H.S.

D-1

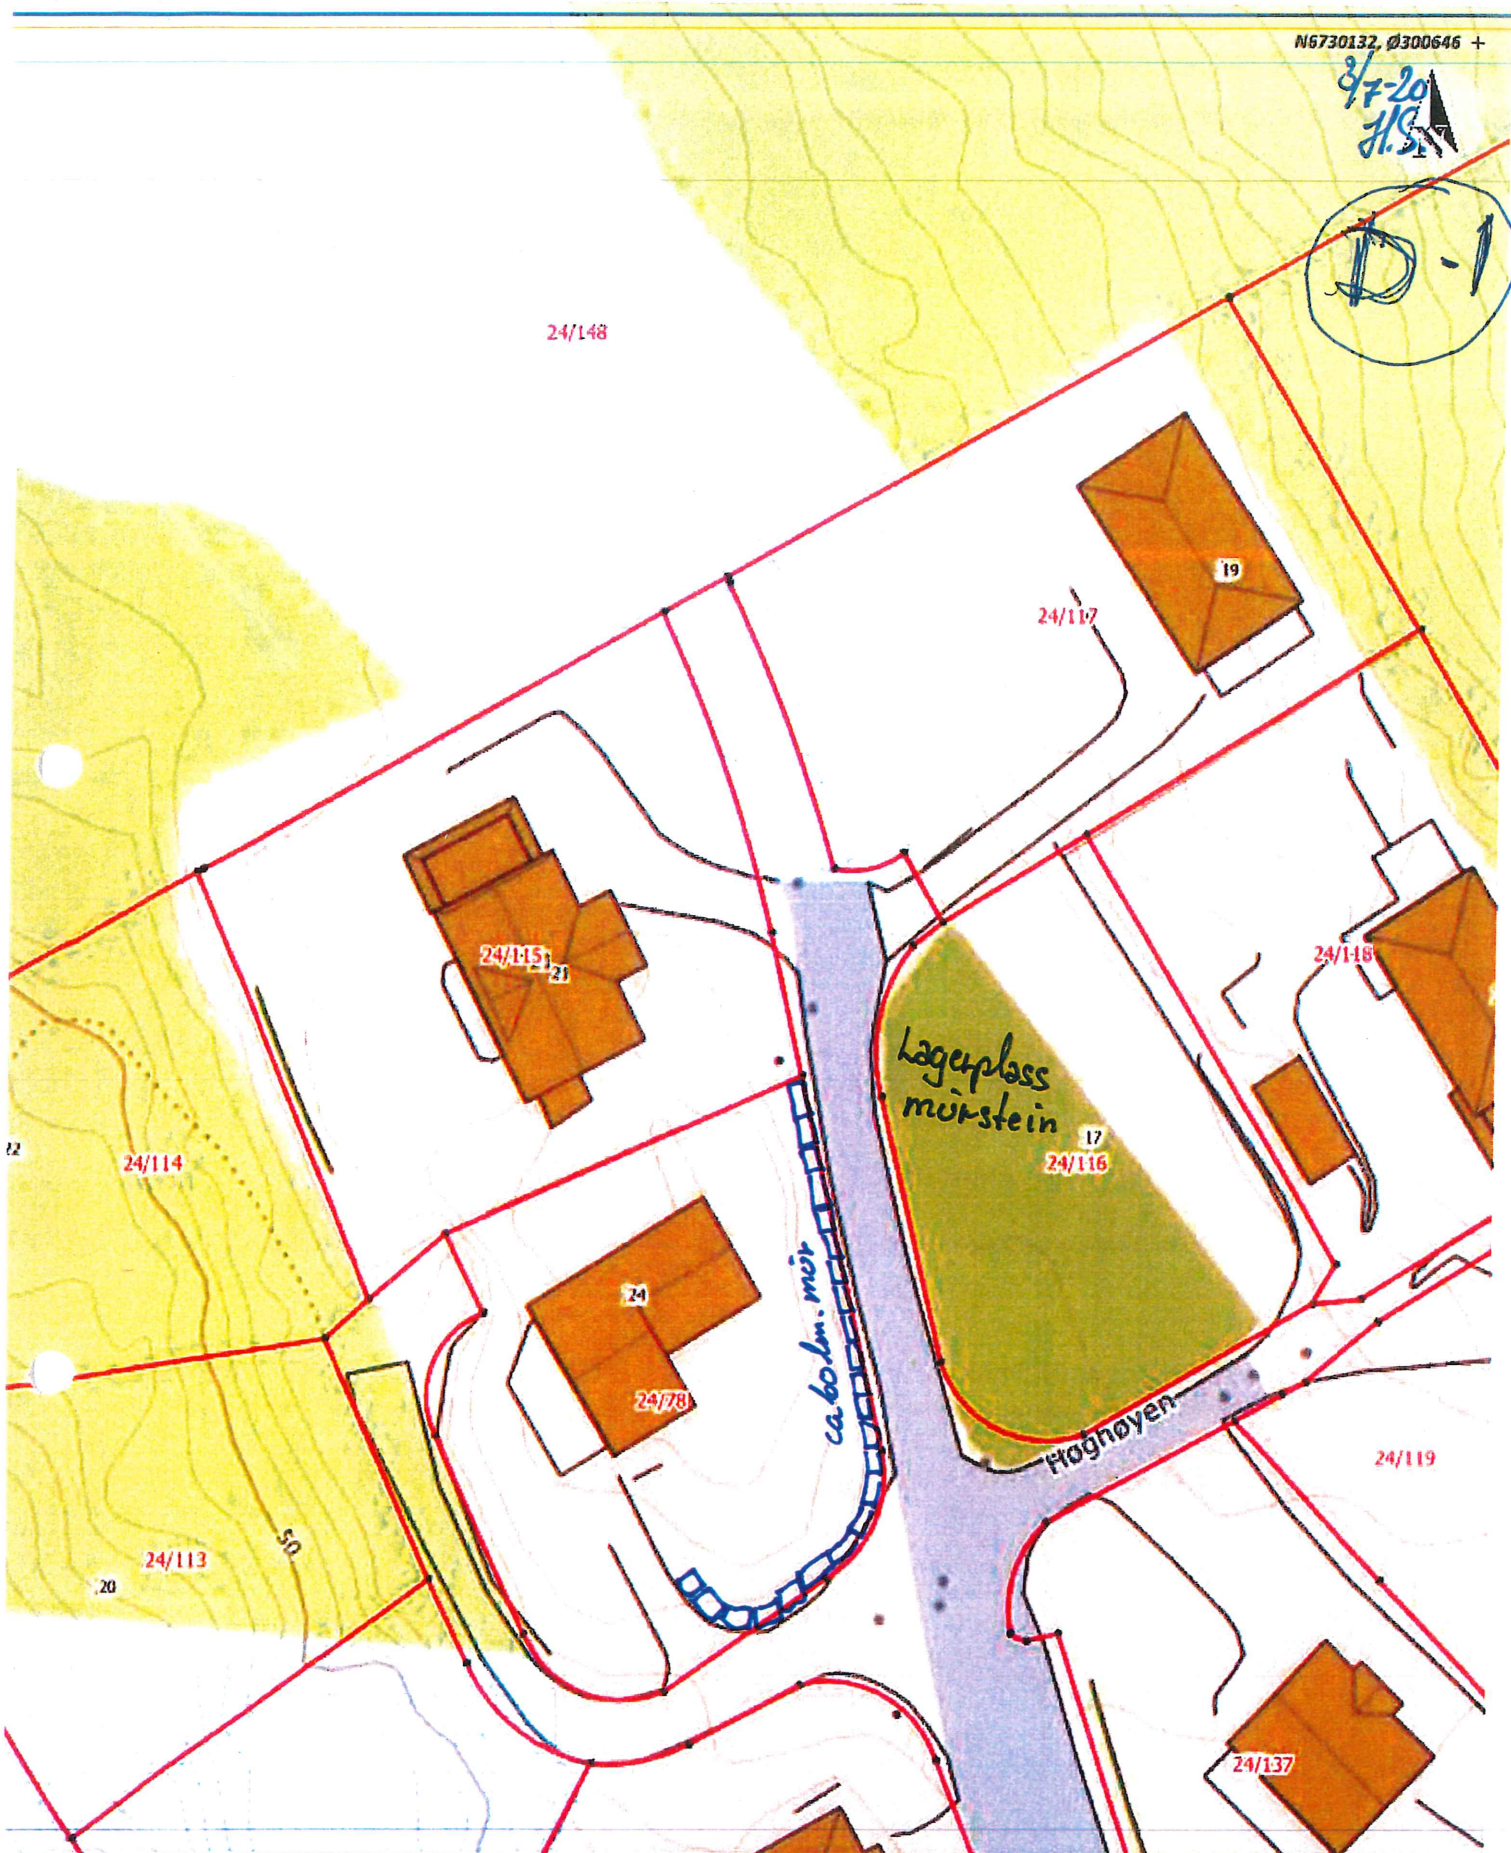

Situasjonskart -

H. SANDVIK A/S
Entreprenør

Ndigi.no

Dato: 03-07-2020

Målestokk: 1:500

15m


D-2

