




Lindås kommune
Målestokk 1:500

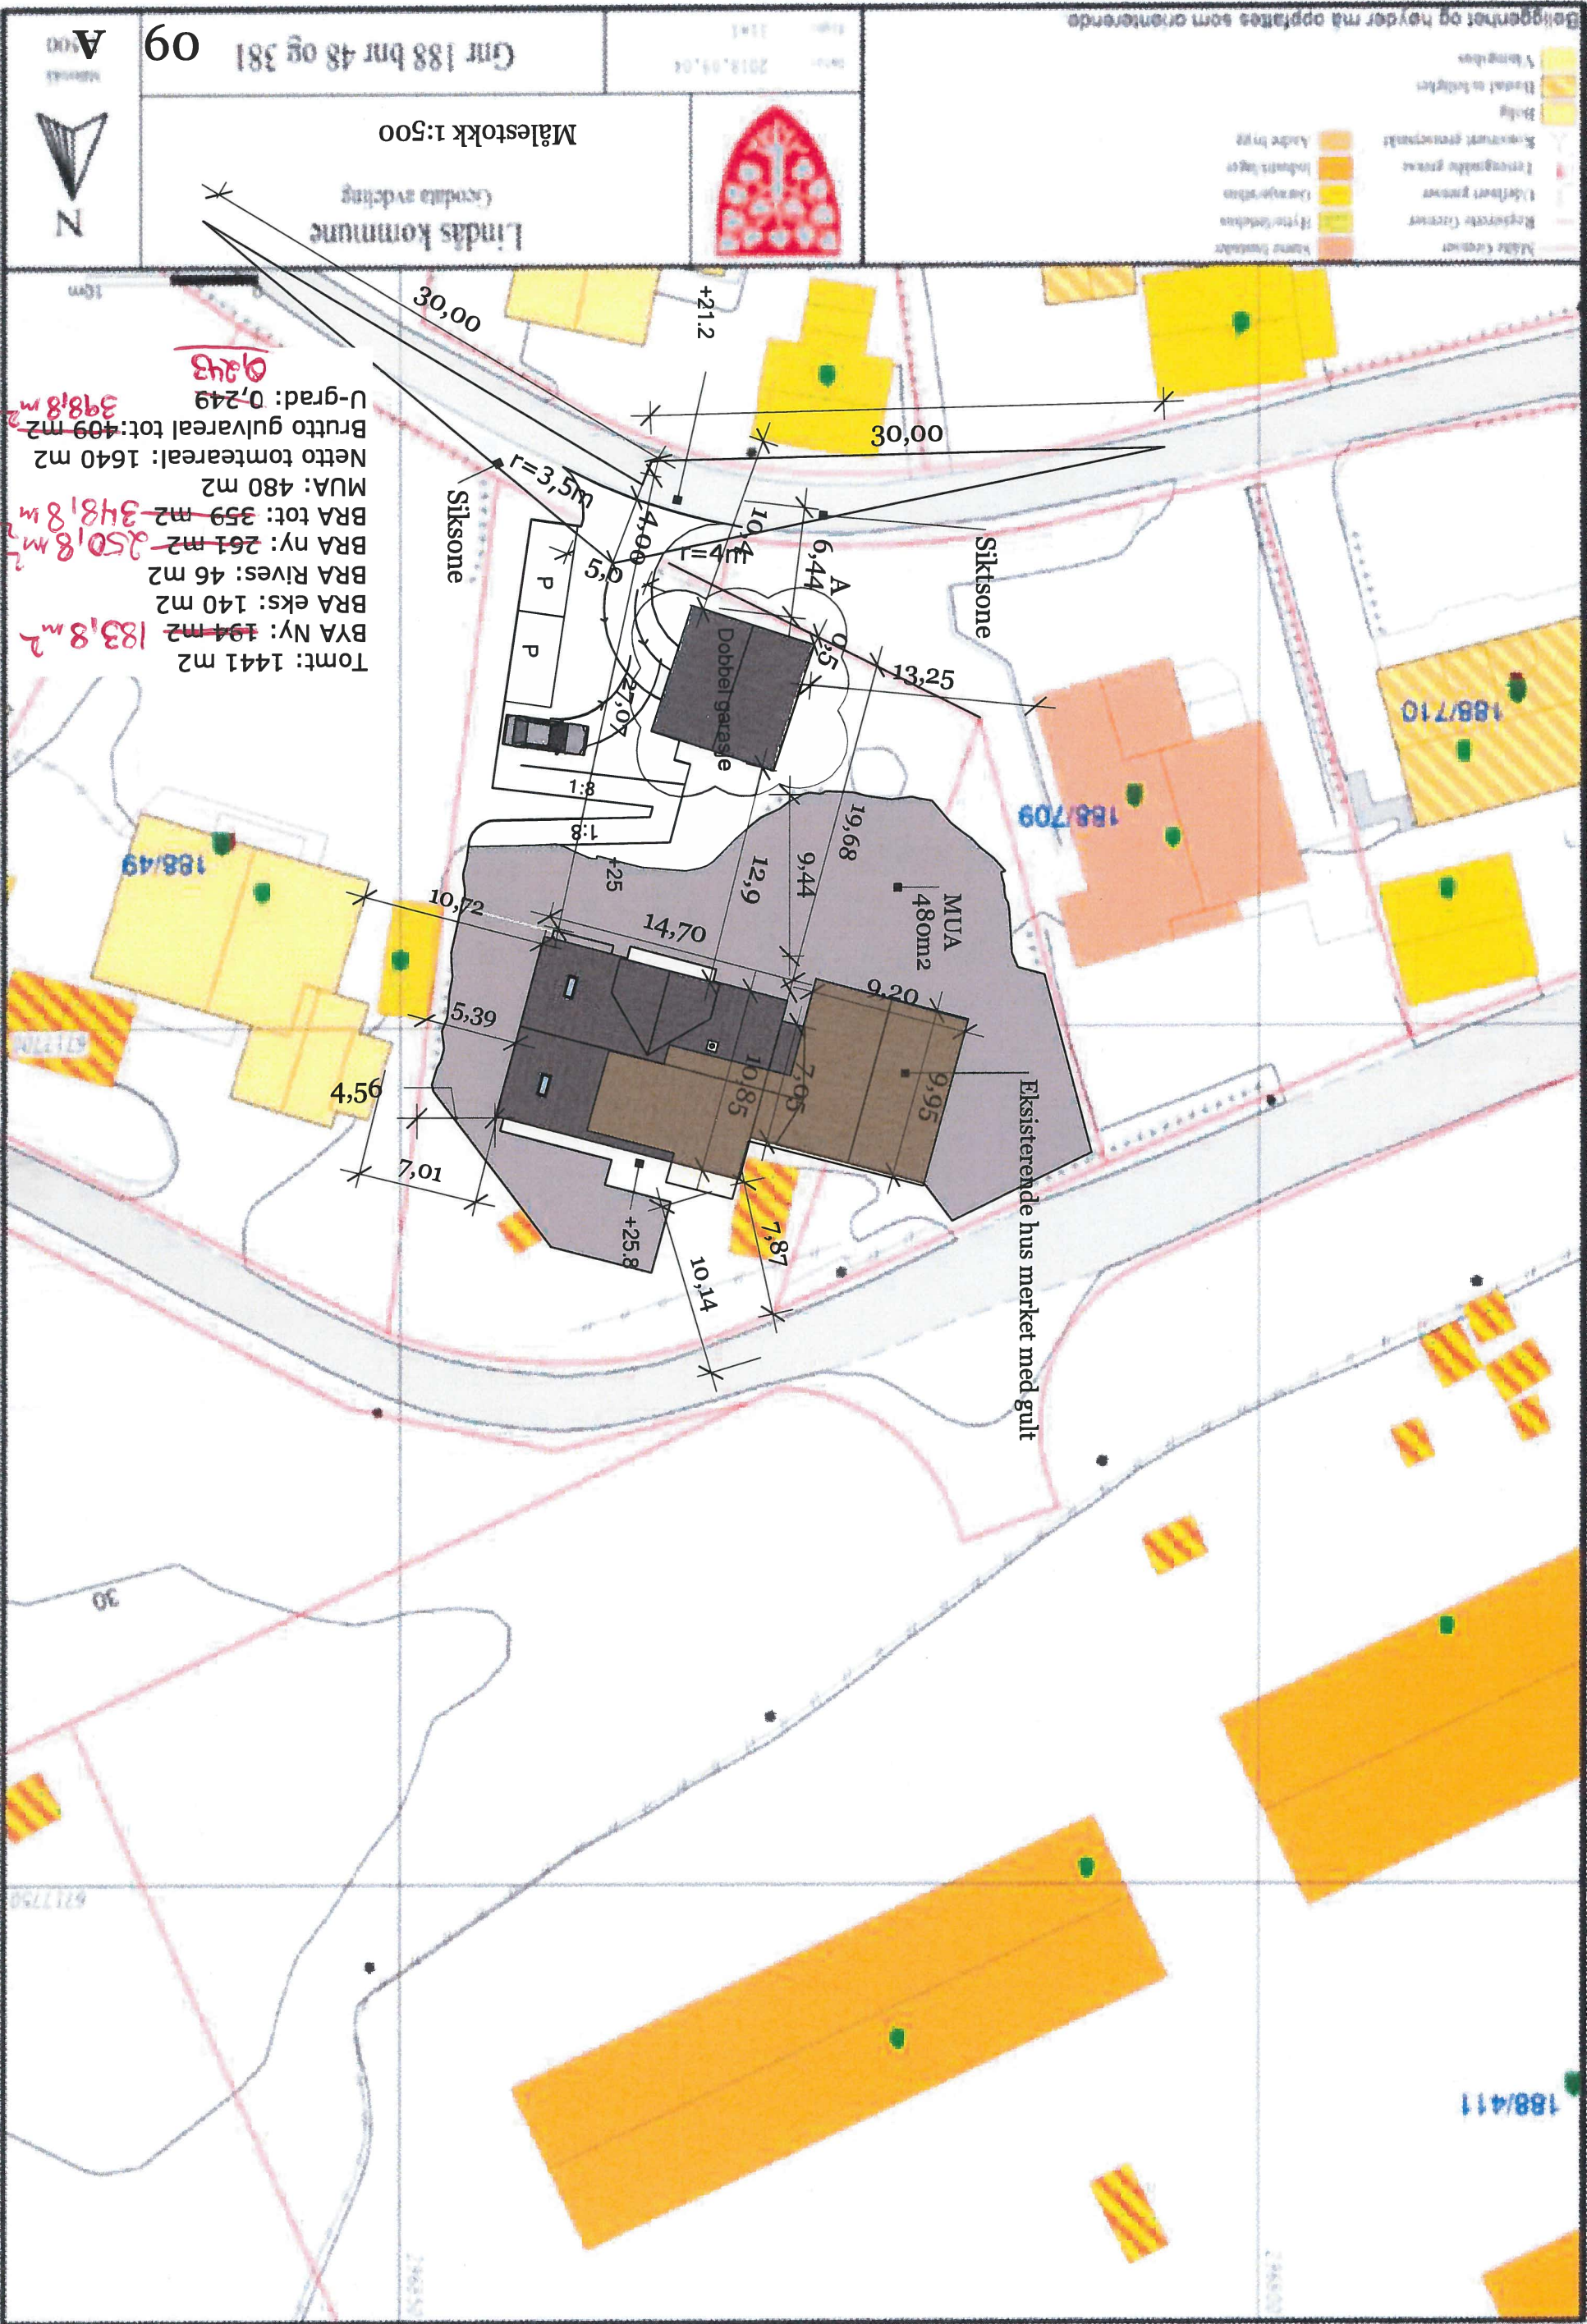

Tomt: 1441 m²
BYA NY: 194 m² 183,8 m²
BRA eks: 140 m²
BRA Rives: 46 m²
BRA NY: 261 m² 250,8 m²
BRA tot: 359 m² 348,8 m²
MUA: 480 m²
Netto tomteareal: 1640 m²
Brutto gulvareal tot: 409 m² 398,8 m²
U-grad: 0,249 0,343

D2