

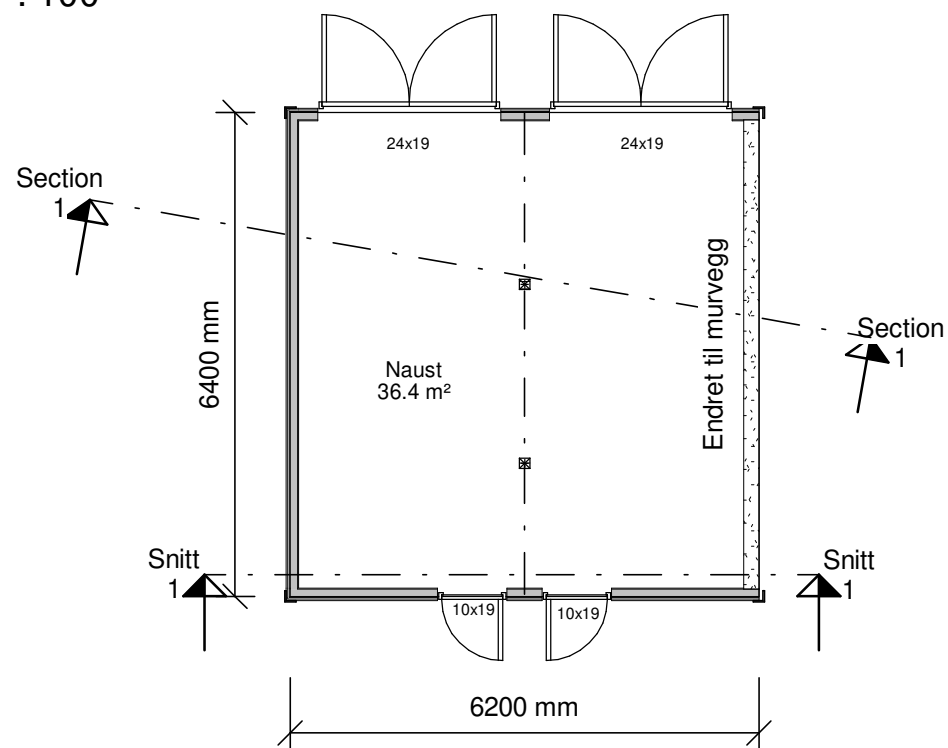



Naust
1 : 100

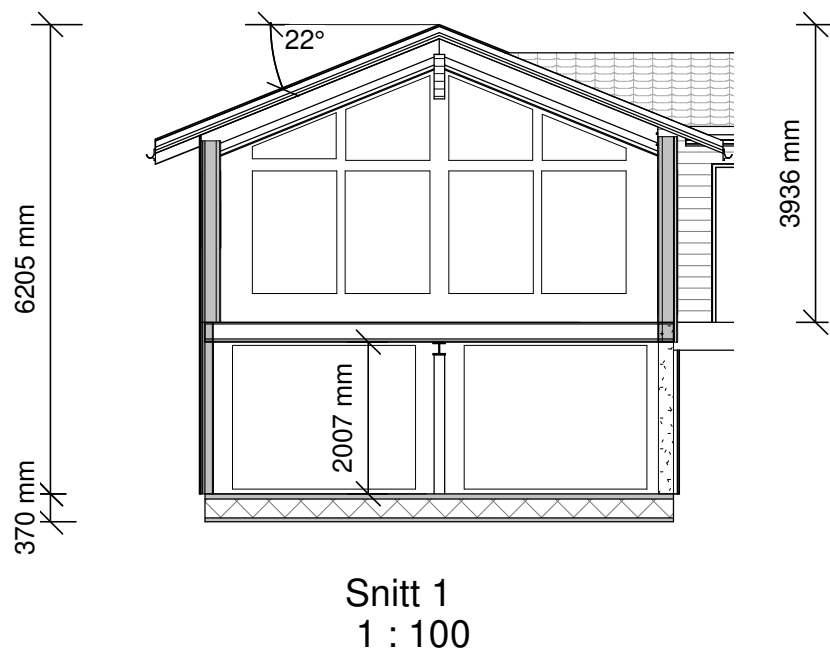

Hytte
1 : 100

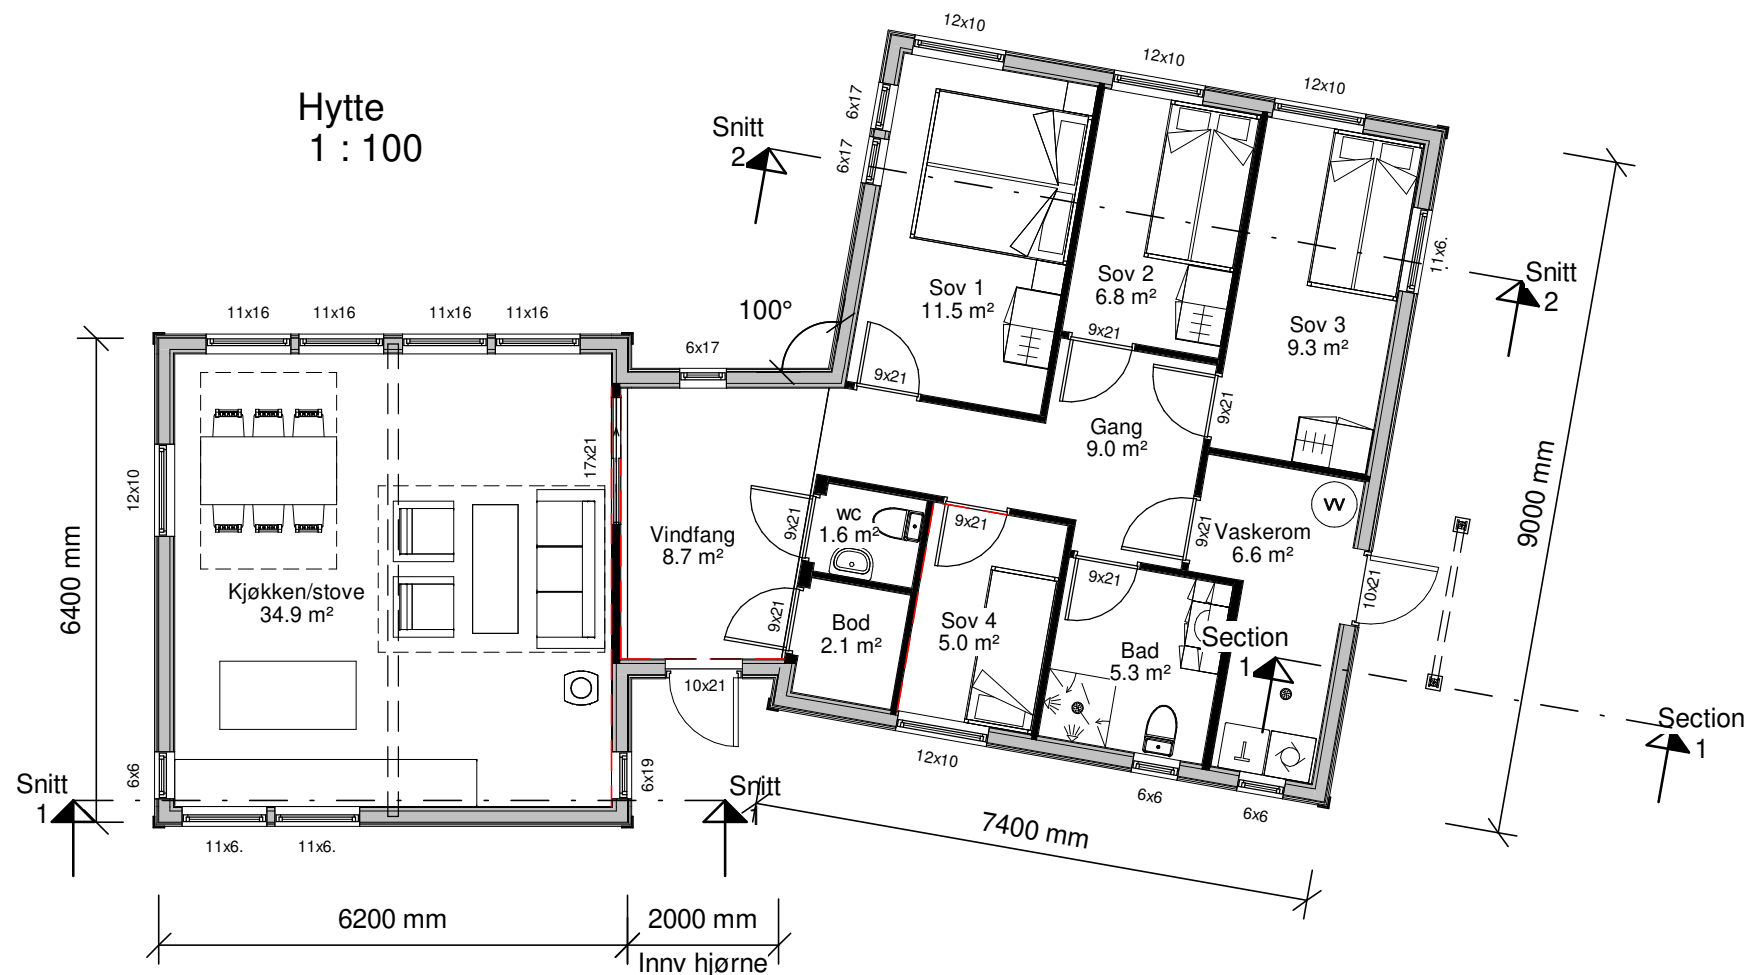

Snitt 1
1 : 100

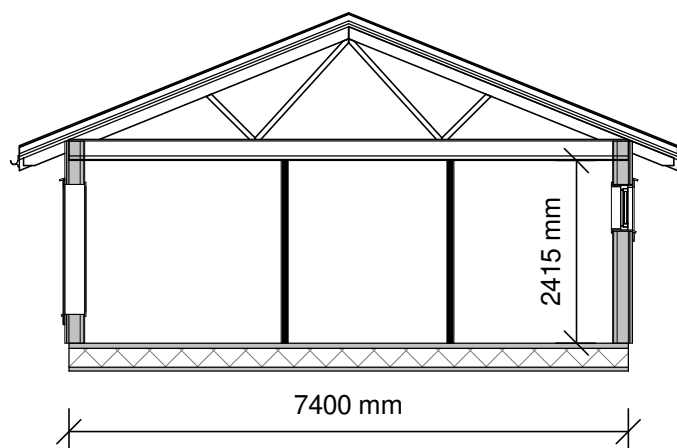

Snitt 2
1 : 100

BYA	121 m ²
-----	--------------------

BRA	
Areal	BRA

105.4 m ²	BRA	Hytte
36.4 m ²	BRA	Naust
141.7 m ²		

REV.	DATO	REVISJON	SIGN.
A	14.02-20	Vindu størrelser	ET
B	26.03-20	Skråvindu / Vridd Hytte	ET
C	02.04.20	Endre 1 stk vegg i Naust til murvegg	ET
D	04.05.20	Endret vinduer Stove	ET

Kålås Bygg AS
Torvhusmyrane 2, 5913 Eikangervåg
MESTERHUS

TILTAKSHAVER: Lise Olsmo Oen
BYGGEPLASS: Solberget
G.nr/B.nr: 245/ 9 og 14
KOMMUNE: Alver

TEGN, INNHOLD: Plan og Snitt
TILTAKSART: Hytte
MÅL: 1 : 100
PROSJEKT: **Hytte Solberget**
ARKITEKT: Espen Tvedt
DATO: 30.05.2018
TEGN: ET
PROSJEKT NR: **8008**
TEGN.NR: **09.3**