


TERRENGSNITT - NY KOTEHØYDE +0,4m

A-A

TAULE
 ING. TAULE AS
 Tlf. 56 35 85 55 - Mob. 908 66 010
 18/8-20

TOMTEGRENSE
I VEST MOT 212/102

BUSTAD VERT
 TRUKE INN
 MOT AUST.
 NY AVSTAND TIL
 TOMTEGRENSE
TAULE
 ING. TAULE AS
 Tlf. 56 35 85 55 - Mob. 908 66 010
 18/8-20

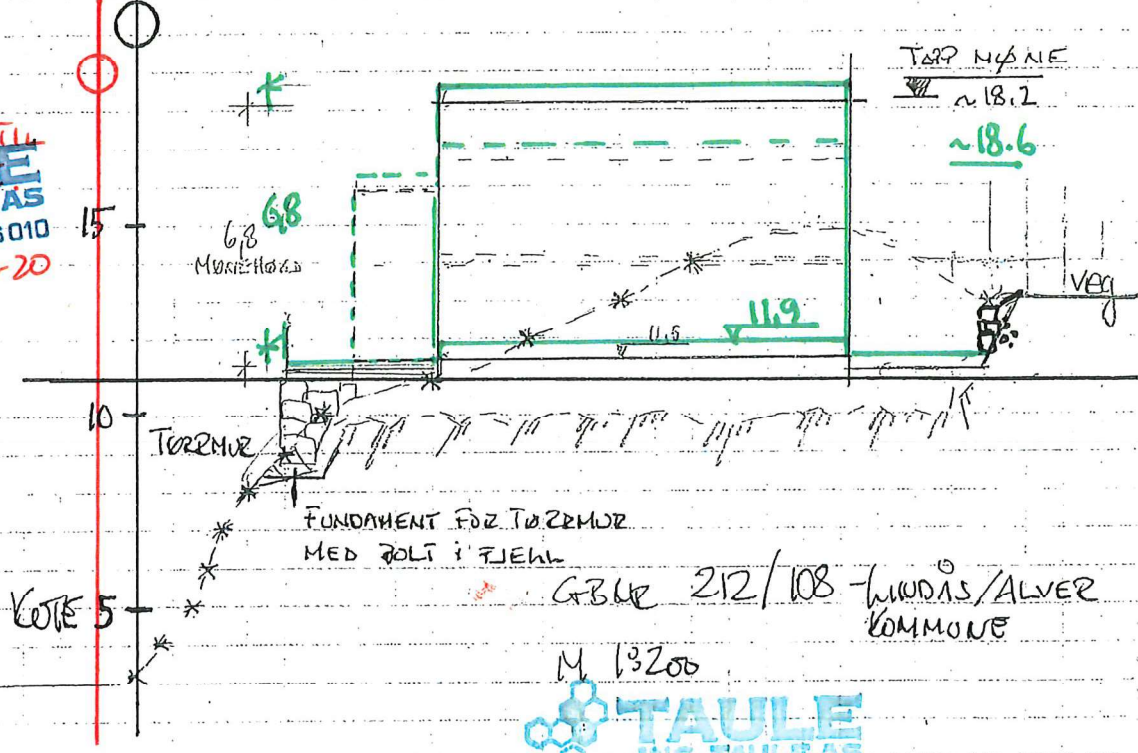

GBL 212/108 - LINDAS/ALVER KOMMUNE

M 13200

TAULE
 ING. TAULE AS
 Tlf. 56 35 85 55 - Mob. 908 66 010

18/11-19

Per Arne Hagen

INGEN ENDRING
 FOR GARASJE.
 18/8-20

B-B

