




Radøy, gnr 45 bnr 469 (Alver 445/469)  
Innmålt grunnmur

21.04.2020

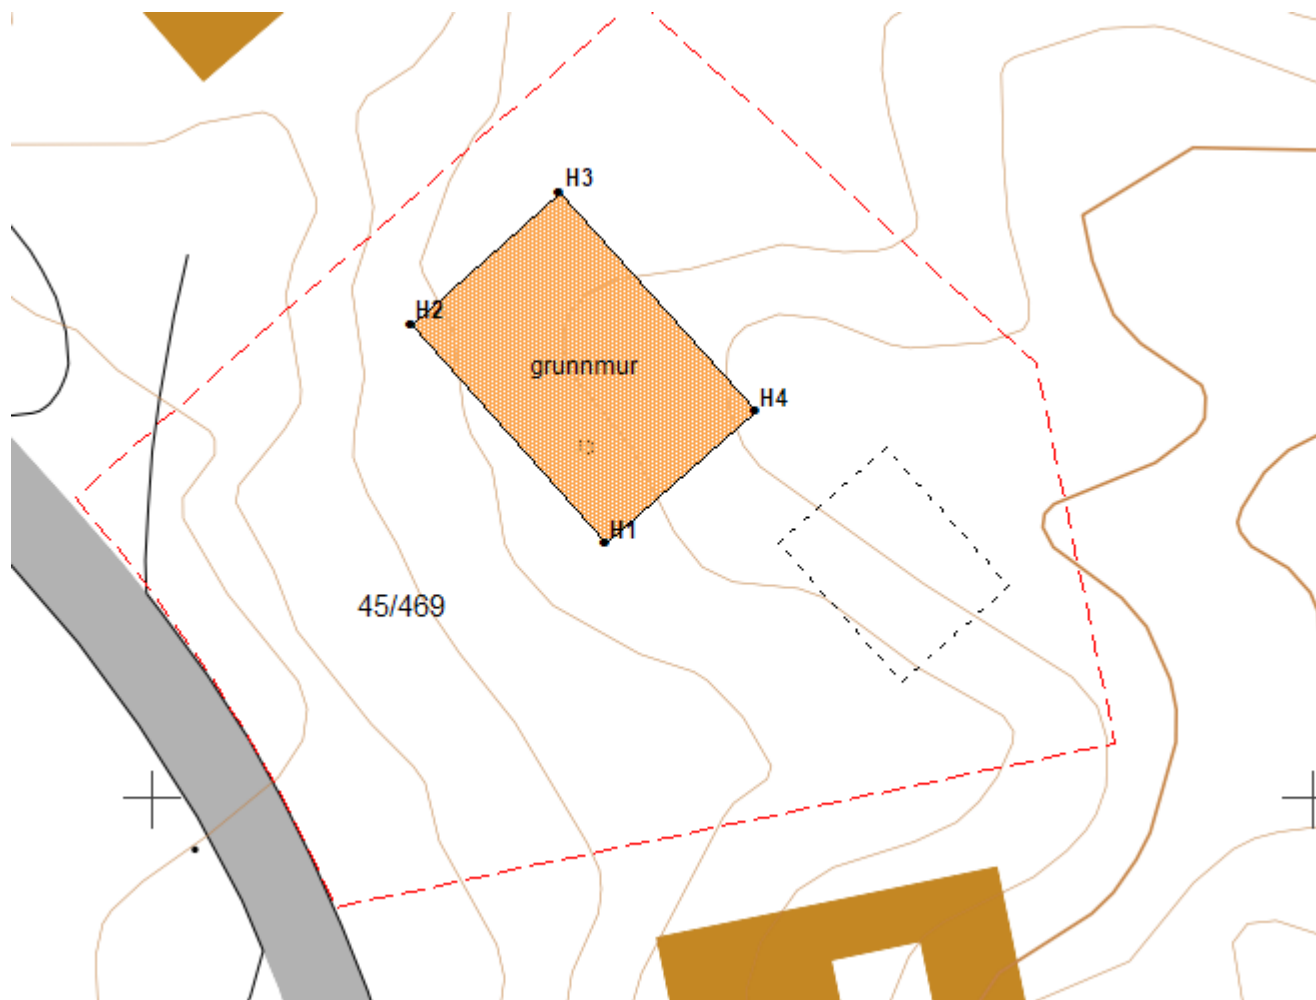

| PunktID | N-koord.   | Ø-koord.  | Høyde |
|---------|------------|-----------|-------|
| H1      | 6729460,96 | 282919,55 | 21,58 |
| H2      | 6729470,43 | 282911,19 | 21,56 |
| H3      | 6729476,14 | 282917,61 | 21,56 |
| H4      | 6729466,64 | 282926,00 | 21,54 |