


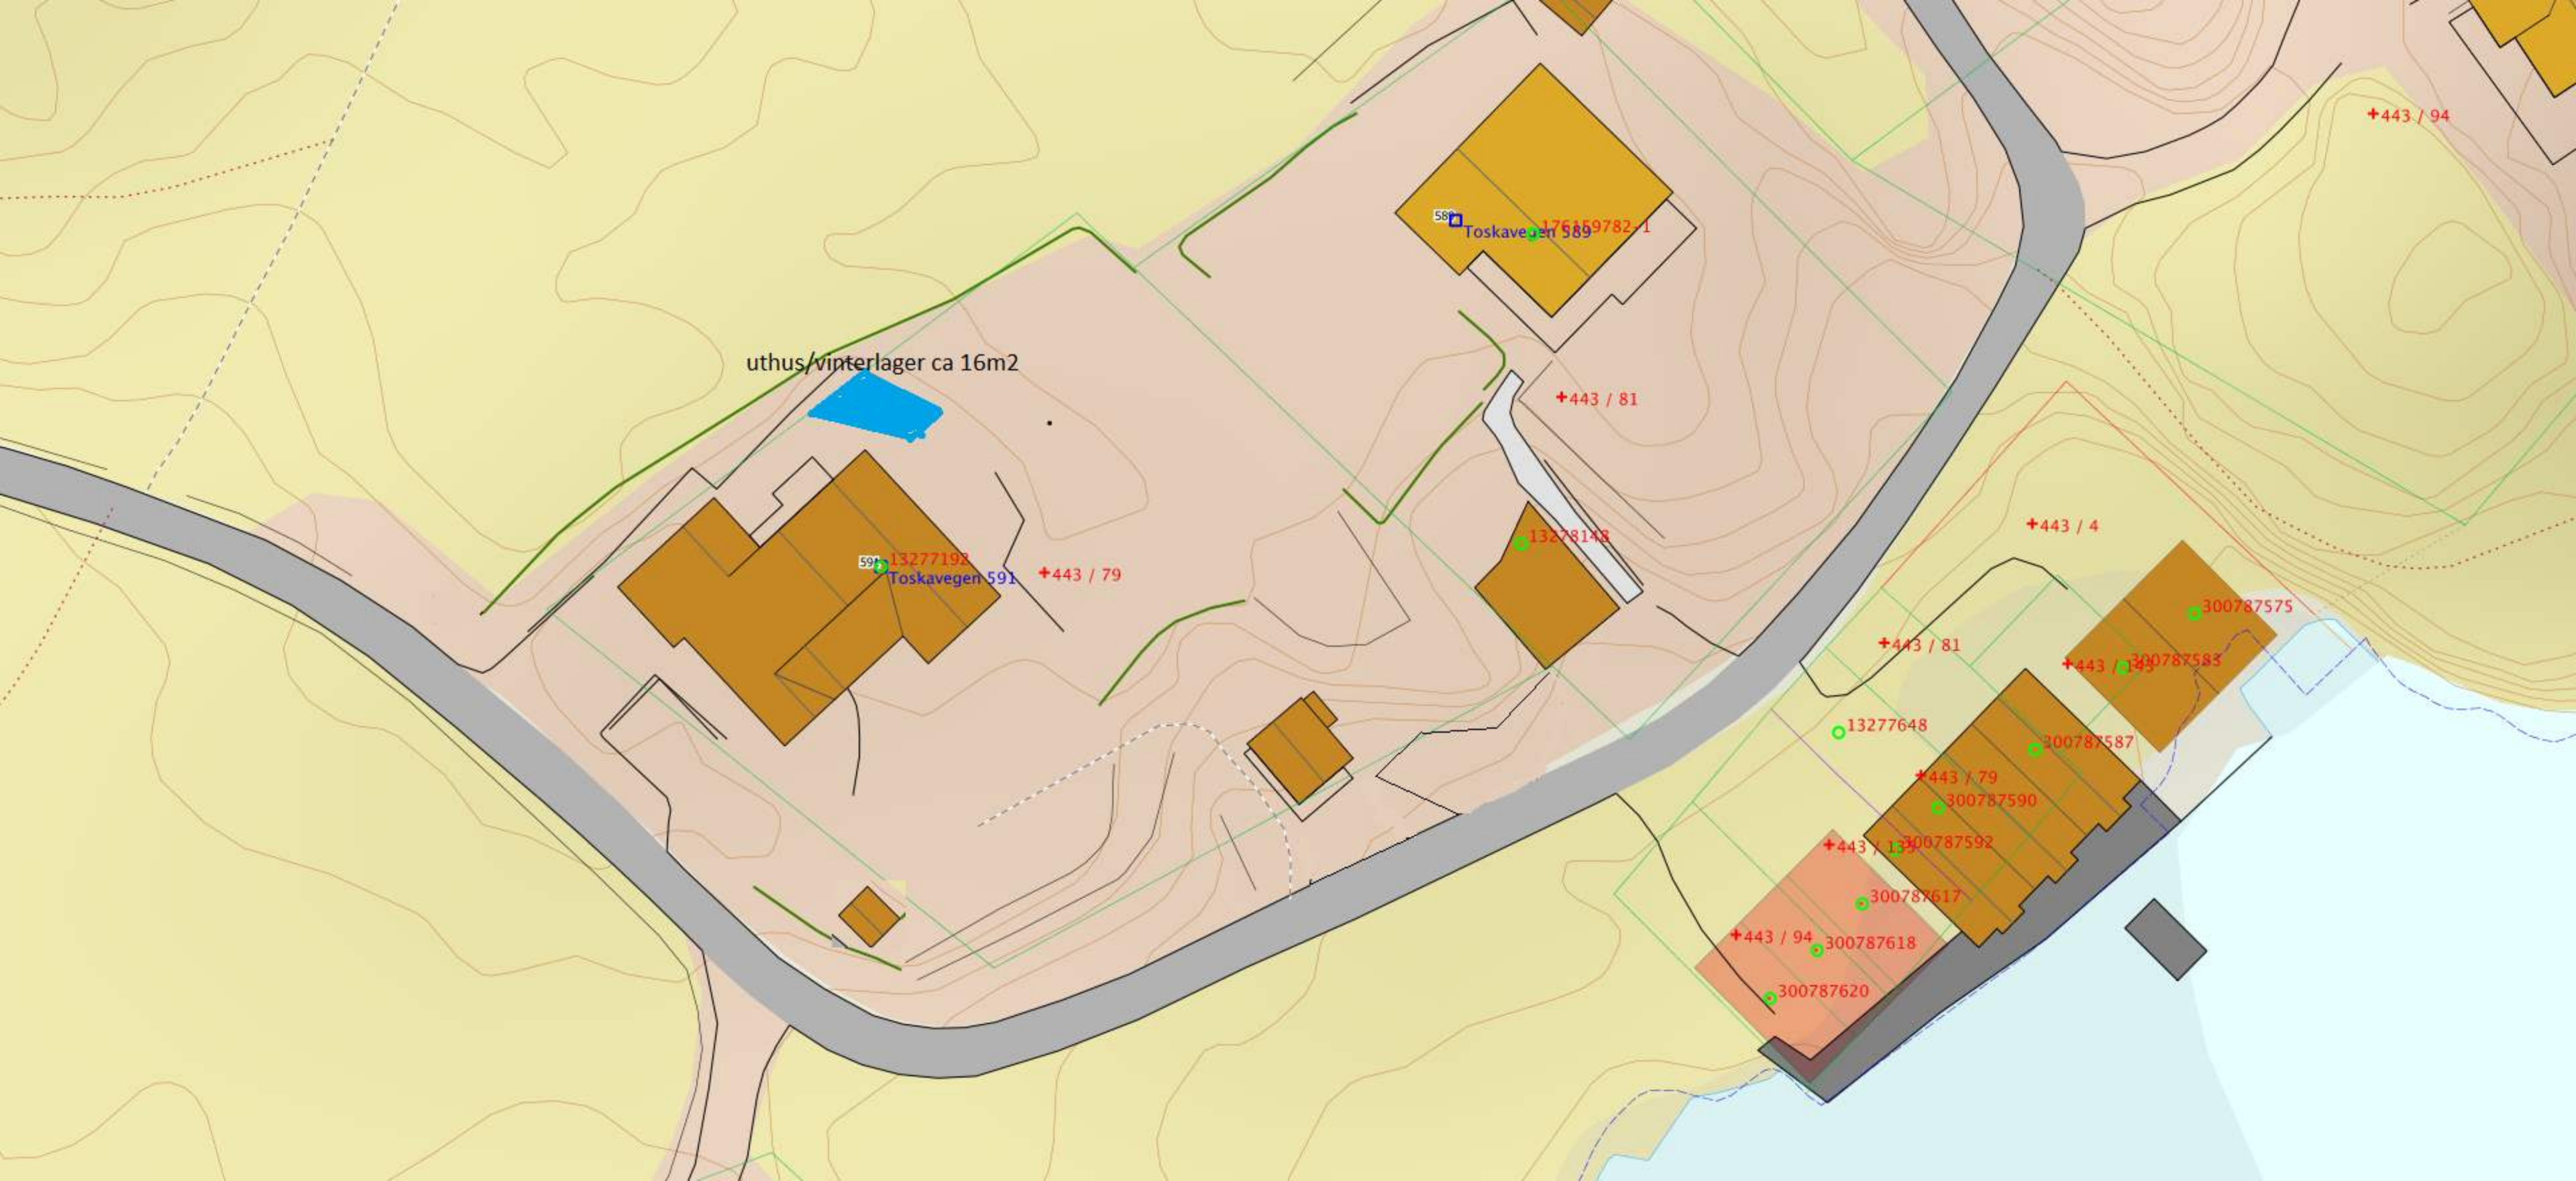

uthus/vinterlager ca 16m2

591 13277192
Toskavegen 591

589 176159782-1
Toskavegen 589

+443 / 79

+443 / 81

13278148

+443 / 4

+443 / 81

+443 / 43

+443 / 79

+443 / 133

+443 / 94

+443 / 94

13277648

300787587

300787590

300787592

300787617

300787618

300787620

300787575

300787583