


29/13
29/1,13,15

Målestokk 1:4600
Dato:28/6/2000

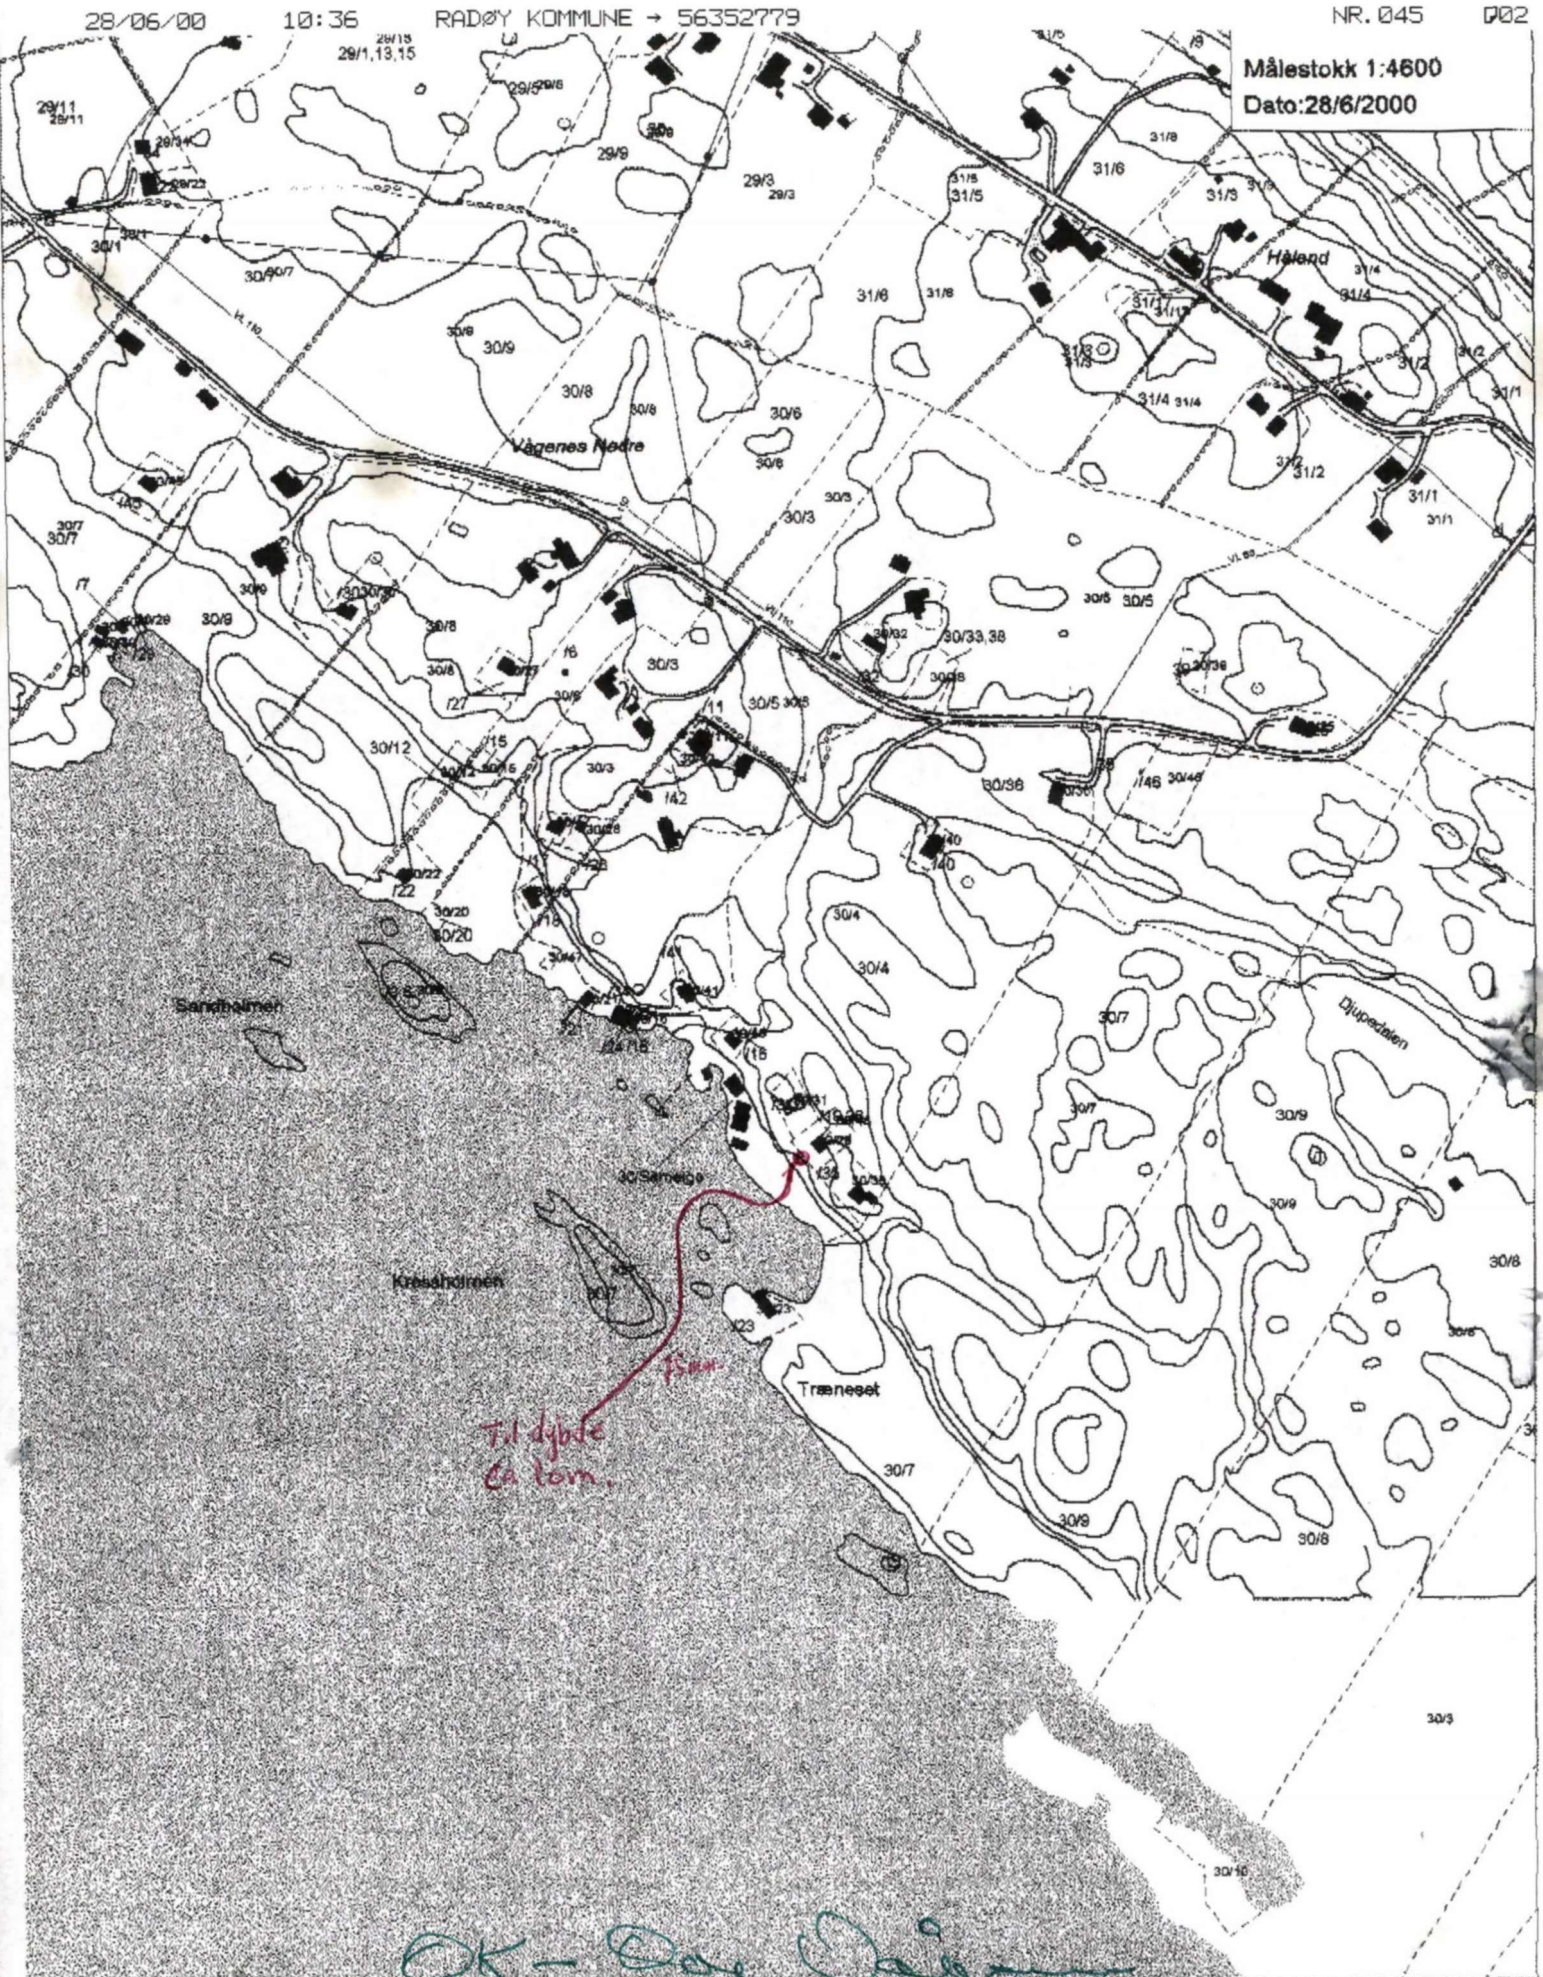

OK - Dac Dagn



Hjelmås VvsBygg

5915 Hjelmås

27/6.00